

KOLB LAND CONSULTING, INC.
LAND SURVEYING • SUBDIVIDING • LAND PLANNING

LAKE GENEVA, WISCONSIN 53147

414-248-3697


NOTE: 100 YEAR FLOOD HAZARD ELEVATION = 865.00'

PLAT OF SURVEY OF

LOT 8 OF LORAMOR SUBDIVISION LOCATED
IN SECTION 11, T1N, R17E, TOWN OF
LINN, WALWORTH COUNTY, WISCONSIN.

ORDERED BY: JERRY NIEDERT
2552 INDIAN RIDGE CT.
GLENVIEW, IL. 60025

NOTE: BEARINGS ARE ASSUMED AS SHOWN ON
PREVIOUS SURVEY RECORDS.

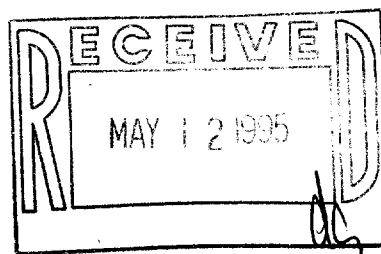


SCALE: 1" = 60'
LEGEND

- ⊘ - IRON PIPE FOUND
- - IRON ROD FOUND
- o - 1" X 24" IRON PIPE SET

I, HAROLD H. KOLB, DO HEREBY CERTIFY
THAT I HAVE SURVEYED THE PROPERTY
HEREON DESCRIBED ACCORDING TO THE
OFFICIAL RECORDS AND THAT THE PLAT
HEREON IS A CORRECT REPRESENTATION
OF THE LOT LINES TO THE BEST OF MY
KNOWLEDGE AND BELIEF.
SURVEY NOT VALID UNLESS SURVEYOR'S SIGNATURE
IS IN RED.

HAROLD H. KOLB
WISCONSIN REGISTERED LAND SURVEYOR, S-187
DATE MAY 26, 1993
REVISED: JUNE 25, 1993---NOV. 3, 1994

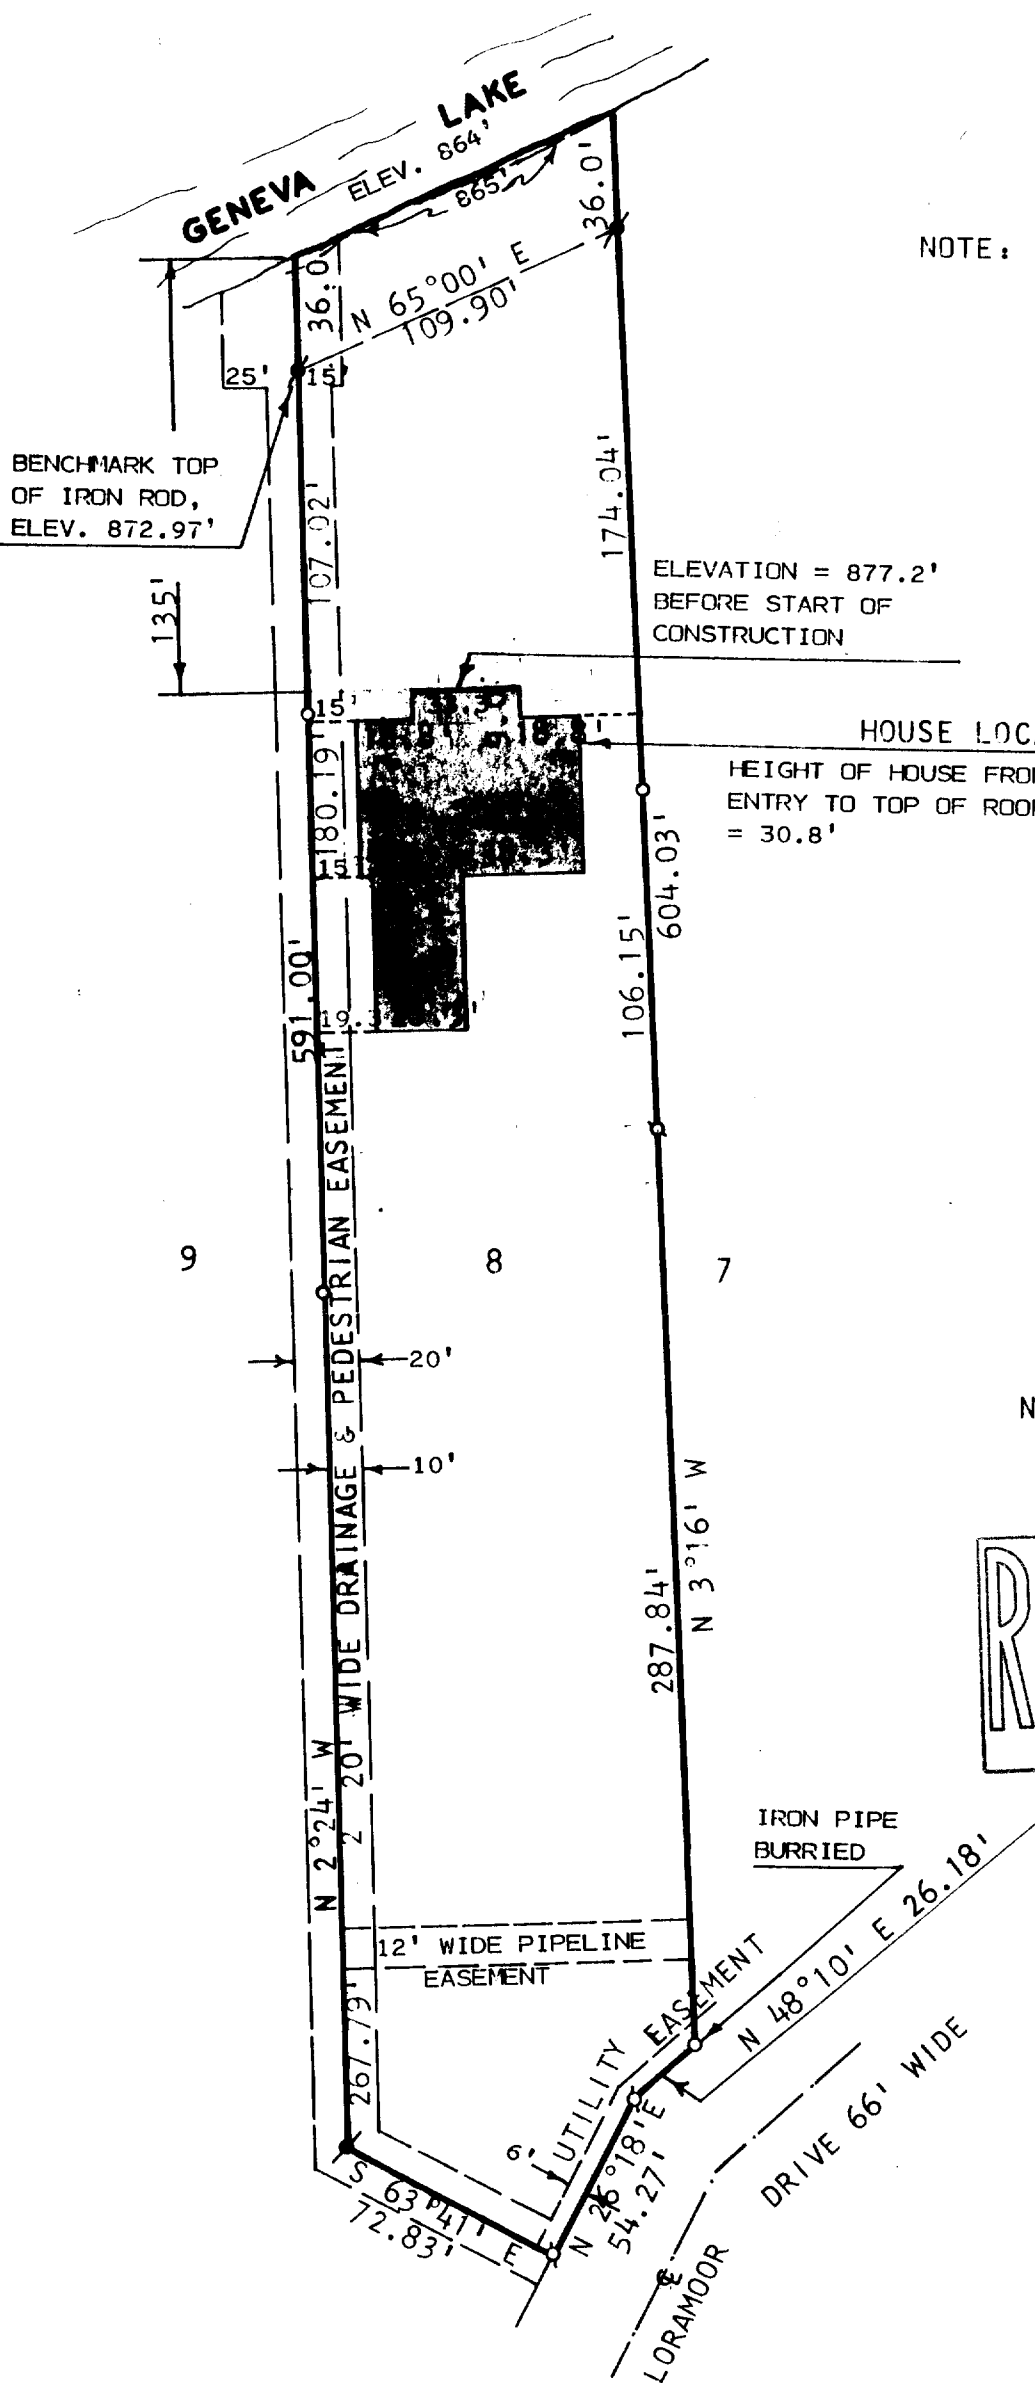

12WL-8