


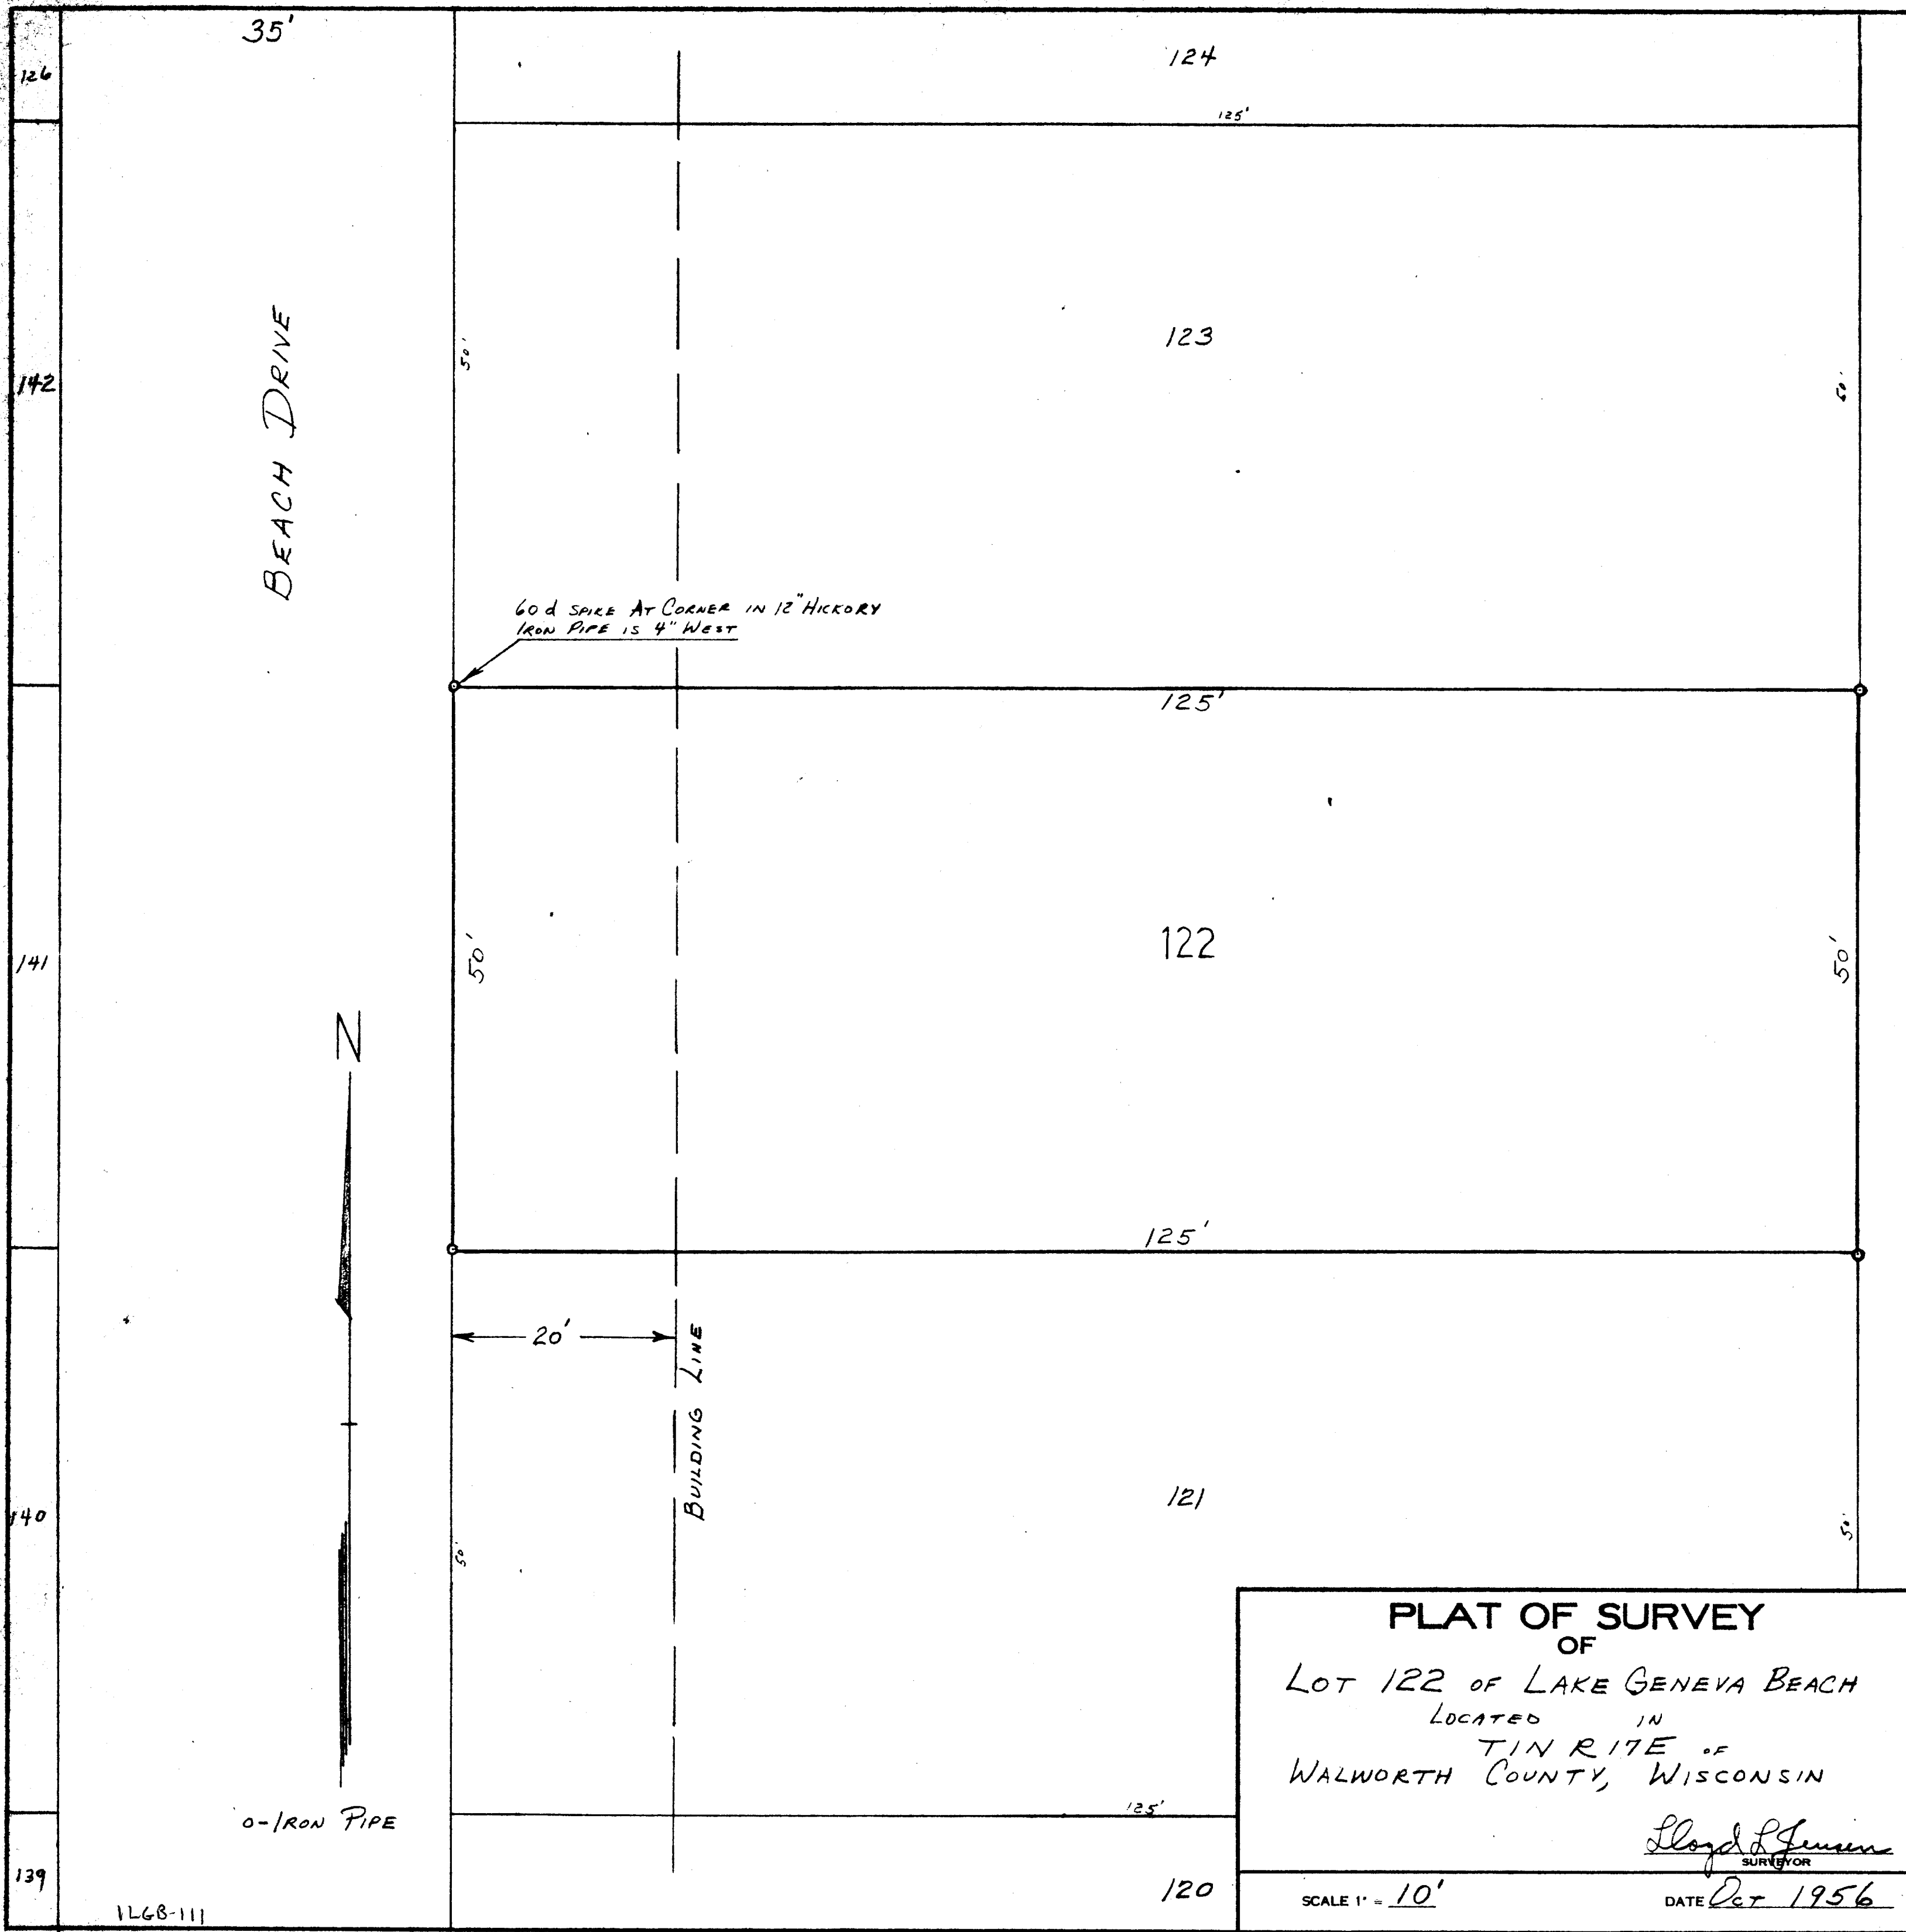

PLAT OF SURVEY
OF

LOT 122 OF LAKE GENEVA BEACH
LOCATED IN
TIN RITE OF
WALWORTH COUNTY, WISCONSIN

Lloyd L. Jensen
SURVEYOR

SCALE 1" = 10'

DATE Oct 1956