

WORK ORDERED BY: JOHN ZILS
2105 COUNTRY KNOLL LANE
ELGIN, IL. 53175


FARRIS, HANSEN & ASSOCIATES, INC.
Engineering, Architecture, Surveying
7 Ridgway Court, P.O. Box 437
ELKHORN, WISCONSIN 53121
Office: (414) 723-2098
Fax: (414) 723-5886

REVISIONS

PROJECT NO.
4466.53
DATE
07/05/96
SHEET NO.
1 OF 1

BOUNDARY & TOPOGRAPHIC SURVEY

LOT 53 SHORE HAVEN
LOCATED IN SEC. 18, TOWN 1 NORTH, RANGE 17 EAST
WALWORTH COUNTY, WISCONSIN

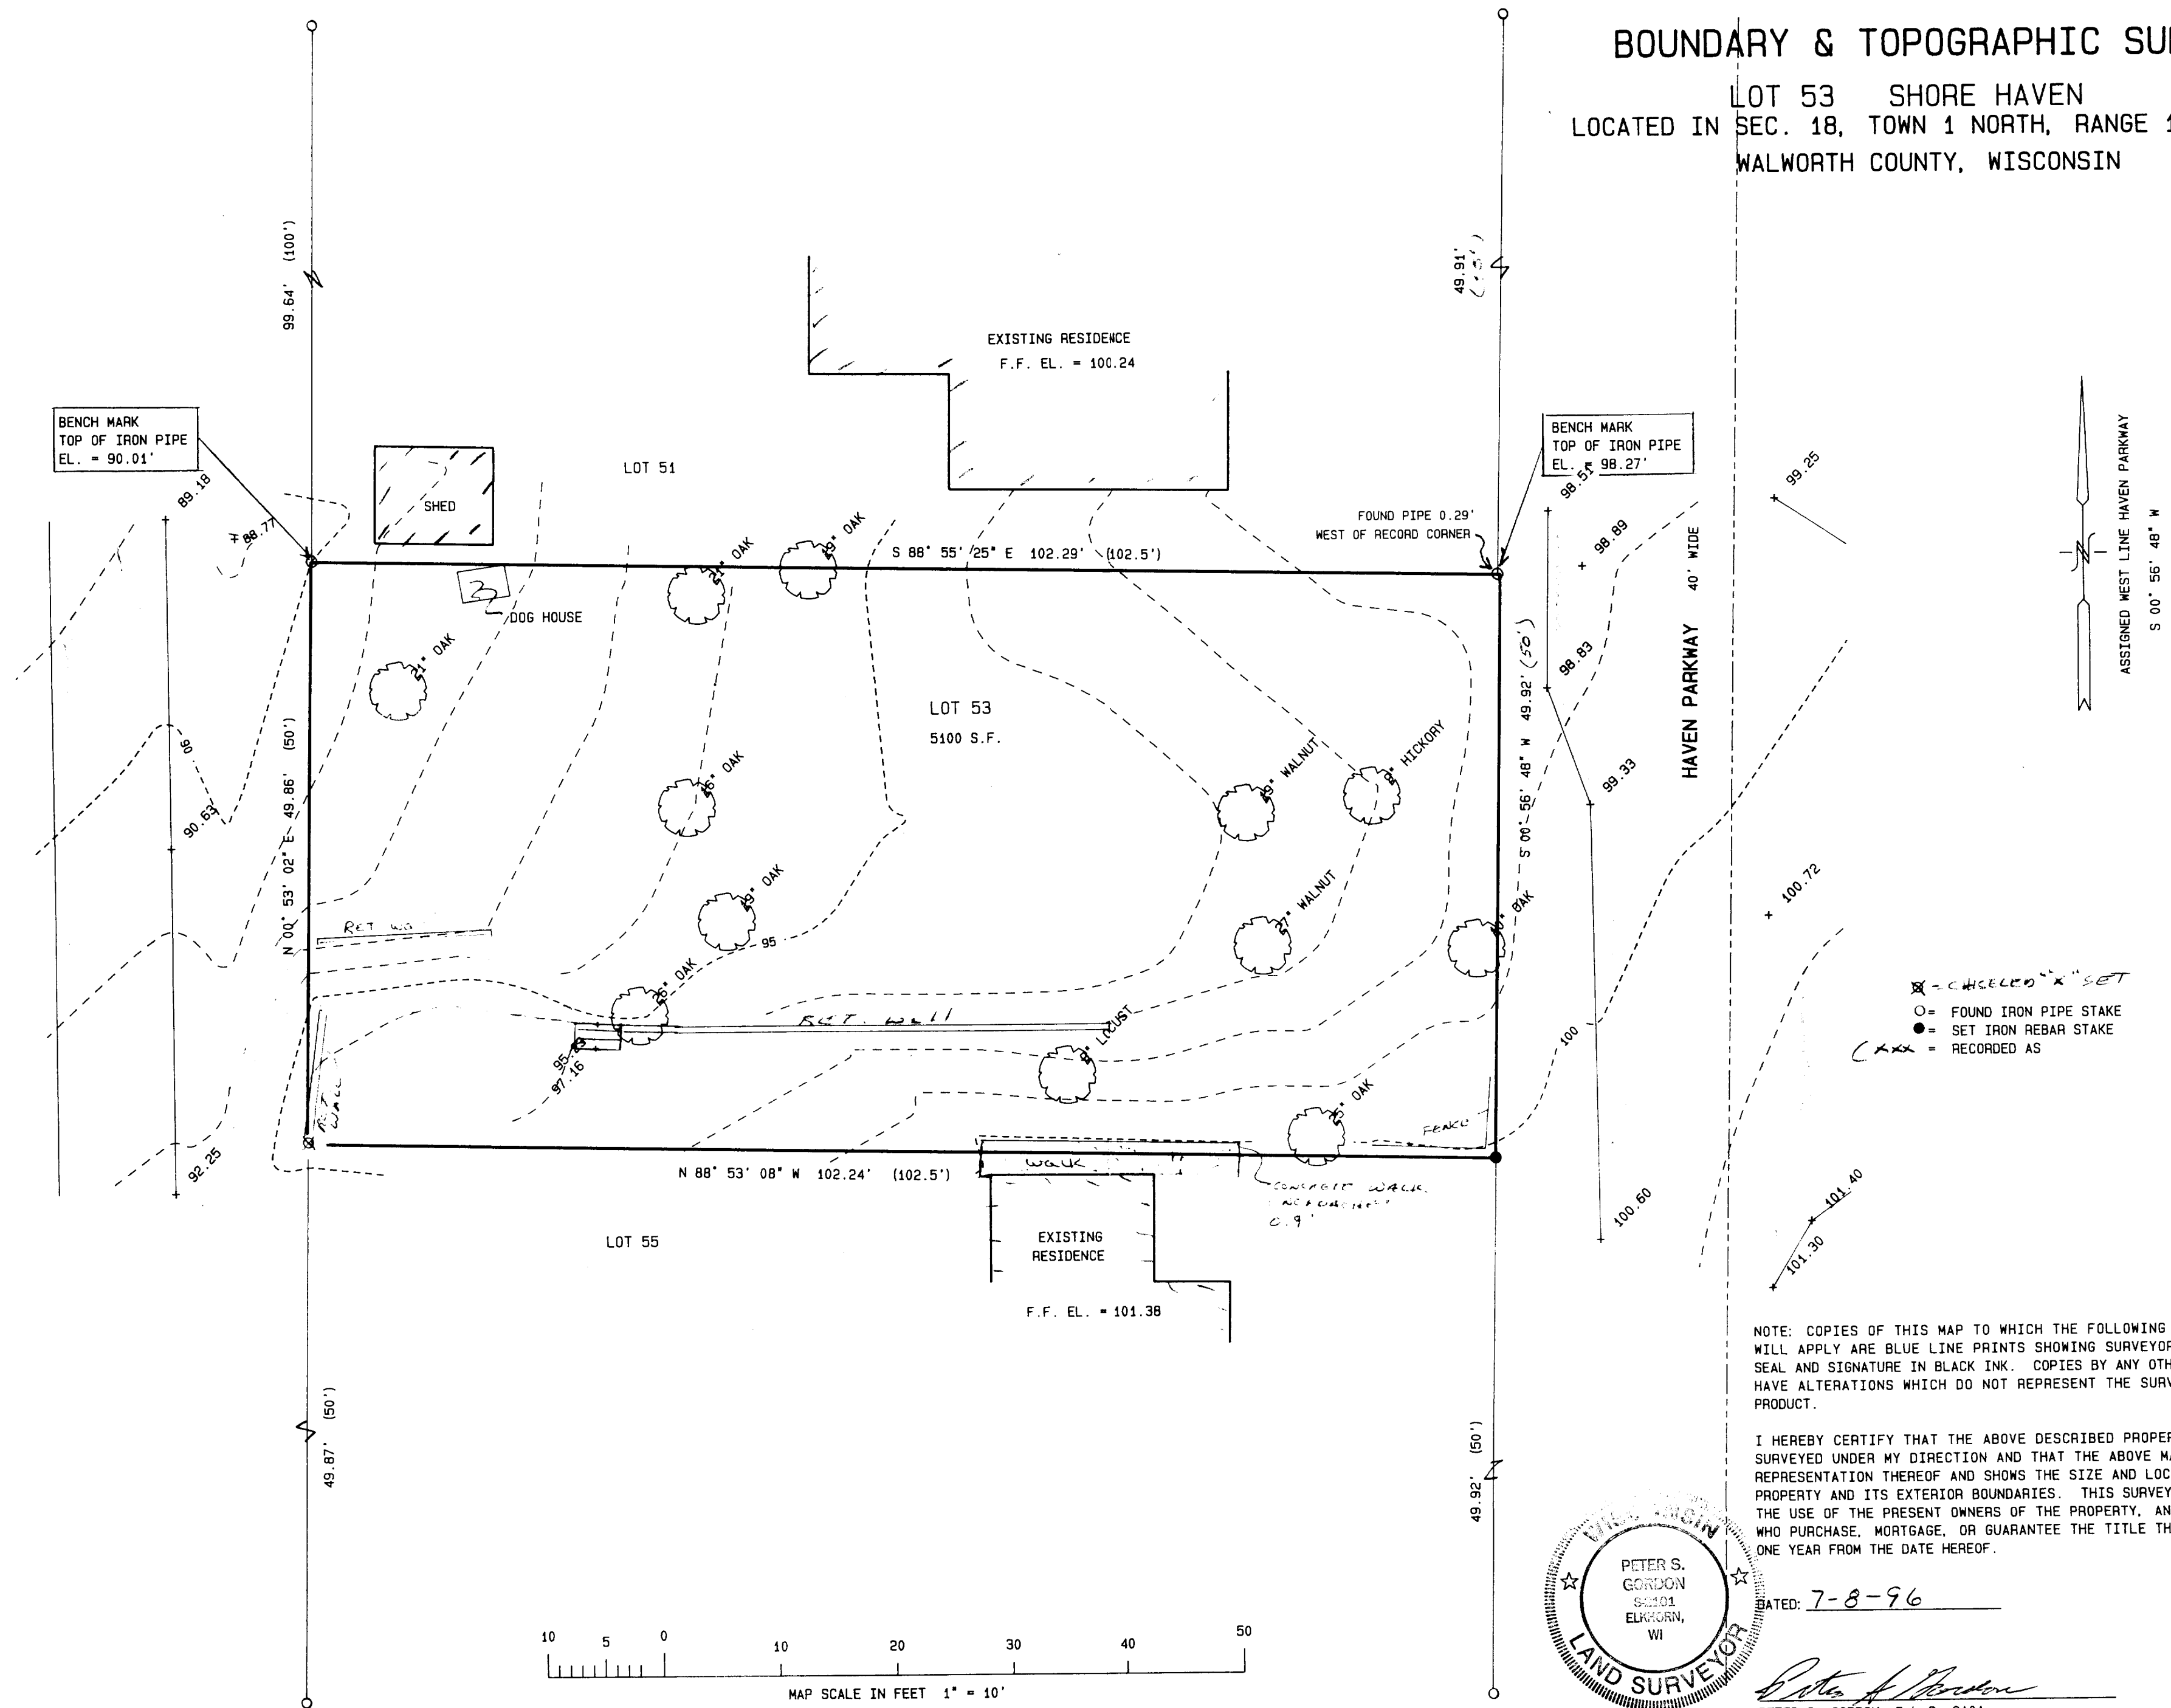

ISA-52
117-1515