


DUNHAM SURVEYING, S.C.
SURVEYING & SUBDIVISIONS
DELAWARE, WISCONSIN 53115

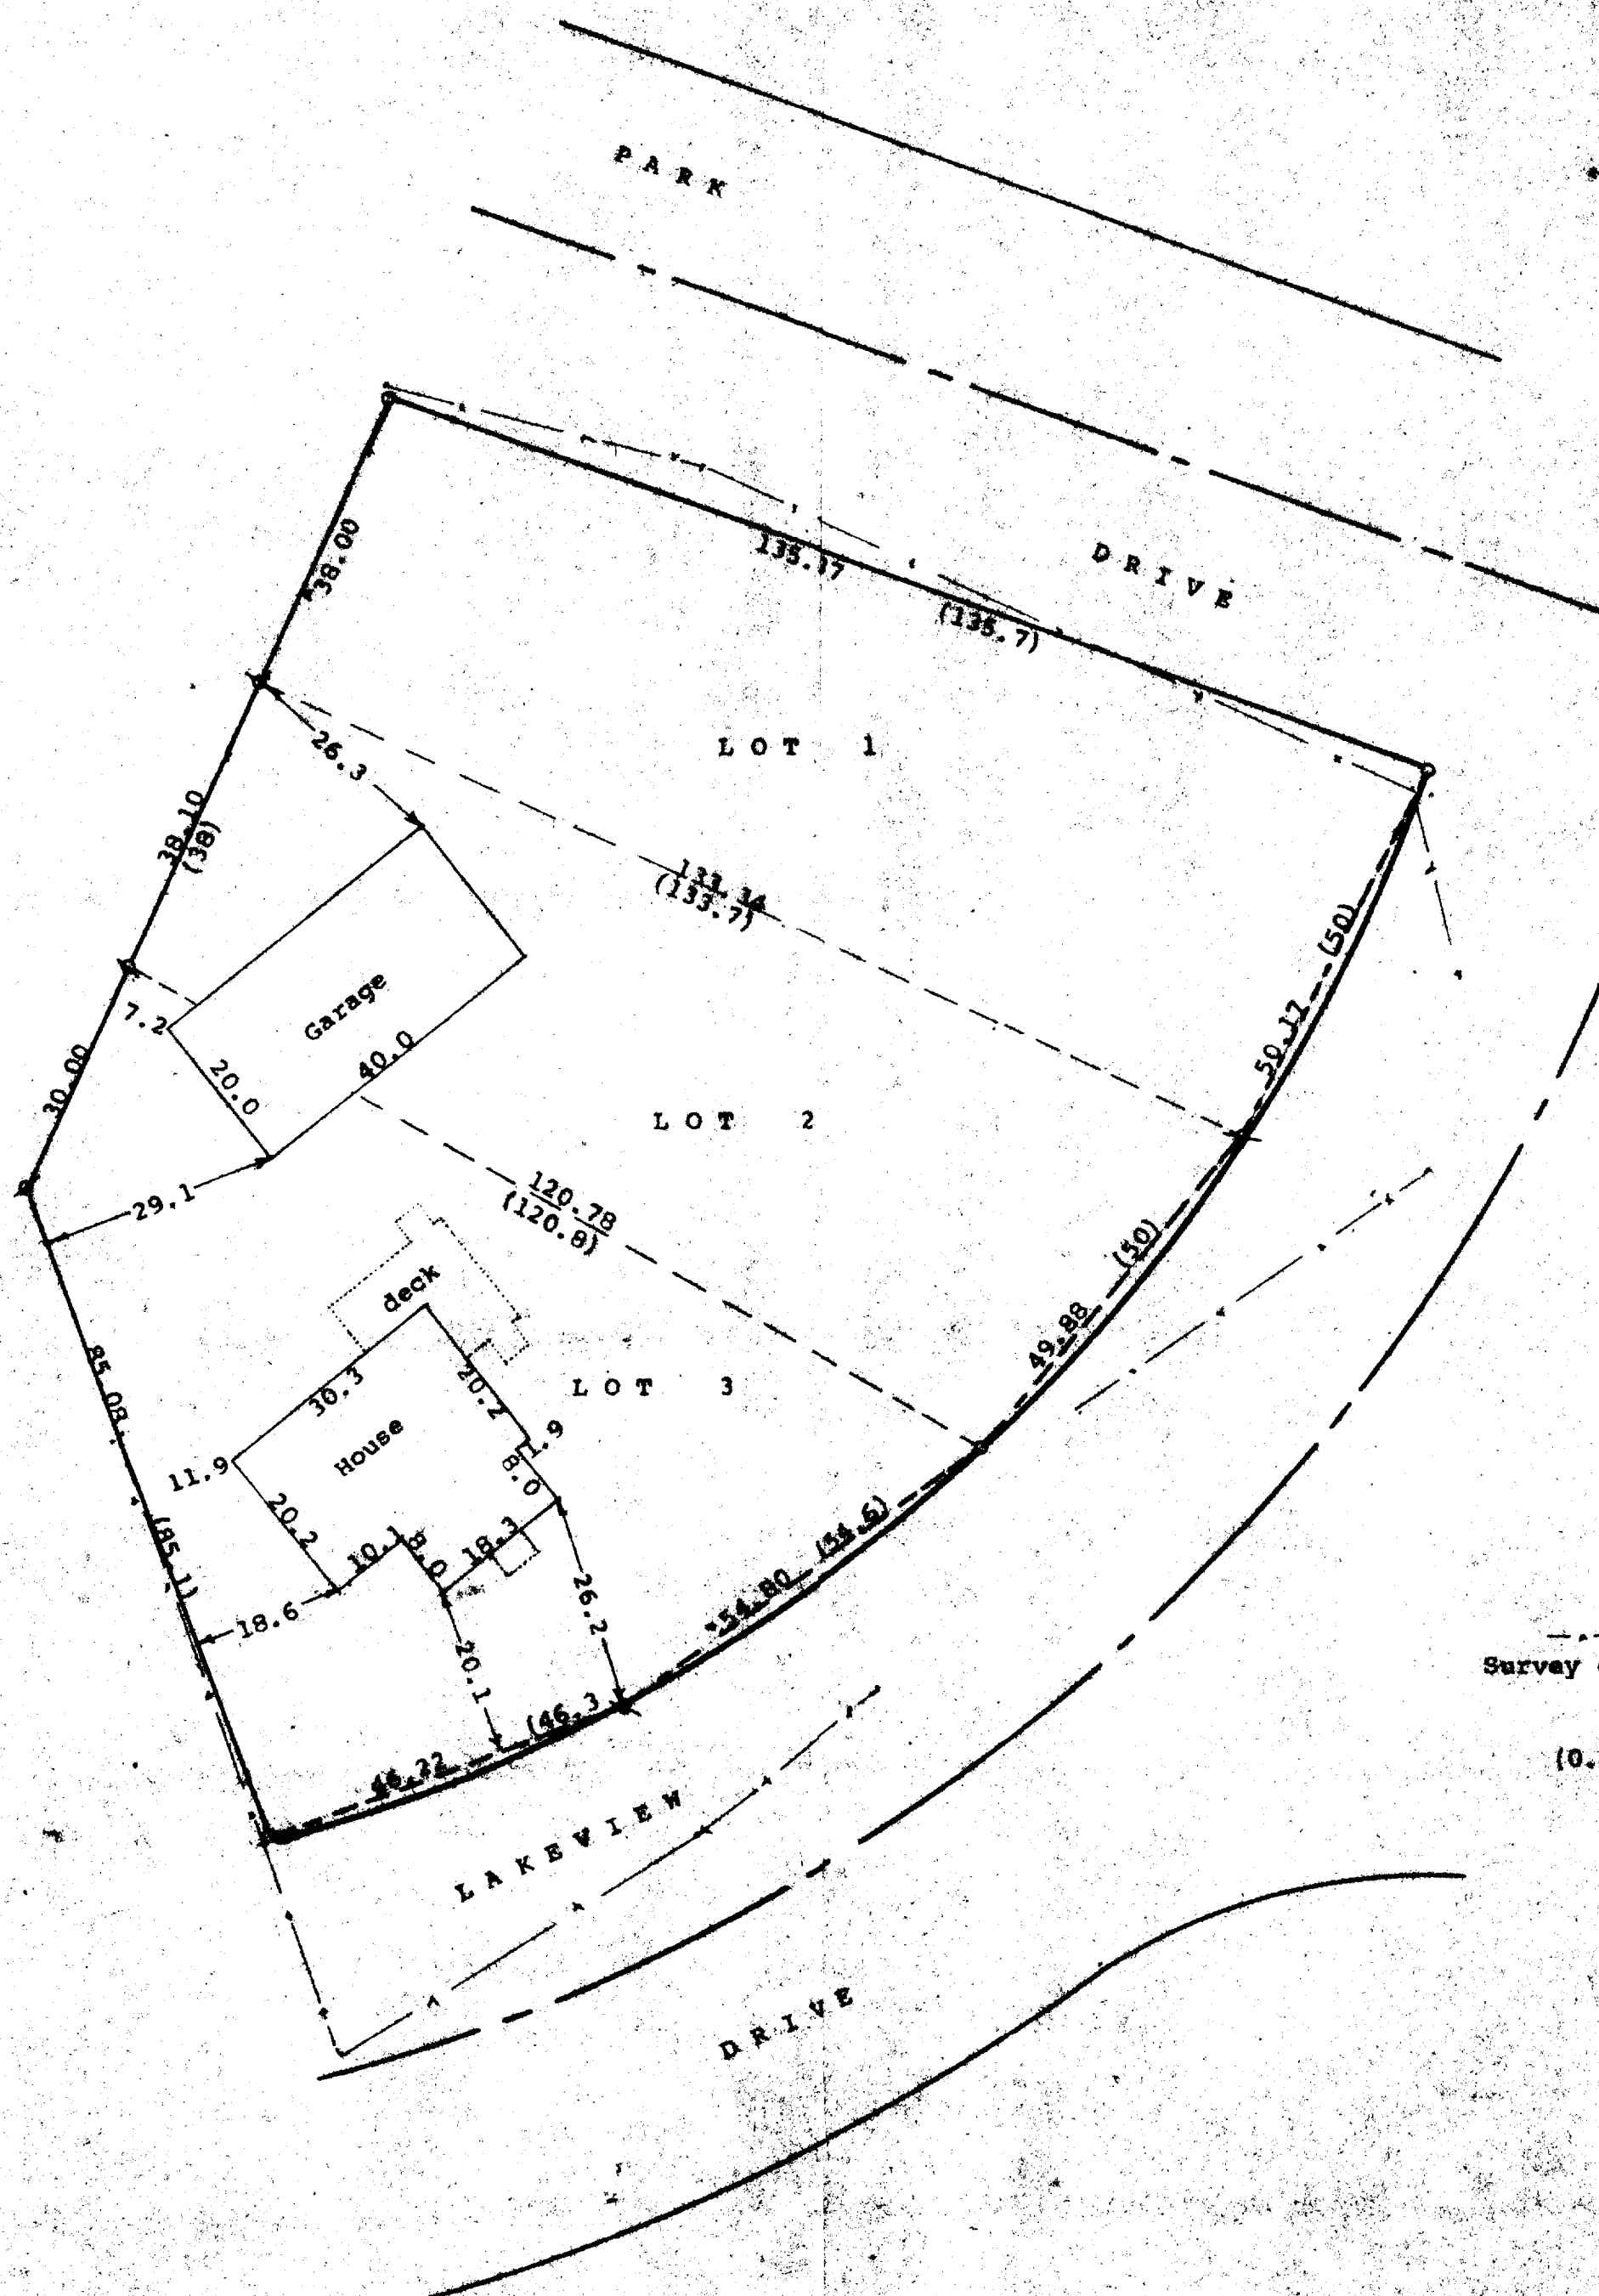

Scale - 1" = 20'
 4" = 4" Iron Pipe Found
 3/4" = 3/4" Iron Pipe Found
 1" = 1" Iron Pipe Found
 --- = Fence Line
 Survey ordered by: Catherine M. Mall
 613 W. Central Rd. A3
 Mt. Prospect, IL 60056
 (0.00) = recorded distance

STATE OF WISCONSIN) ss
 COUNTY OF WALWORTH)

I, George T. Dunham, Surveyor, certify that I have surveyed the property described as follows:

Lots 1, 2, and 3 in Block 4 of Lake View Park, a subdivision located in Section 16, T1N, R17E, Walworth County, Wisconsin and that the plat shown herein is a correct representation thereof and shows the size and location of the property, its exterior boundaries, the location of all visible structures and dimensions of all principal buildings thereon, boundary fences, apparent easements, roadways and visible encroachments, if any, and that I have surveyed the property herein described, according to the official records, to the best of my knowledge and belief.

October 18, 1994
 Plat drawn June, 1995

George T. Dunham, Surveyor

