
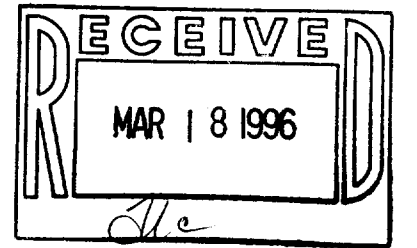


PLAT OF SURVEY

Certified Survey No. 2553, according to the recorded plat thereof, recorded January 18, 1995 in Volume 13 of Certified Surveys on pages 14 & 15, in Walworth County, Wisconsin.

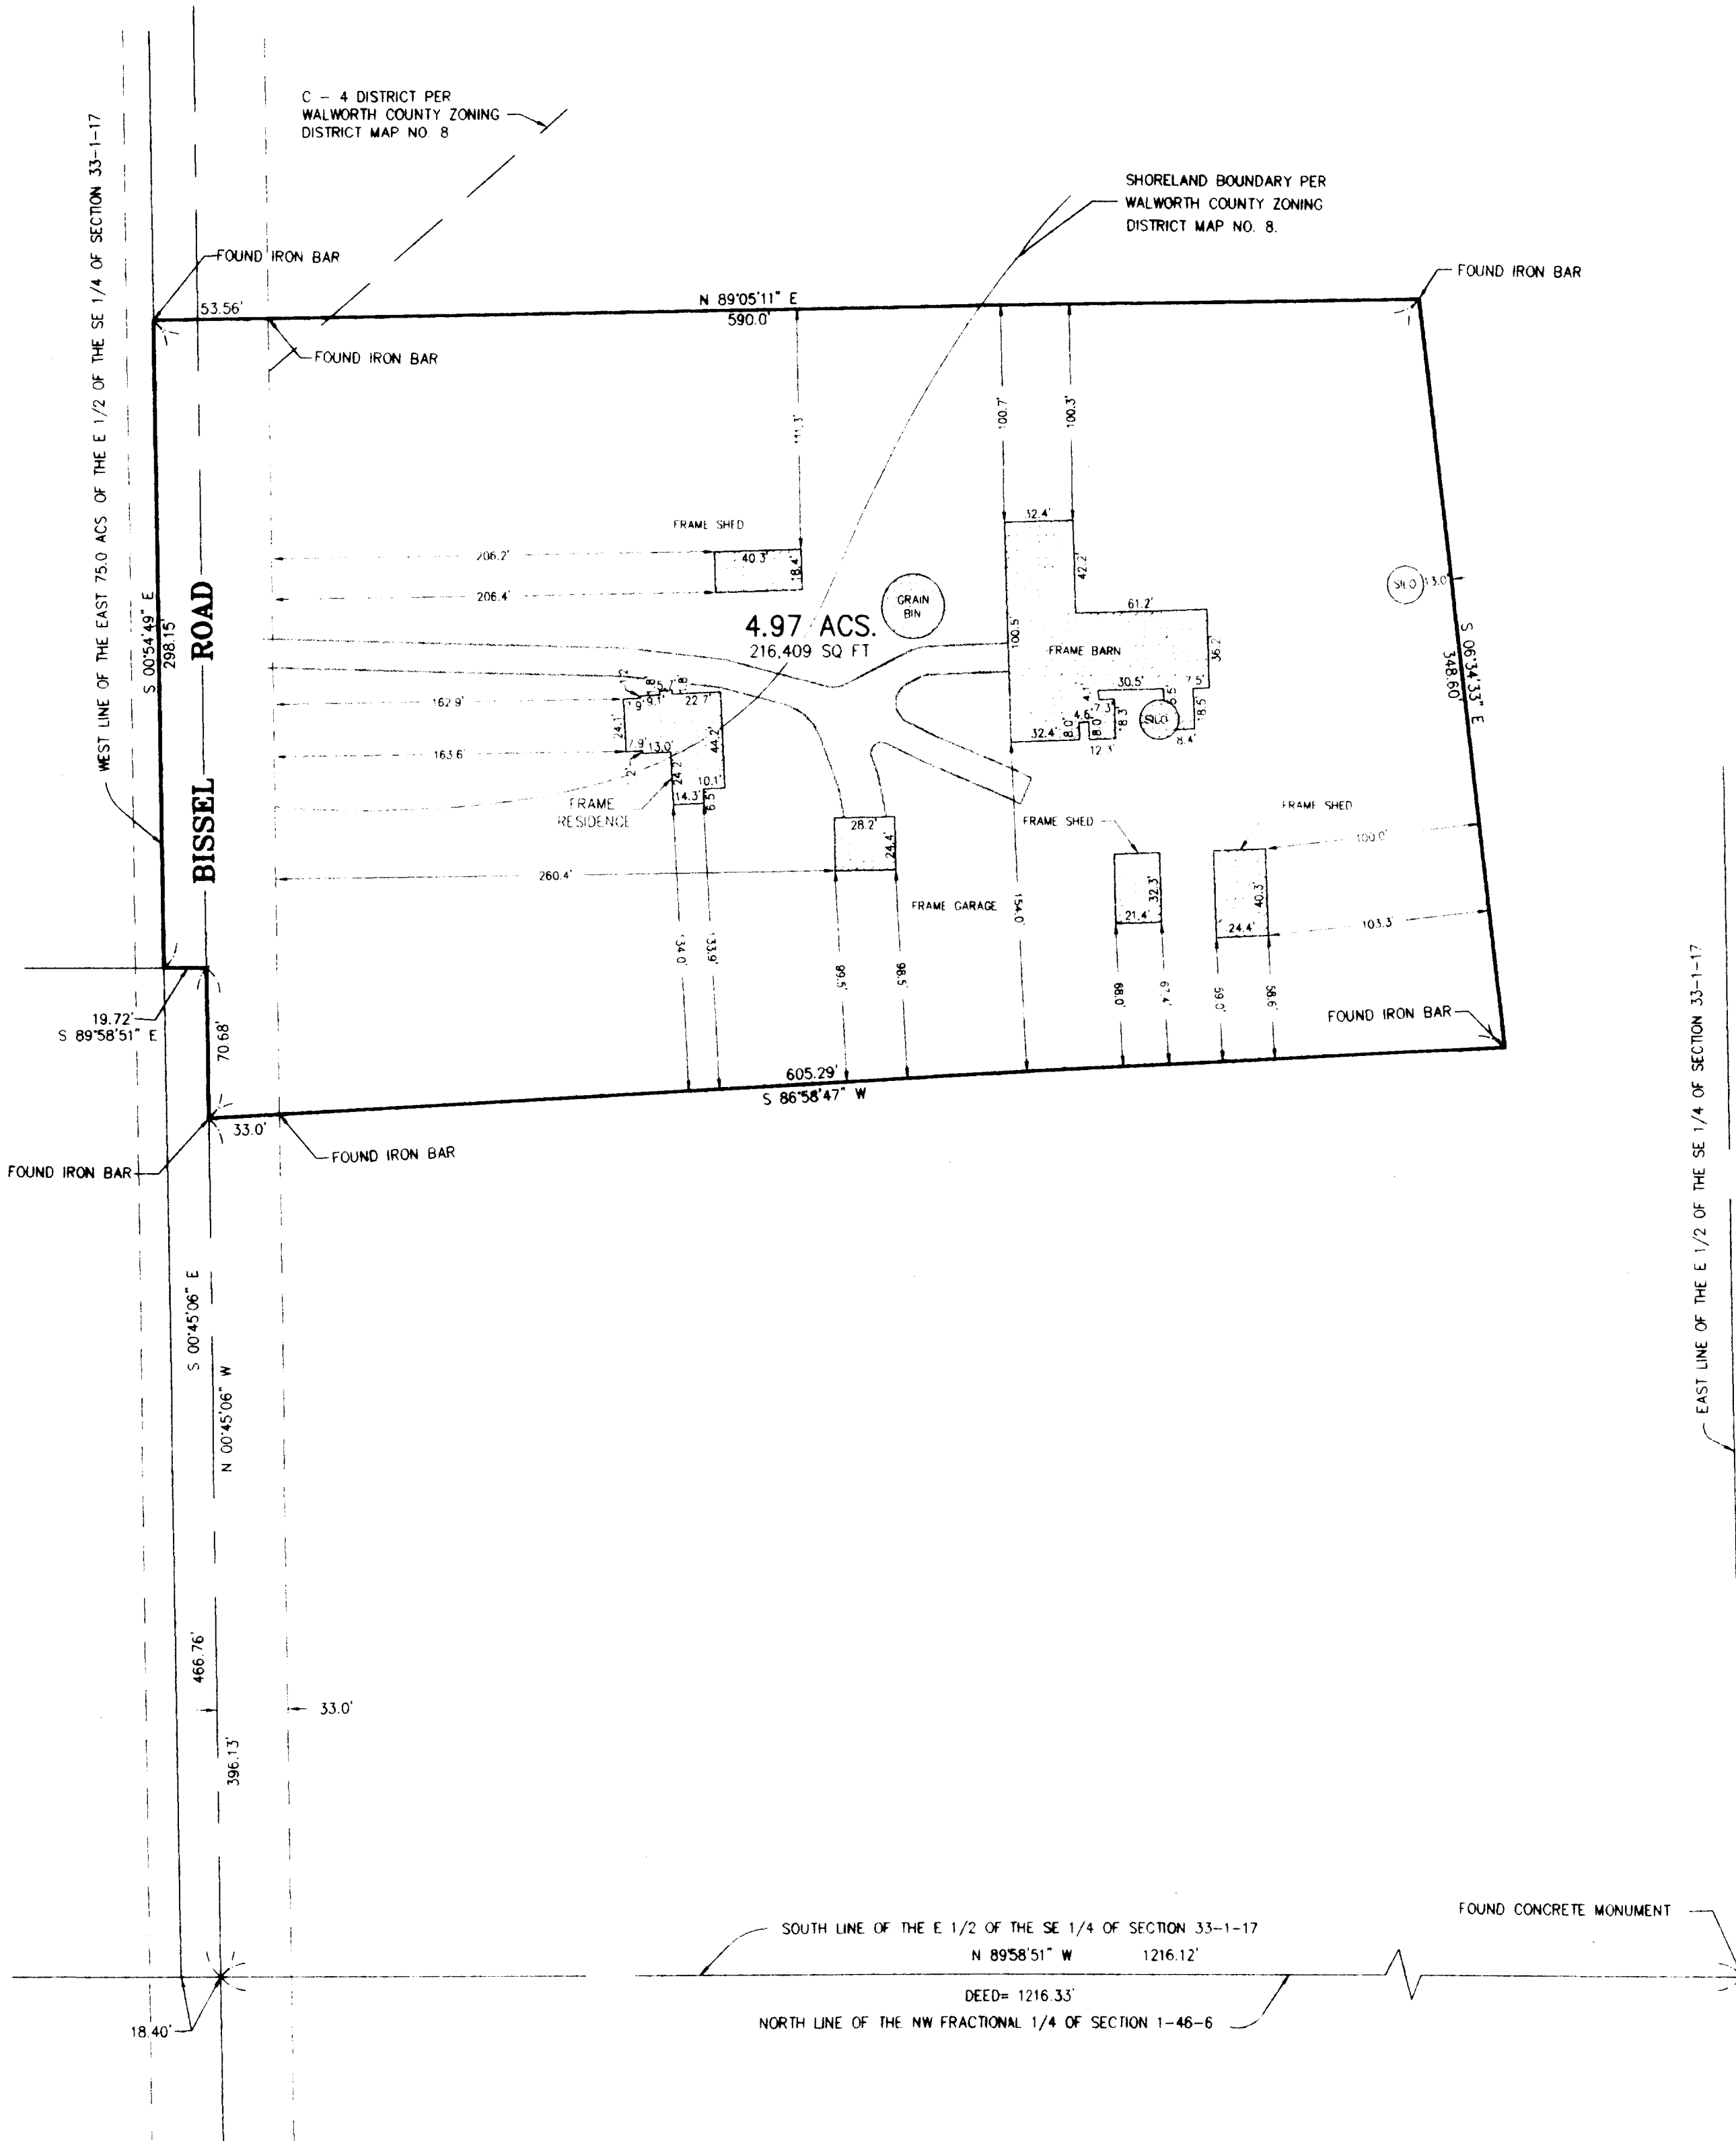

STATE OF ILLINOIS)
COUNTY OF McHENRY) S.S.

I hereby certify that we have surveyed the premises above described, and that the plat hereon is a true representation of the said survey.

Dated at Woodstock, McHenry County Illinois 1/2 A.D. 19 96
VANDERSTAPPEN SURVEYING, INC..

By *Wm. J. Vanderstappen*
Wisconsin Professional Land Surveyor
No. 1777

NOTE: Only those Building Line Restrictions or Easements shown on a Recorded Subdivision Plat are shown hereon unless the description ordered to be surveyed contains a proper description of the required building lines or easements.

Compare your description and site markings with this plat and AT ONCE report any discrepancies which you may find.

CLIENT: ROBERT NICHOLS
DRAWN BY: WJV CHK'D BY:
SCALE: 1"=60' SEC. 33 T. 1 R. 17 E.
JOB NO.: 950599
ALL DISTANCES SHOWN IN FEET AND DECIMAL PARTS THEREOF
CORRECTED TO 68° F
REF 940233F

