


ABELL
SURVEYING & MAPPING
DELAVER, WISCONSIN 53115
414-728-6737

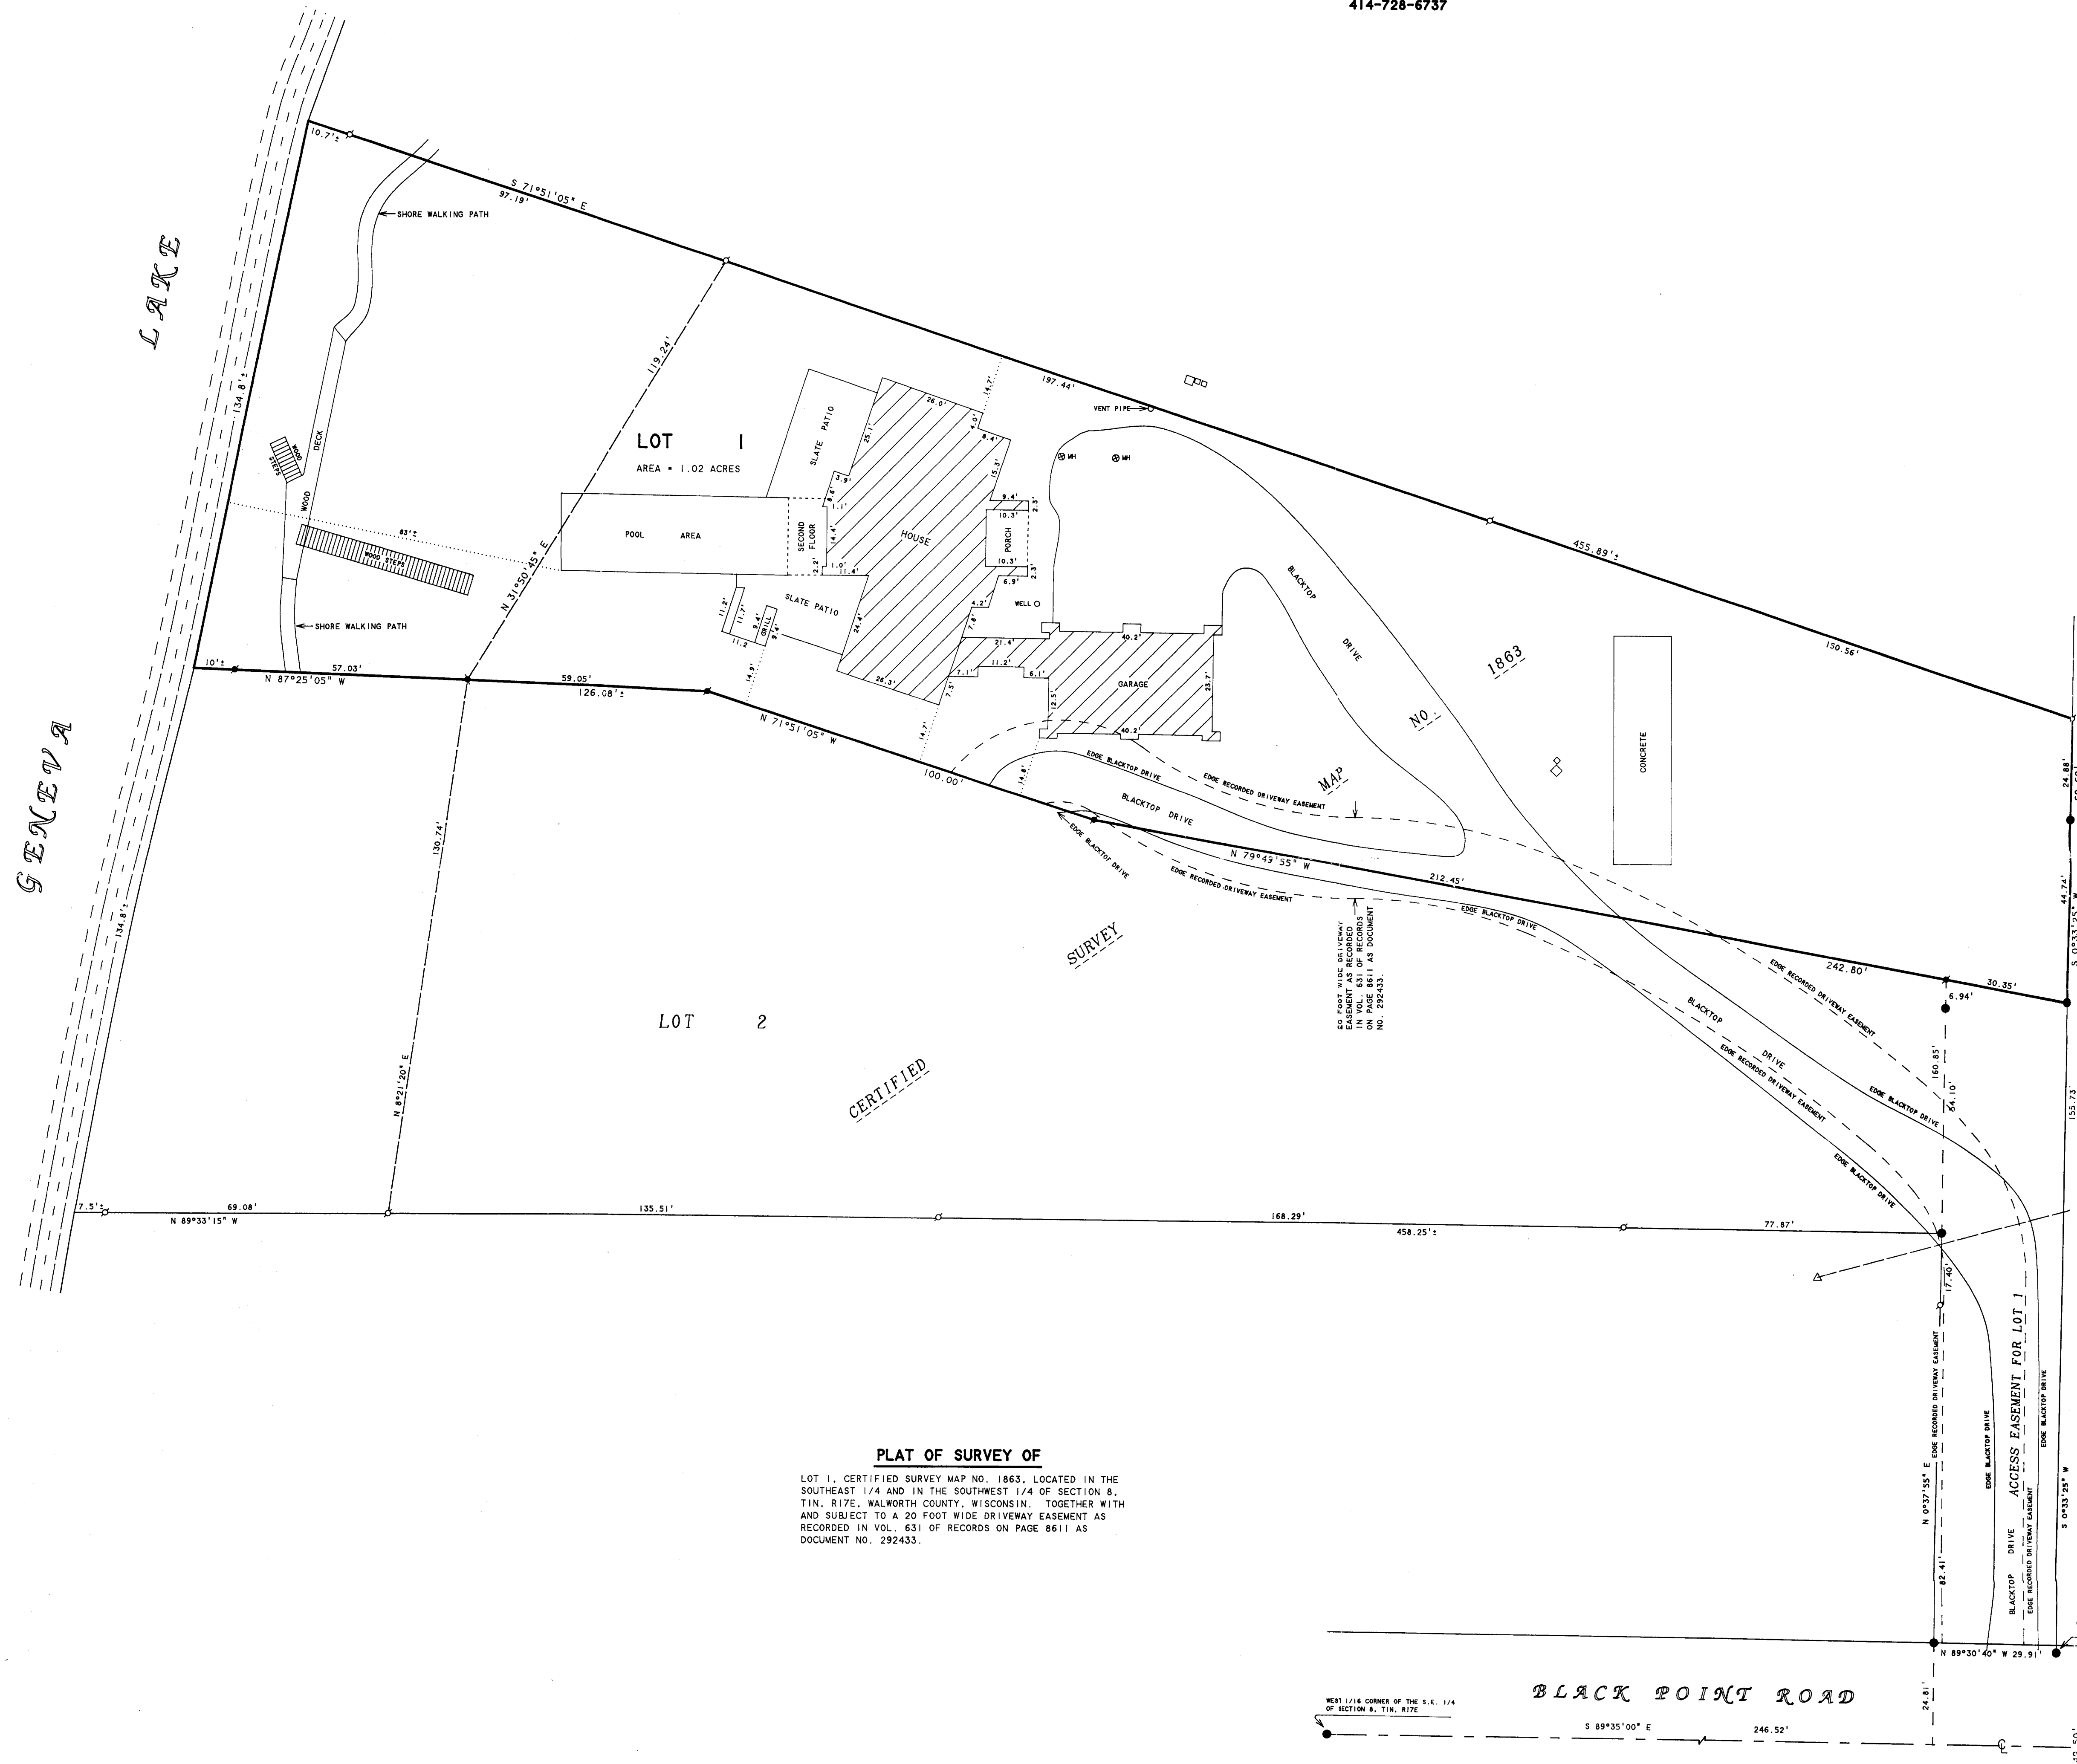

SCALE 1"=20'

LEGEND

- IP - IRON PIPE FOUND
- IR - IRON ROD FOUND
- CM - CONCRETE MONUMENT FOUND
- UP - UTILITY POLE
- OL - OVERHEAD UTILITY LINES
- UD - UTILITY DITCH
- MC - MANHOLE COVER

NOTE 1: BEARINGS ARE REFERENCED TO CERTIFIED SURVEY MAP NO. 1863.

NOTE 2: INFORMATION FOR LOCATION OF 20 FOOT WIDE DRIVEWAY EASEMENT WAS PROVIDED BY: MOHR ASSOCIATES INC 1571 ORCHARD LANE LAKE GENEVA, WI 53147


REVISED: MARCH 29, 1996 TO SHOW HOUSE, DRIVEWAY AND OTHER IMPROVEMENTS.

ORDERED BY: ARNSTEIN & LEHR 120 S. RIVERSIDE PLAZA SUITE 1200 CHICAGO, IL 60606-3913

PLAT OF SURVEY OF

LOT 1, CERTIFIED SURVEY MAP NO. 1863, LOCATED IN THE SOUTHEAST 1/4 AND IN THE SOUTHWEST 1/4 OF SECTION 8, T1N, R17E, WALWORTH COUNTY, WISCONSIN. TOGETHER WITH AND SUBJECT TO A 20 FOOT WIDE DRIVEWAY EASEMENT AS RECORDED IN VOL. 631 OF RECORDS ON PAGE 8611 AS DOCUMENT NO. 292433.

BLACK POINT ROAD

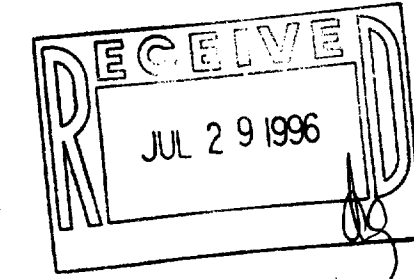

I HEREBY CERTIFY THAT I HAVE SURVEYED THE ABOVE DESCRIBED PROPERTY AND THAT THE ABOVE MAP IS A TRUE REPRESENTATION THEREOF AND SHOWS THE SIZE AND LOCATION OF THE PROPERTY, ITS EXTERIOR BOUNDARIES, THE LOCATION OF ALL VISIBLE STRUCTURES AND DIMENSIONS OF ALL PRINCIPAL BUILDINGS THEREON, BOUNDARY FENCES, APPARENT EASEMENTS, ROADWAYS AND VISIBLE ENCROACHMENTS, IF ANY, TO THE BEST OF MY KNOWLEDGE AND BELIEF.

THIS SURVEY IS MADE FOR THE USE OF THE PRESENT OWNERS OF THE PROPERTY, AND ALSO THOSE WHO PURCHASE, MORTGAGE, OR GUARANTEE THE TITLE THERETO WITHIN ONE (1) YEAR FROM DATE HEREON.

DAVID F. ABELL
WISCONSIN REGISTERED LAND SURVEYOR, S-1996

AUGUST 10, 1994
DATE

REVISED DATE MARCH 29, 1996
REVISED DATE AUGUST 23, 1994

JOB NUMBER - 89153

NOTE: THIS IS NOT A CERTIFIED COPY UNLESS SEALED.

IA-1863-1
117-1521