

SOUTH LAKESHORE DRIVE

PLAT OF SURVEY

LOT 15 OF ACADEMY ESTATES
SEC. 18, T1N, R17E
TOWN OF LINN
WALWORTH COUNTY, WISCONSIN

S 88° 57' 05" E 169.68'
(S 88° 55' 54" E 170.00')

LOT 15

LOT 14

LEGEND
O = FOUND IRON PIPE STAKE
E = FOUND CONCRETE MONUMENT
(---) = RECORDED AS

ACADEMY ROAD

N 00° 03' 09" W 236.69' (236.56')

WELL


DECK PORCH DECK

RESIDENCE

OAK TREES

CLEAN OUT

S 00° 08' 43" E 236.57'
(S 00° 03' 09" E 236.68')

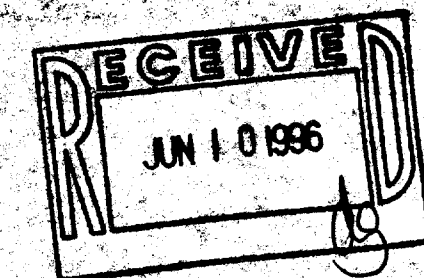


NOTE: COPIES OF THIS MAP TO WHICH THE FOLLOWING CERTIFICATE WILL APPLY ARE BLUE LINE PRINTS SHOWING SURVEYOR'S ORIGINAL SEAL AND SIGNATURE IN BLACK INK. COPIES BY ANY OTHER MEANS MAY HAVE ALTERATIONS WHICH DO NOT REPRESENT THE SURVEYOR'S WORK PRODUCT.

I HEREBY CERTIFY THAT THE ABOVE DESCRIBED PROPERTY HAS BEEN SURVEYED UNDER MY DIRECTION AND THAT THE ABOVE MAP IS A TRUE REPRESENTATION THEREOF AND SHOWS THE SIZE AND LOCATION OF THE PROPERTY AND ITS EXTERIOR BOUNDARIES. THIS SURVEY IS MADE FOR THE USE OF THE PRESENT OWNERS OF THE PROPERTY, AND ALSO THOSE WHO PURCHASE, MORTGAGE, OR GUARANTEE THE TITLE THERETO WITHIN ONE YEAR FROM THE DATE HEREOF.

DATED: 07/27/99

Peter S. Gordon

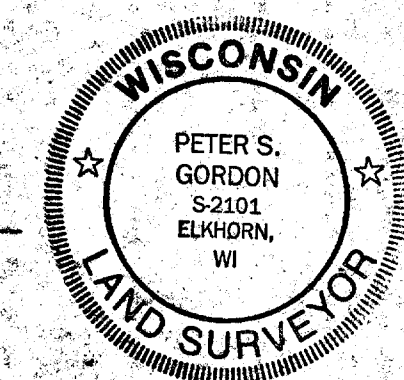

MAP SCALE IN FEET
GENERAL 1" = 20'

WORK ORDERED BY:
DEBBIE FISHER
FISHER FINE HOMES
OWNER: TERRY & DEBBIE DANIELS

FARRIS, WARREN & ASSOCIATES, INC.
Engineering, Architecture, Surveying
7 Ridgeway Court, P.O. Box 437
Elkhorn, Wisconsin 53121
Office: (414) 723-2036
Fax: (414) 723-2036

REVISIONS

PROJECT NO.
4059
DATE
6/27/99
SHEET NO.
1 OF 1