
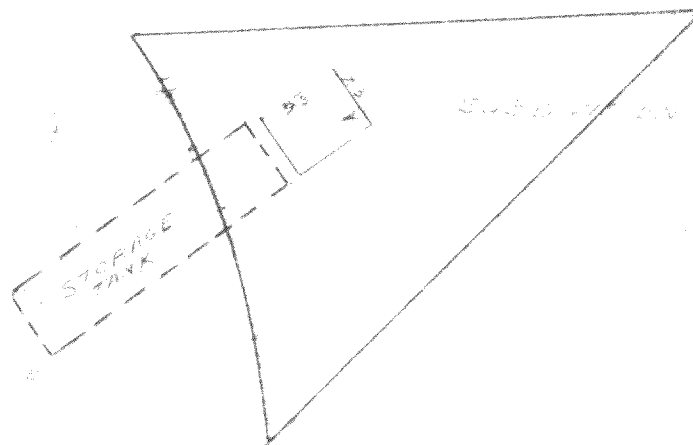


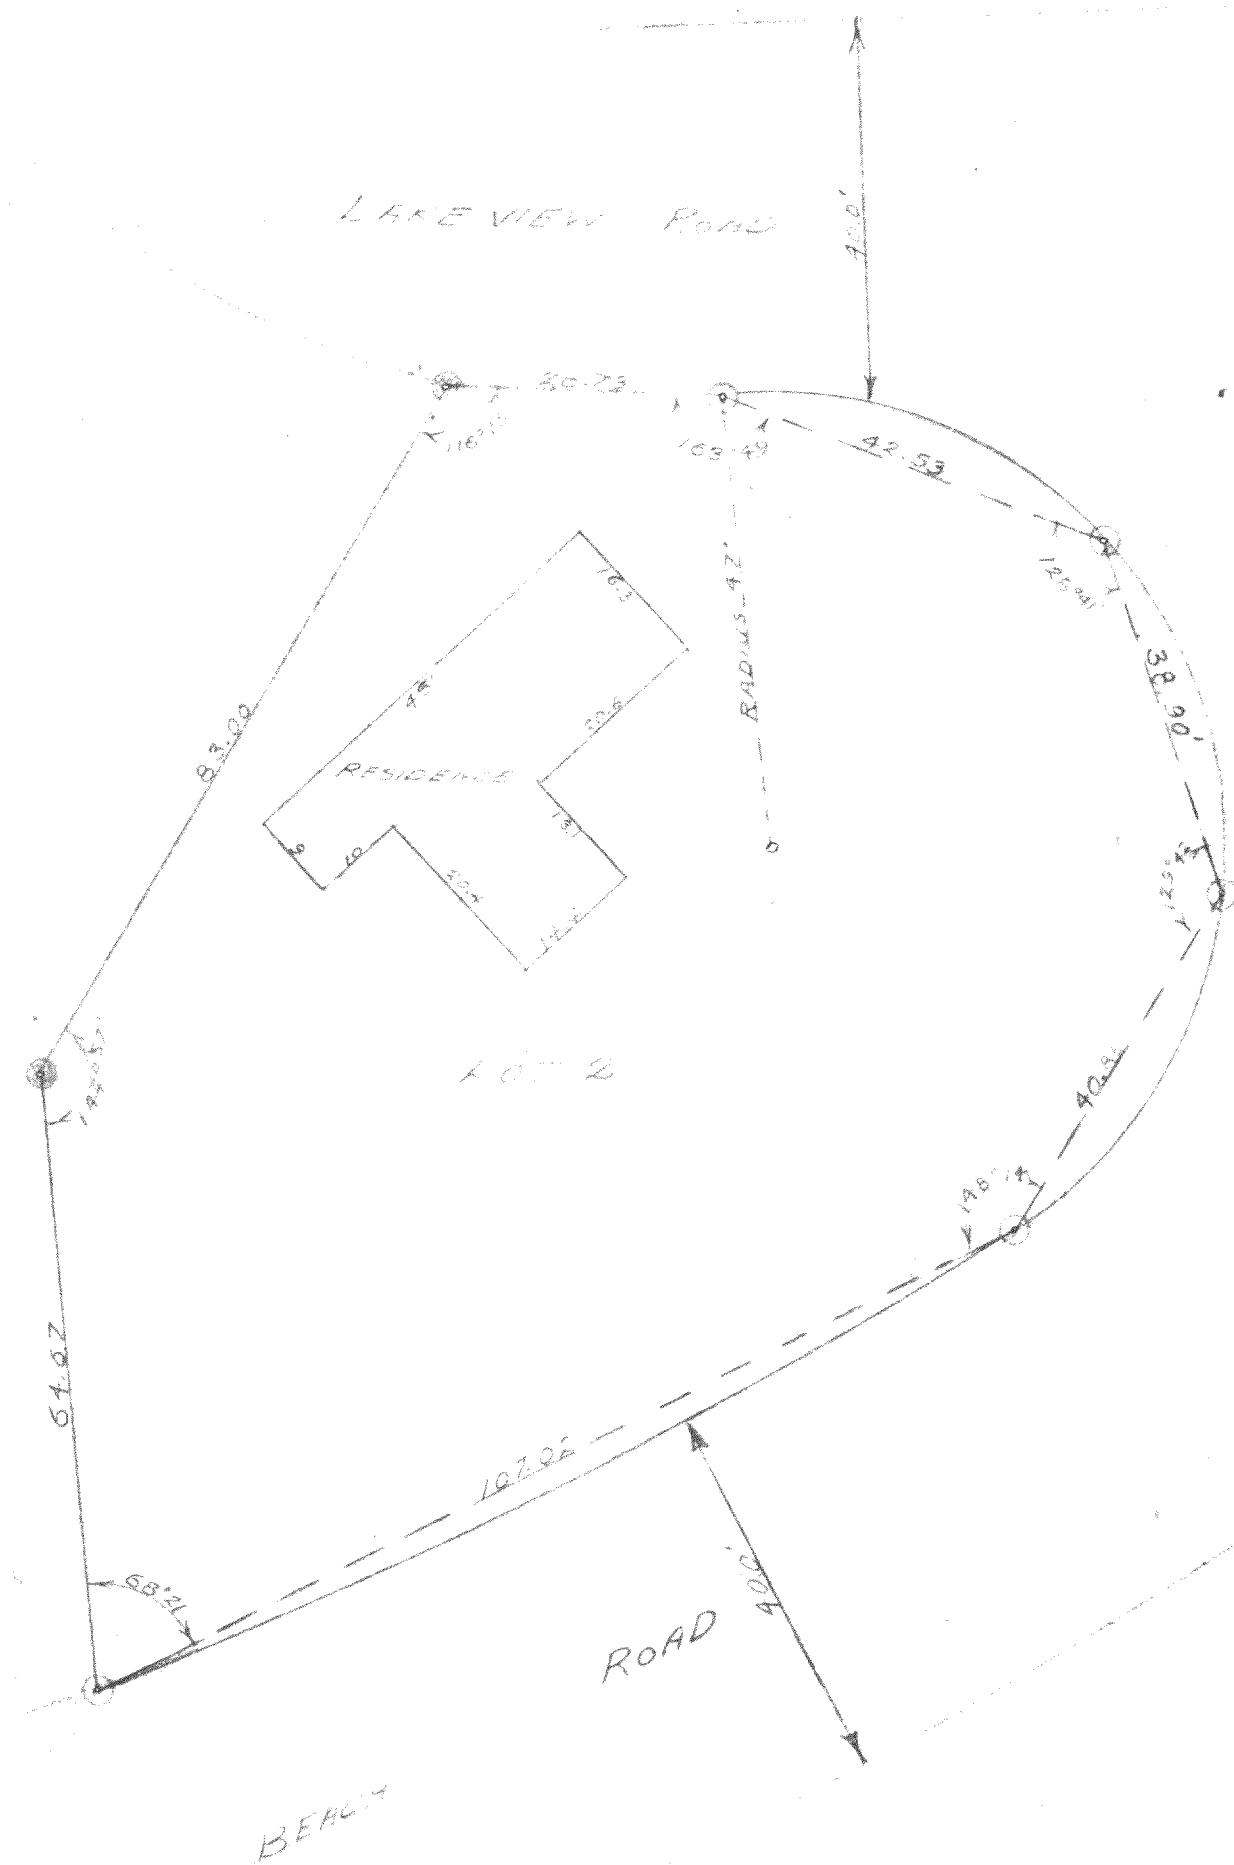

- CONCRETE MONUMENT
- IRON PIPE

PLAT OF SURVEY OF

LOT 2 BLOCK 1 IN THE WOODDALE ADDITION
LOCATED IN TIN RIFE WALWORTH COUNTY
WISCONSIN

Lloyd S. Jensen
SURVEYOR

SCALE 1" = 20'

DATE DEC. 1956

IW-2

117-1551