


PLAT OF SURVEY

PATHFINDER SURVEYING
FORMERLY KOLB LAND CONSULTING
N9135 ASH STREET MUKWONAGO WI.
(414) 870-1894

DATE: JULY 22, 1997

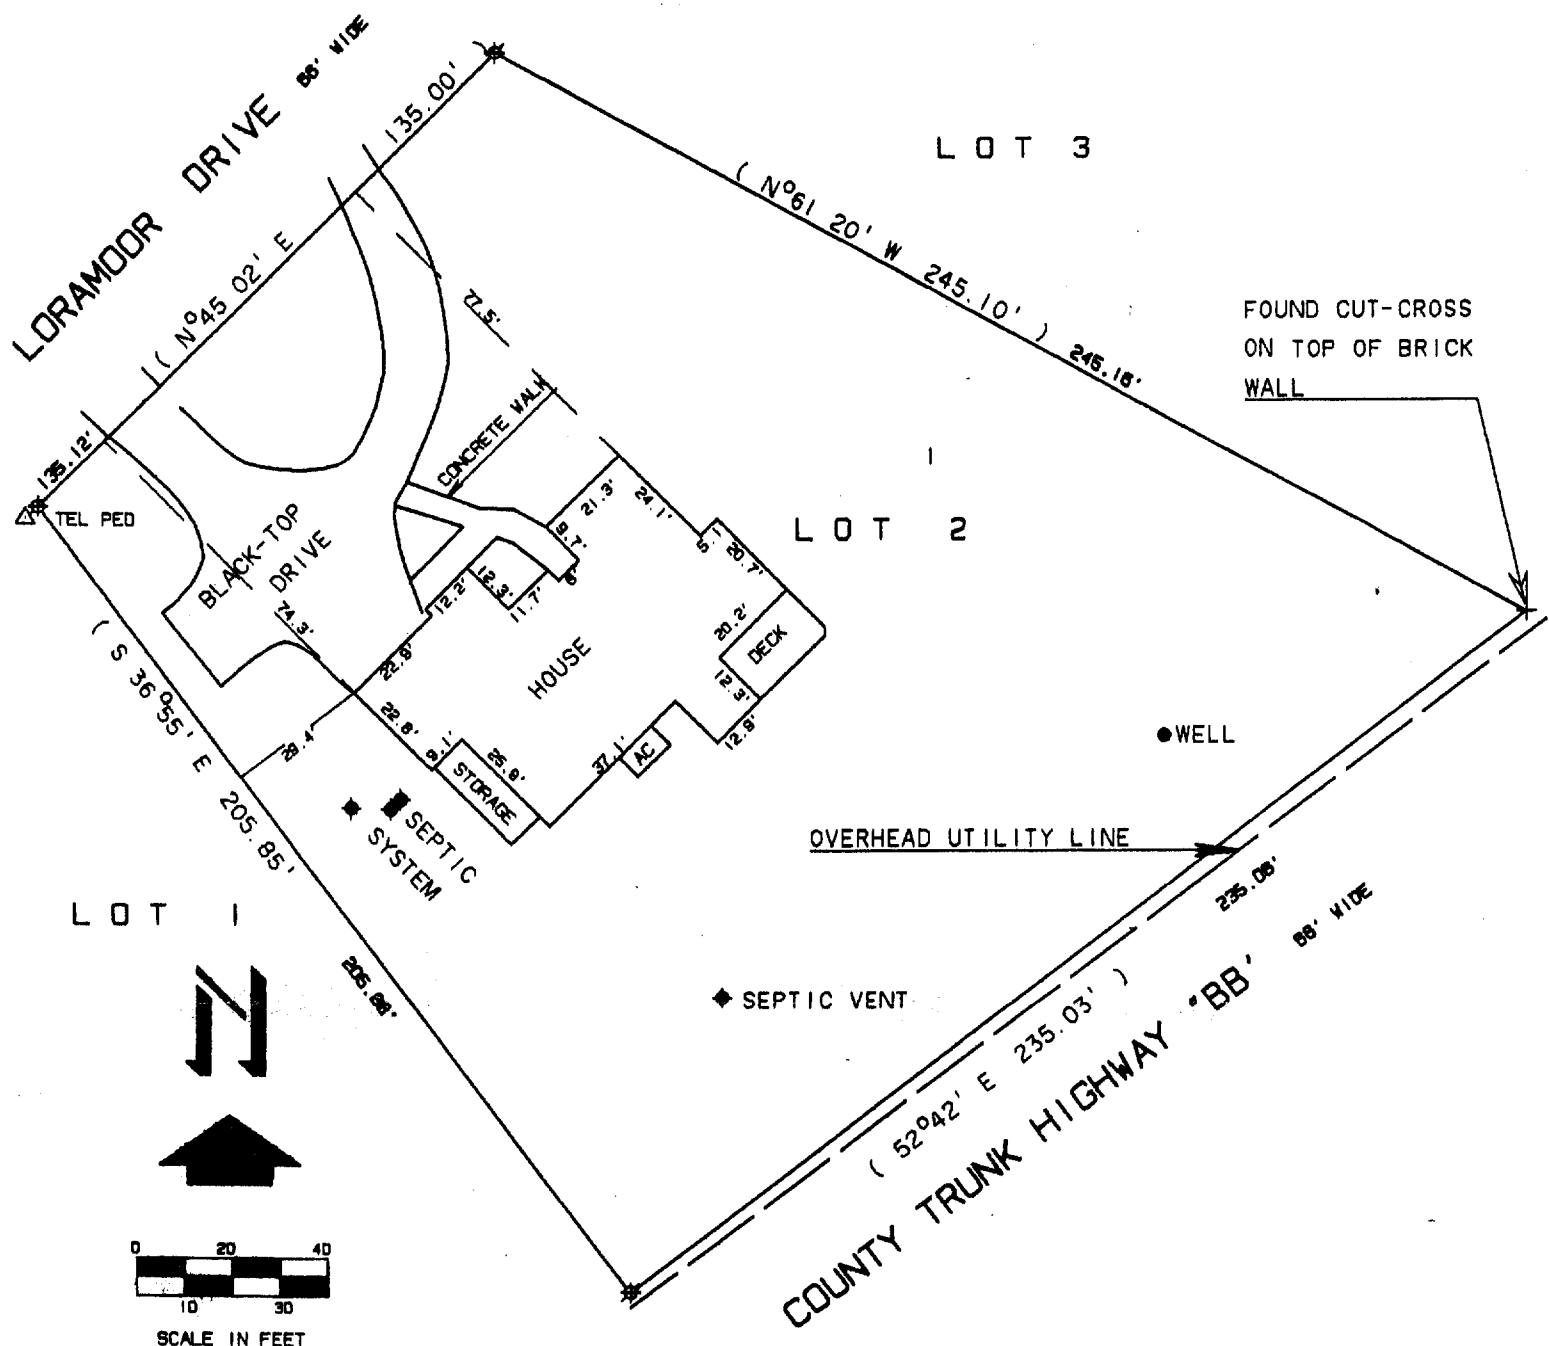

ORDERED BY:
KEEFE REAL ESTATE
751 GENEVA PARKWAY
LAKE GENEVA WI 53147


LEGEND
Ø IRON PIPE FOUND
+ CUT CROSS FOUND
() AS RECORDED

PLAT OF SURVEY OF:
LOT 2 OF LORAMOOD SUBDIVISION, LOCATED IN THE SOUTHEAST 1/4 OF
SECTION 11, T 1 N, R 17 E, TOWN OF LINN, WALWORTH COUNTY, WI.

THE ABOVE MAP IS A TRUE REPRESENTATION THEREOF AND
SHOWS THE SIZE AND LOCATION OF ALL THE PROPERTY,
EXTERIOR BOUNDARIES, THE LOCATION OF ALL VISIBLE
BOUNDARY FENCES, APPARENT EASEMENTS, ROADWAYS
AND VISIBLE ENCROACHMENTS, IF ANY

THIS SURVEY IS MADE FOR THE USE OF THE PRESENT
OWNERS OF THE PROPERTY, AND ALSO THOSE WHO
PURCHASE, MORTGAGE OR GUARANTEE TITLE THERETO
WITHIN ONE (1) YEAR FROM DATE HERETO.

John P. Krott
JOHN P. KROTT, R.L.S. 2258

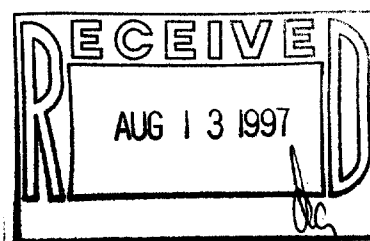

NOTE: THIS IS NOT A CERTIFIED COPY
SEAL IS IN RED.
JOB NUMBER

ILWL-2
117-1583