


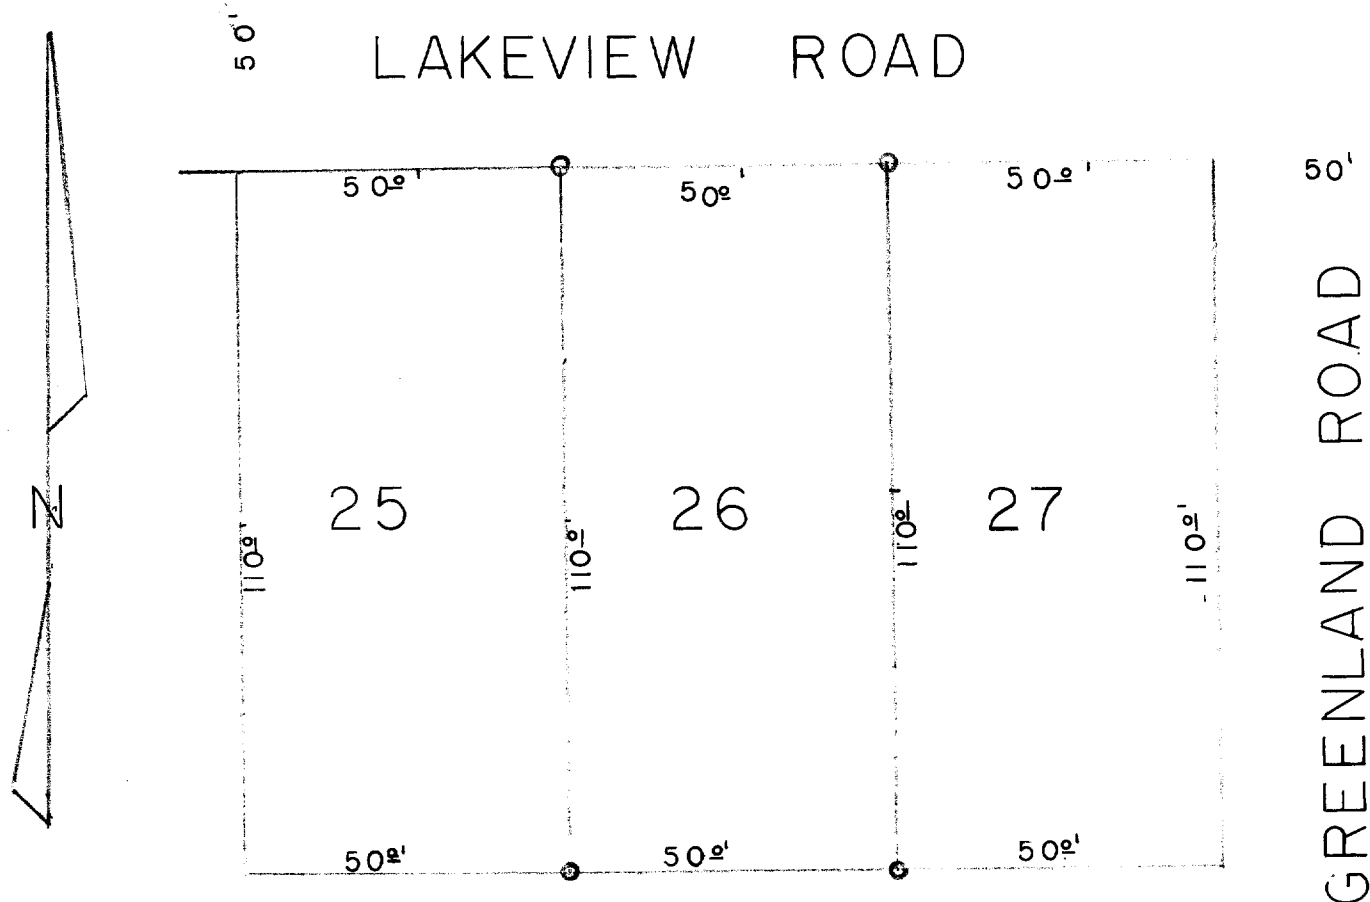

DESCRIPTION:

Lot 26, Lake Geneva Highlands Subdivision of a portion of Section 8, Town 1, north, Range 17 east of the 4th Principal Meridian, Walworth County Wisconsin.

CERTIFICATE:

I, hereby certify that I have on this the 4th day of June 1957, surveyed the above described property according to the official record on file in the office of the Recorder of Deeds in and for Walworth County, Wisconsin, and find that no encroachments exist.

SIGNED AND SEALED ON THIS THE 5 TH DAY OF JUNE 1957.

Joseph M. Biagi
Joseph M. Biagi. P.E.
Registered Surveyor
Elkhorn Wisconsin.