


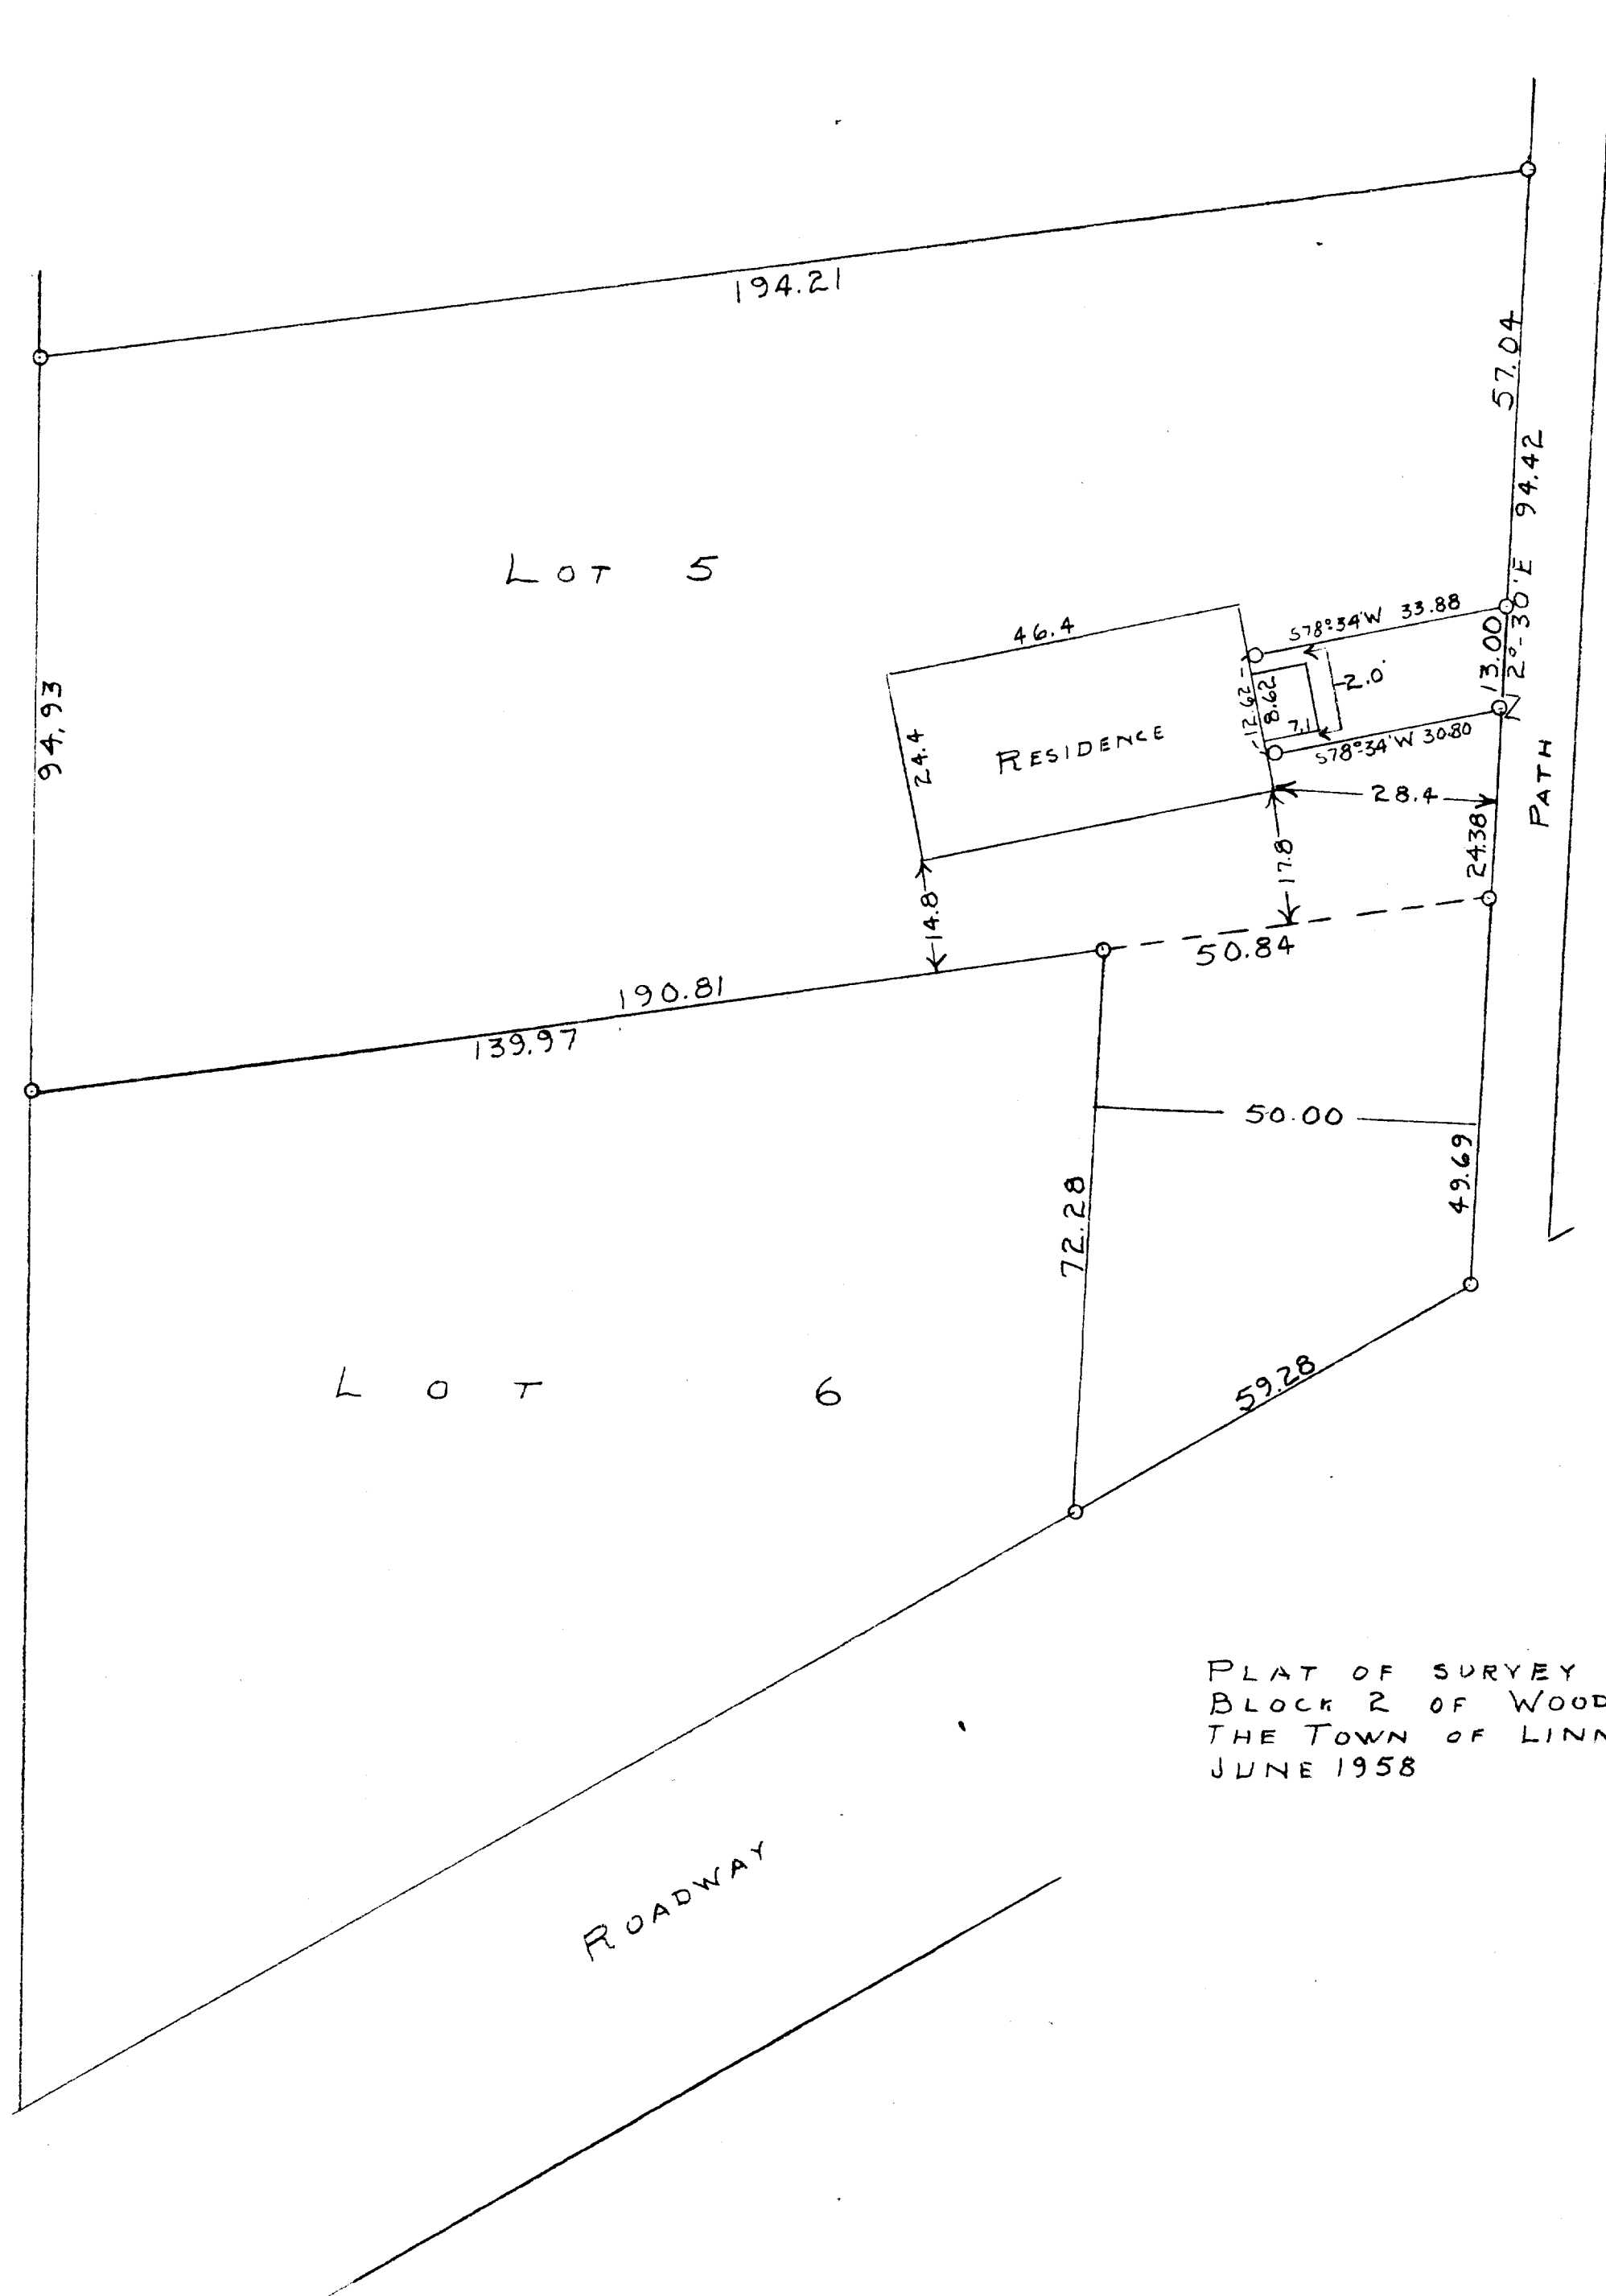

SCALE 1"=20'
O=IRON PIPE

PLAT OF SURVEY OF PART OF LOT 6 AND LOT 5
BLOCK 2 OF WOODDALE ADDITION LOCATED IN
THE TOWN OF LINN, WALWORTH COUNTY, WISCONSIN
JUNE 1958

George T. Dunham
GEORGE T. DUNHAM, SURVEYOR
DELAVER, WISCONSIN