


22

Como Ave.


Shore View Drive

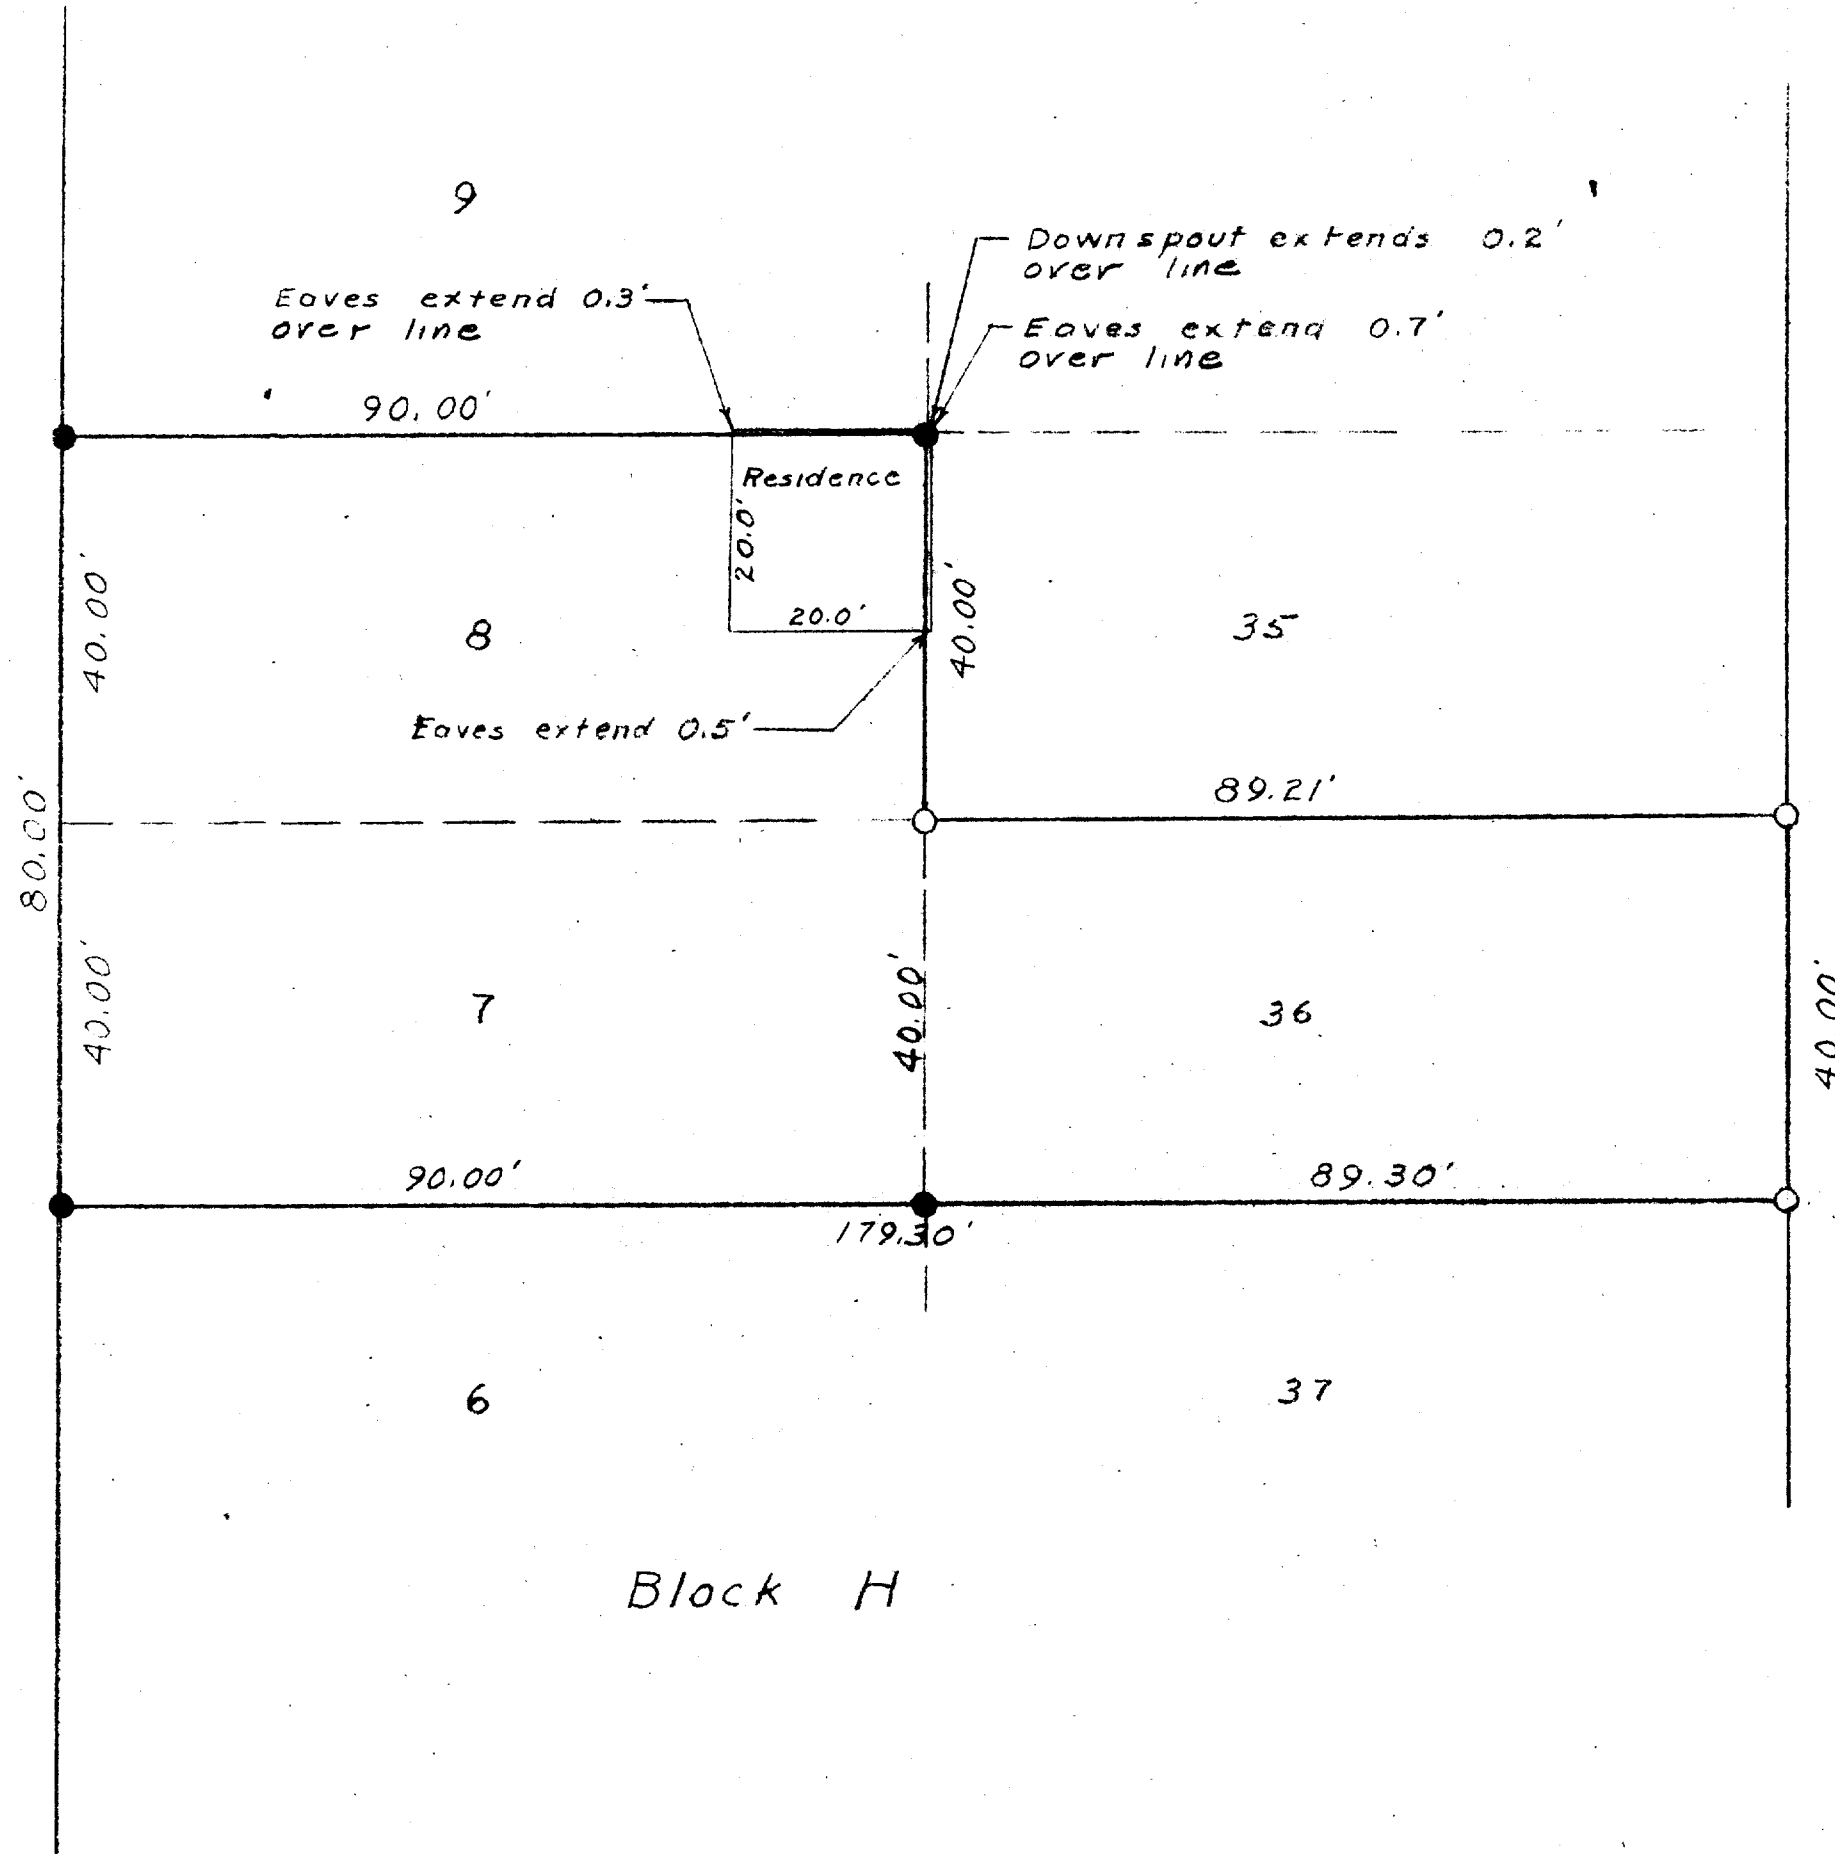

Block H

- - Concrete Monument
- - Iron Pipe

ICI - 169
ICI - 182

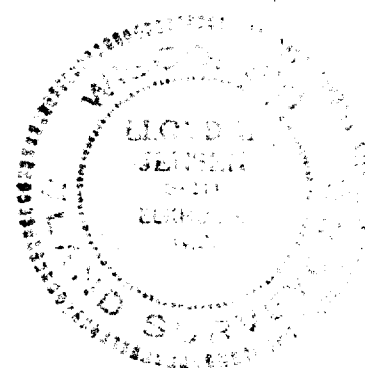

PLAT OF SURVEY OF

Lots 7, 8 and 36, Block H, Cisco Beach, located in the NE 1/4, Section 5, T1N, R17E, Walworth County, Wisconsin

Lloyd L. Jensen
SURVEYOR

SCALE 1" = 20'

DATE Nov. 1957

117-164.1