


WALWORTH COUNTY
SURVEYING & MAPPING
P. O. BOX 1115
LAKE GENEVA, WISCONSIN
414-248-0505

PLAT OF SURVEY OF

PART OF LOT 10, BLOCK 1 OF TRINKE ESTATES,
ACCORDING TO THE PLAT THEREOF RECORDED IN
VOLUME 12 OF PLATS ON PAGE 49, LOCATED IN
GOVERNMENT LOT 1, WHICH LOT IS THE SOUTHEAST
QUARTER OF THE SOUTHEAST QUARTER AND THE
NORTHEAST QUARTER OF THE SOUTHEAST QUARTER
OF SECTION 10, T 1 N, R 17 E, WALWORTH COUNTY,
WISCONSIN.

ORDERED BY: BERNARD CLIFFORD
12440 SOUTH POST ROAD
PALOS PARK, ILLINOIS
60464

NOTE: PIER LOCATED FROM EXISTING CRIBS.

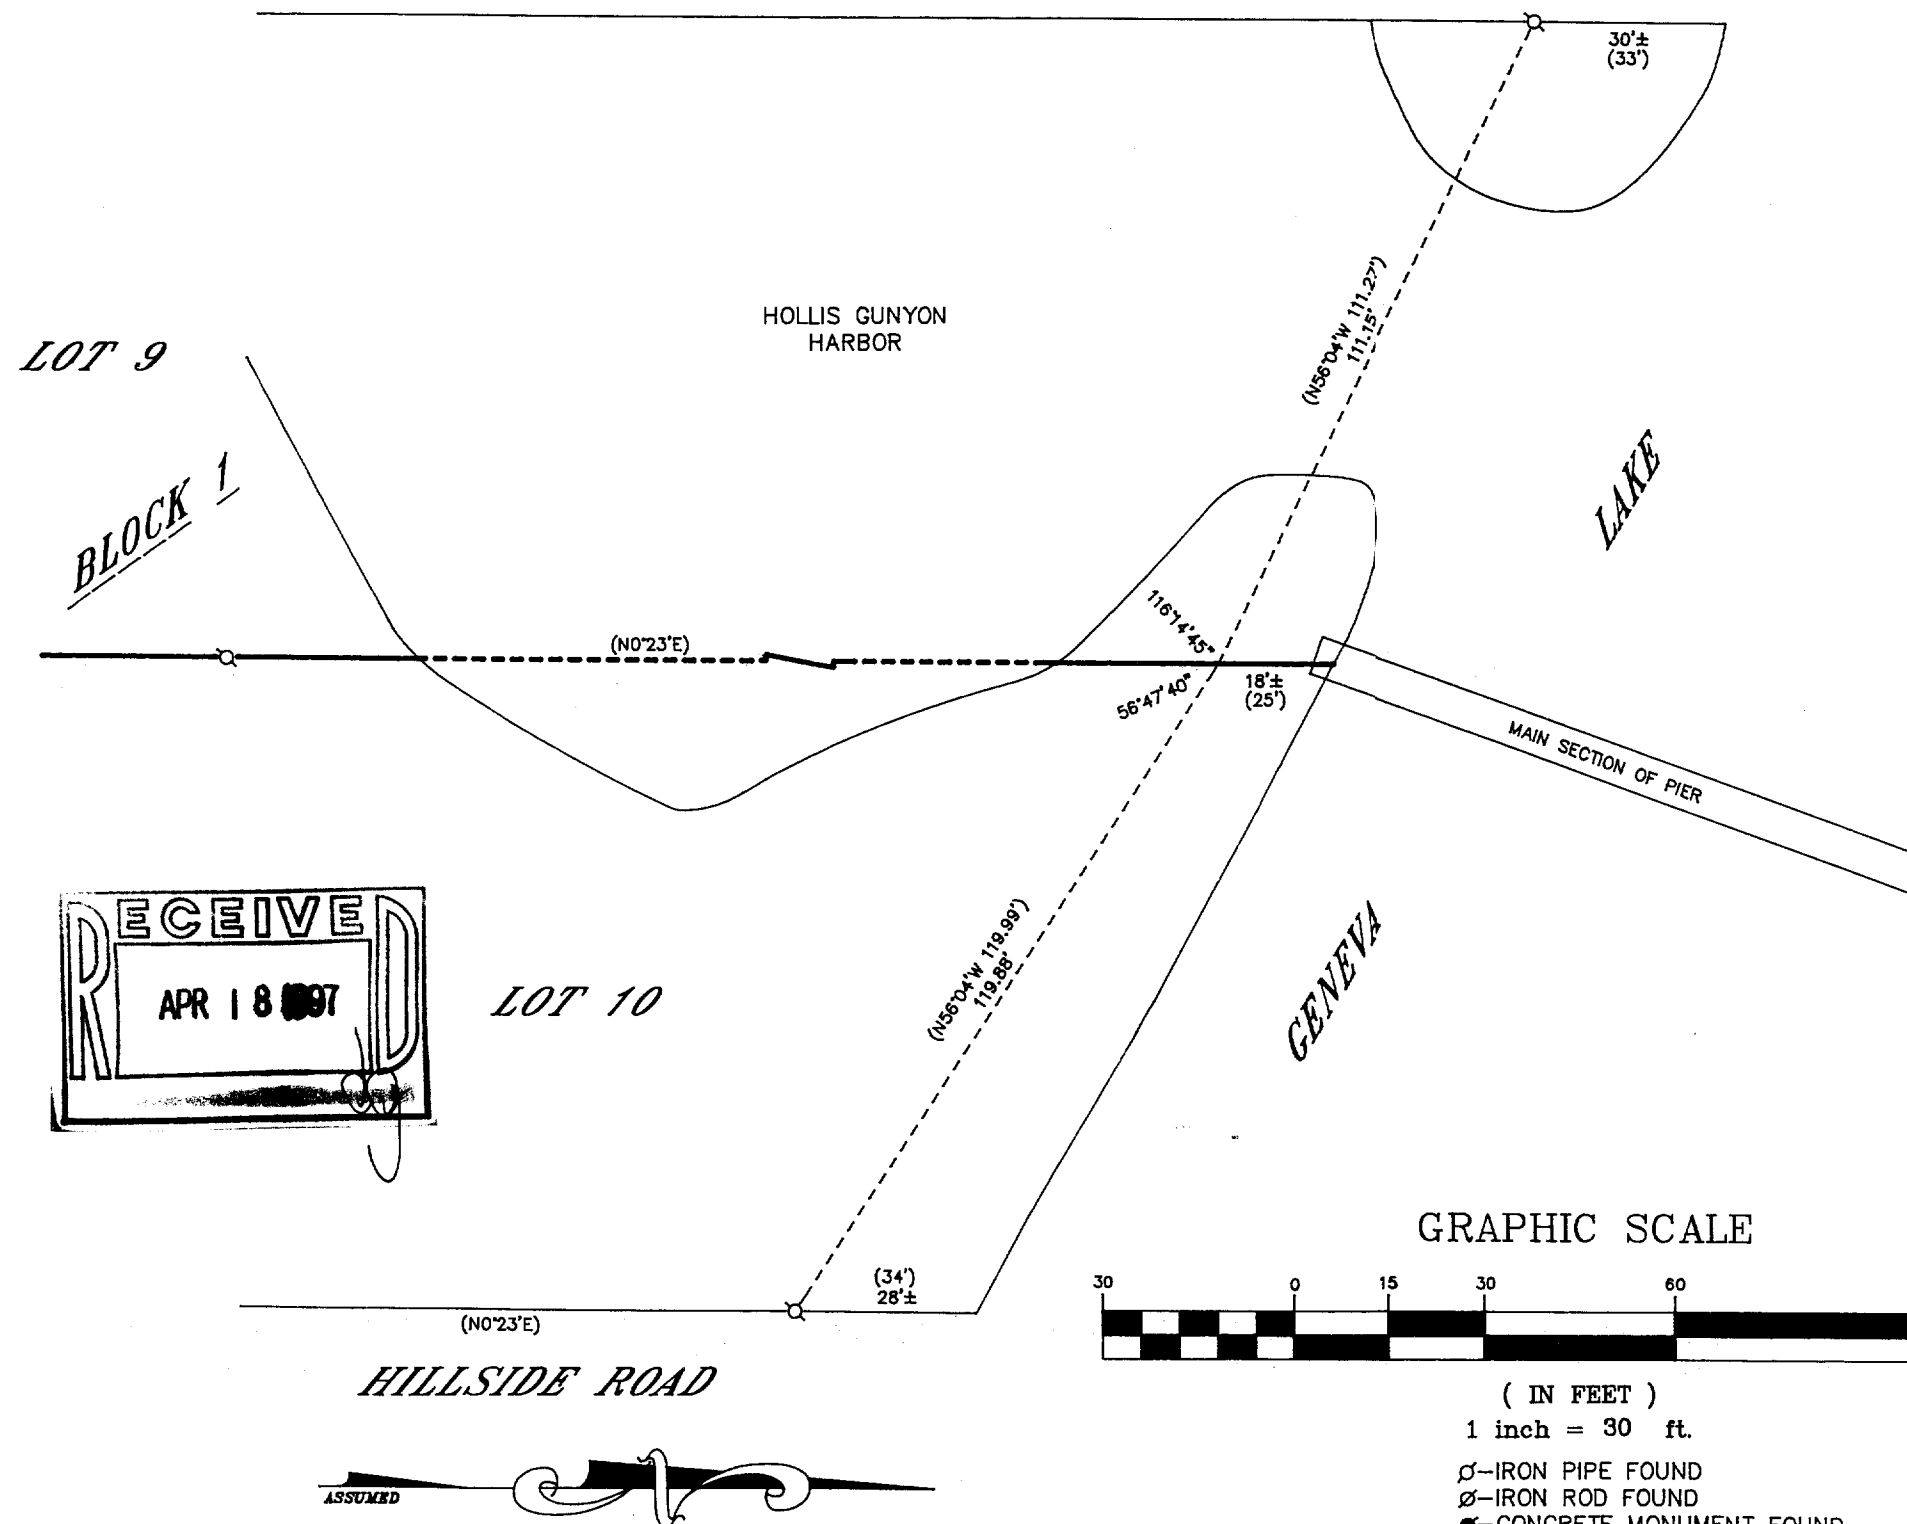

I HEREBY CERTIFY THAT I HAVE SURVEYED THE PROPERTY HEREON DESCRIBED ACCORDING TO THE OFFICIAL RECORDS AND THAT THE PLAT HEREON IS A CORRECT REPRESENTATION THEREOF TO THE BEST OF MY KNOWLEDGE AND BELIEF.

Robert M. Baerenwald
ROBERT M. BAERENWALD
WISCONSIN REGISTERED LAND SURVEYOR, S-1508

Nov. 19, 1996
DATE JOB NO. 5213

NOTE: THIS IS NOT A CERTIFIED COPY UNLESS SEALED.

ITE-10

117-1640