
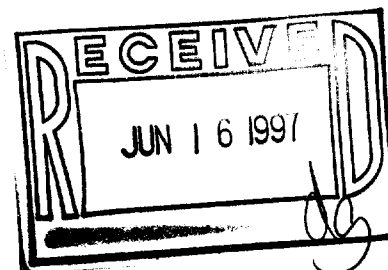


PHONE 414-537-4874
FAX 414-537-4221

Lot 22 in LAKE GENEVA HIGHLANDS, a subdivision by Taylor and Powers of the East Third (excepting the east 100 feet thereof) of the North Half of the Southeast Full Quarter of Section 8, Township 1 North, Range 17 East of the 4th Principal Meridian, being in the Town of Linn, Walworth County, Wisconsin.

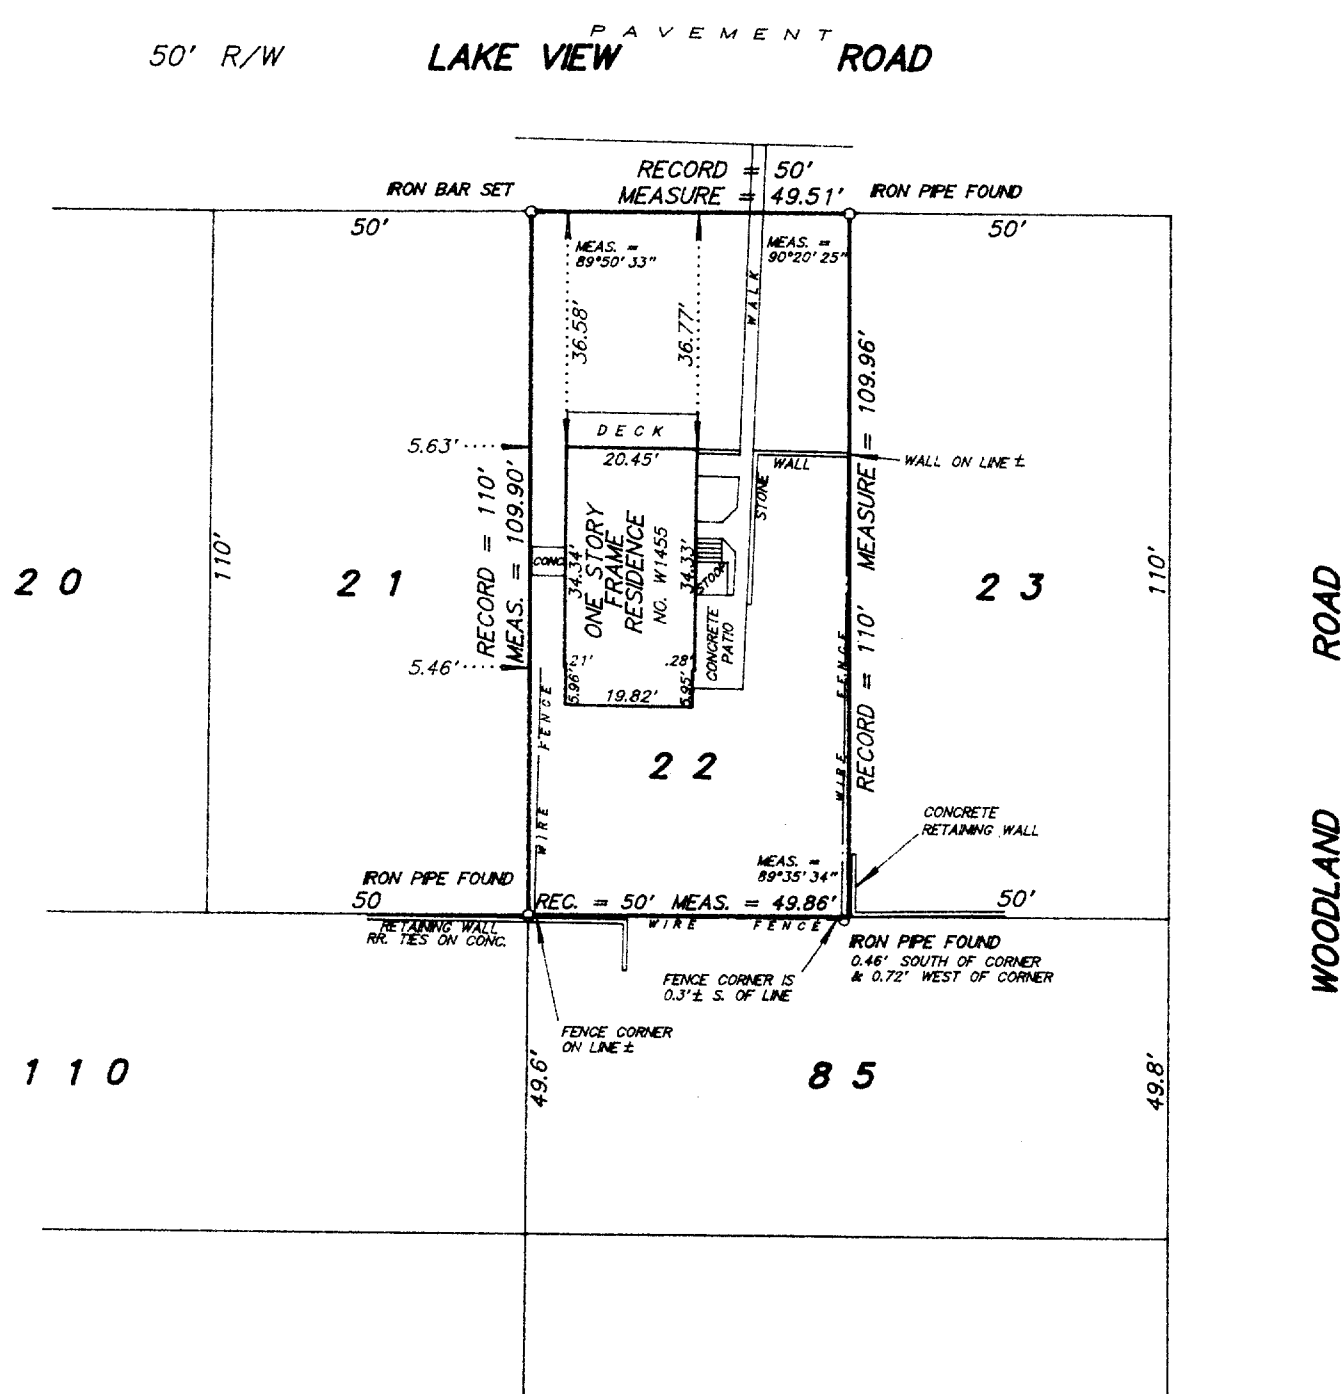

SCALE 1 inch = 30 feet

ORDERED BY A. Bates - Attorney At Law

JOB NO. 9 7 1 3 7

I hereby certify that I have surveyed the above described property and the above plat is a true representation thereof and shows the size and location of the property, its exterior boundaries, the location and dimensions of all visible structures thereon, boundary fences, apparent easements and roadways and visible encroachments, if any.

This survey is made for the exclusive use of the present owners of the property, and also those who purchase, mortgage, or guarantee the title thereto within one year from the date hereof.

Dated at Bassett, Wisconsin this _____ day of _____ 1997.

Mark A. Bolender
Wisconsin Registered Land Surveyor S - 1784

1LGH-21

117-1664