


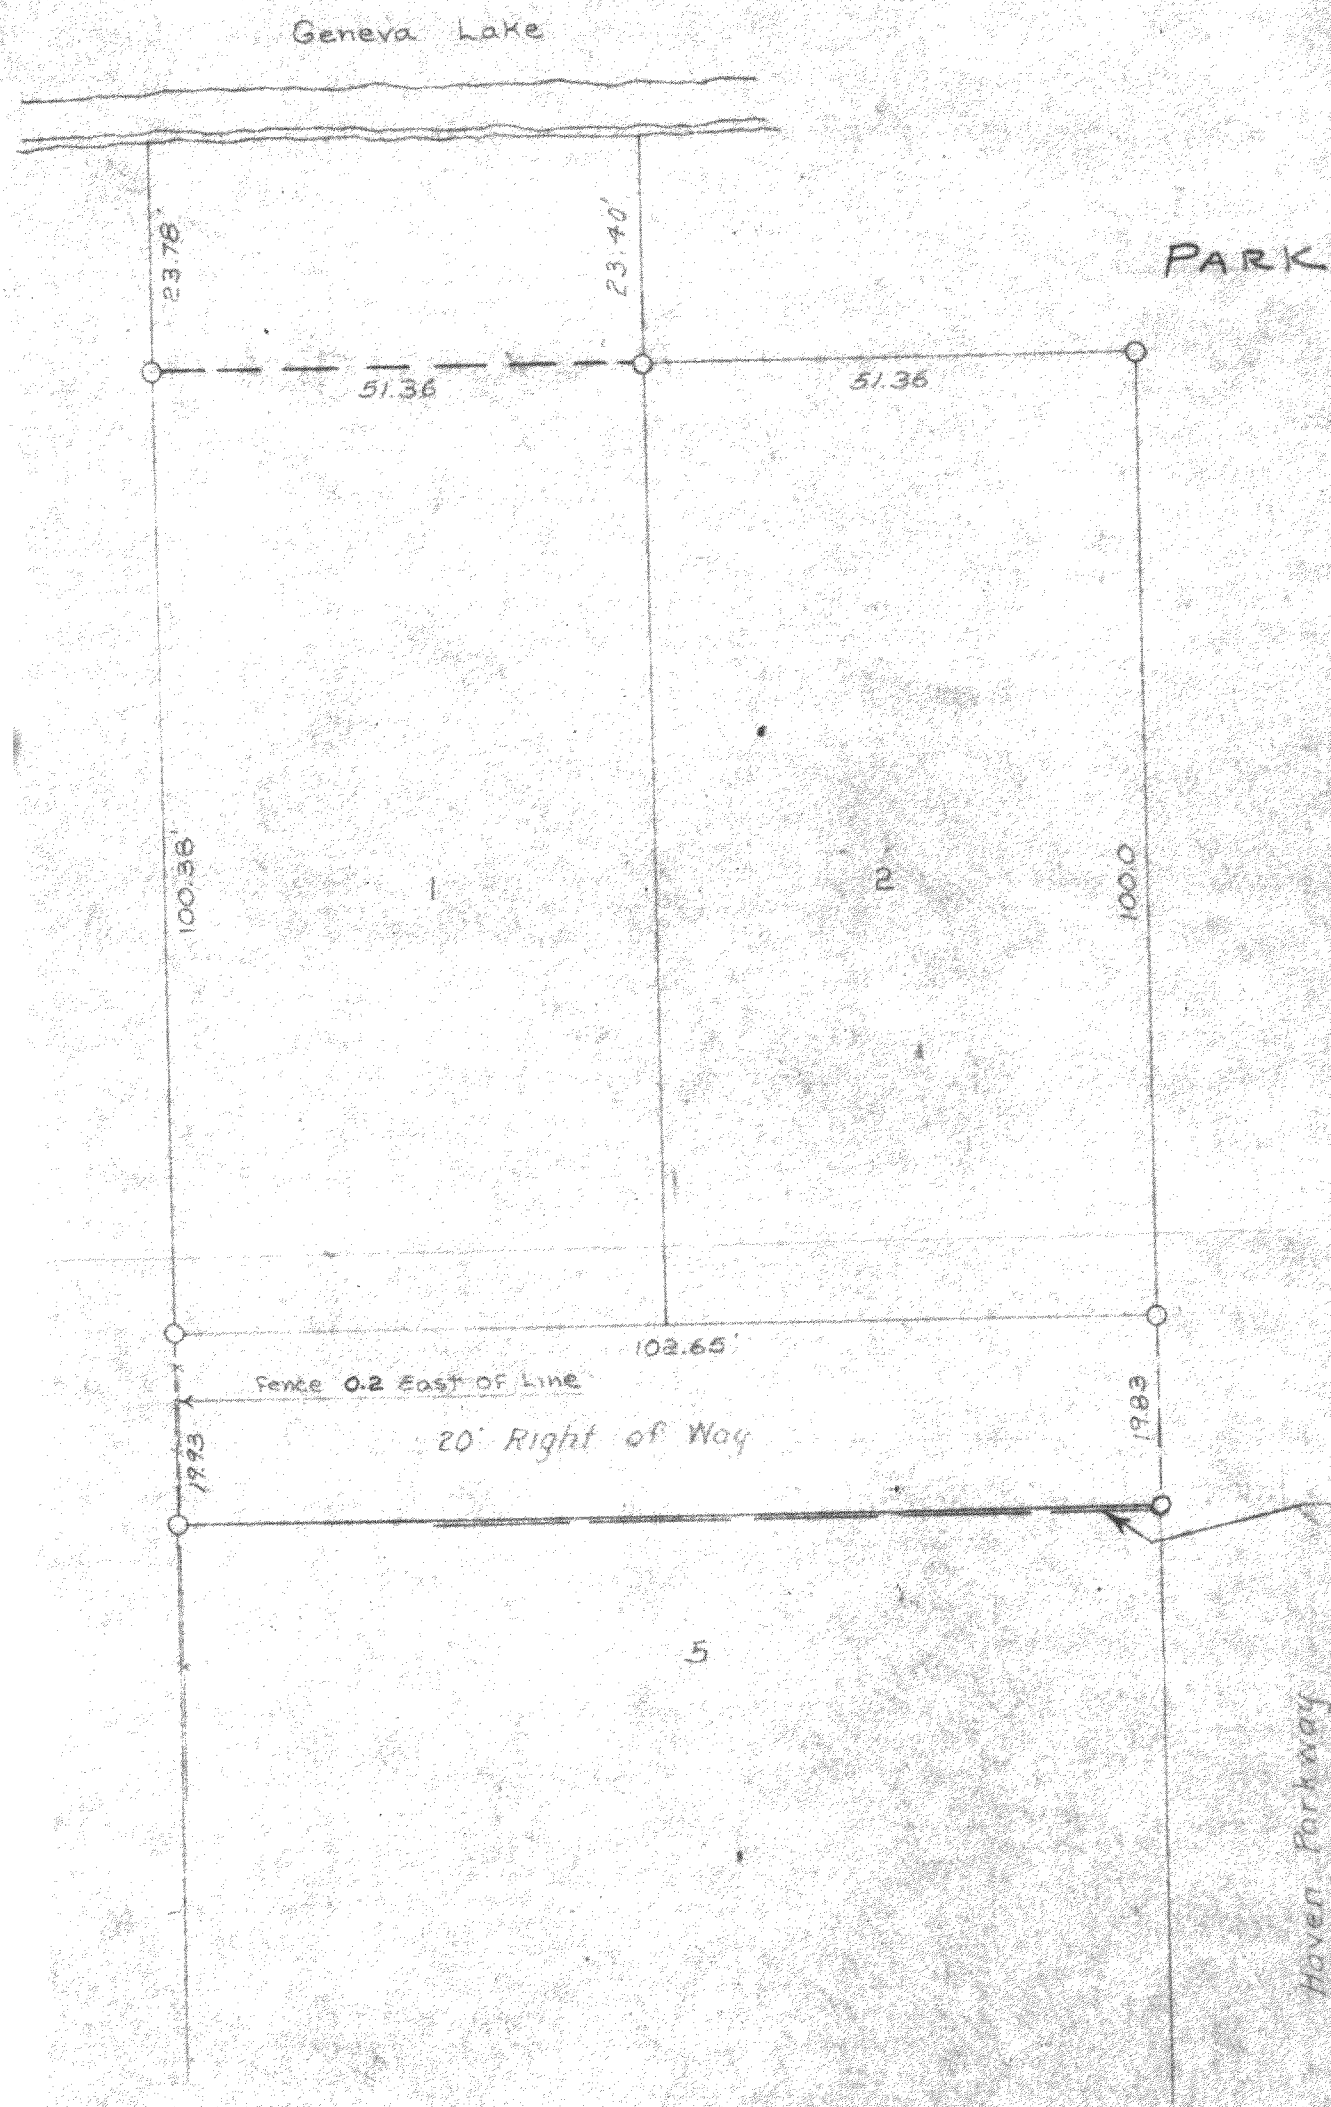

Corrugated retaining wall
0.3' to 1.0' high located after
wall was moved.

Iron pipe

PLAT OF SURVEY OF

Lots 1 and 2 and 20 Foot ROW in Shore
Haven Subdivision located in the NE 1/4 of
section 18 T1N, R17E, Walworth County,
Wisconsin

Lloyd Jensen
SURVEYOR

SCALE 1" = 20'

DATE April 22, 1958

TSA-1
10 2

117-167,1