
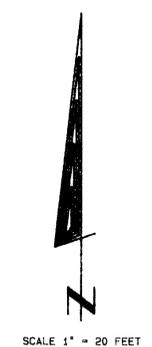


PLAT OF SURVEY

LOTS 53 AND 54 OF BLOCK 4 OF
LAKEVIEW PARK SUBDIVISION,
LOCATED IN SECTION 16, TOWN 1
NORTH, RANGE 17 EAST, TOWN OF
LINN, WALWORTH COUNTY,
WISCONSIN.

ORDERED BY: MARY ELLEN WAITE
OWNERS: ROBERT AND MARYALICE KOEHNE
826 HONEY CREEK PARKWAY
WAUWATOSA, WI. 53213
TAX KEY NO. ILVP00026B

RECORDING DATA FOR SUBDIVISION:
VOL. 10 P. 13 OF WALWORTH COUNTY PLATS
CABINET A SLIDE 6
GEORGE W. POSEY SURVEYOR DATED JULY 1928

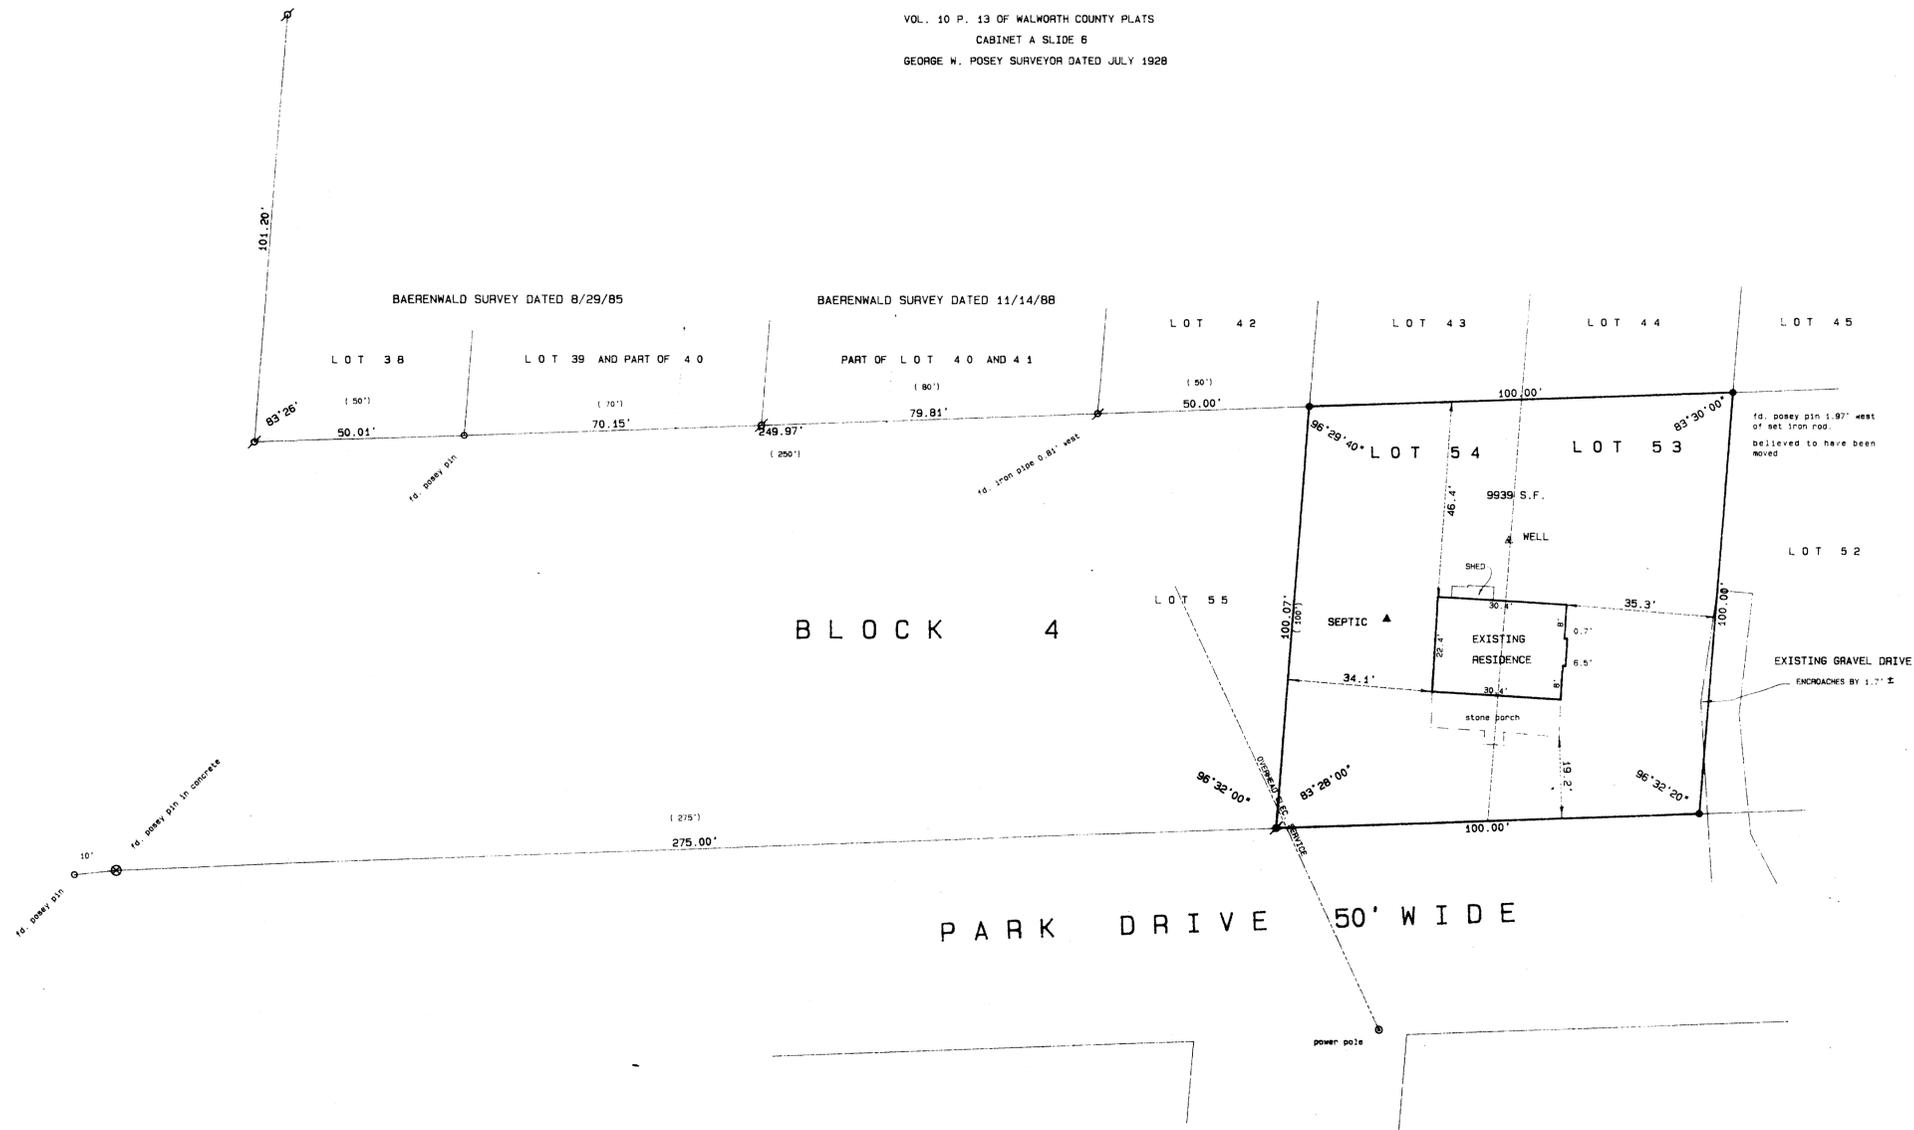

- Legend**
- FOUND IRON PIPE
 - FOUND IRON ROD
 - FOUND BRASS-CAPPED MONUMENT
 - FOUND CONCRETE MONUMENT
 - CHISEL CUT IN CONCRETE
 - SET IRON ROD, 24" LONG, WEIGHING 1.5 LBS./LINEAL FT., 3/4" DIA.
 - SET IRON ROD, 30" LONG, WEIGHING 4.5 LBS./LINEAL FT., 1-11/16" DIA.
 - (***) RECORDED AS DIMENSION
 - EXISTING FENCE



SCALE: 1" = 20 FEET



I hereby certify that the above described property has been surveyed by me or under my direction and that the above map is a true representation thereof and shows the size and location of the property, its exterior boundaries, the location of all visible structures and dimensions of all principal buildings thereon, boundary fences, apparent easements, roadways and visible encroachments, if any.
This survey is made for the use of the present owners of the property, and also those who purchase, mortgage, or guarantee the site thereof, within one year from date hereof.
Kenneth B. Abernathy Jr.
KENNETH B. ABERNATHY, JR.
WISCONSIN REGISTERED LAND SURVEYOR, S-1594
Date: 9-17-97 Job No. 97.907

ILVP-26B
117-1688