

PLAT OF SURVEY


PATHFINDER SURVEYING
FORMERLY KOLB LAND CONSULTING
N9135 ASH STREET MUKWONAGO WI.
(414) 870-1894

ORDERED BY: WILLIAM L. SEYMOUR
23 NORTH WISCONSIN ST.
ELKHORN, WI. 53121

DATE: 9/30/1997

OWNERS: JEROME R. AND DORIS L. VAINISI



DESCRIPTION: LOT 1 OF ELGIN CLUB SUBDIVISION A SUBDIVISION LOCATED IN THE SOUTHWEST 1/4 OF SECTION 4, T1N, R17E, WALWORTH COUNTY, WISCONSIN.

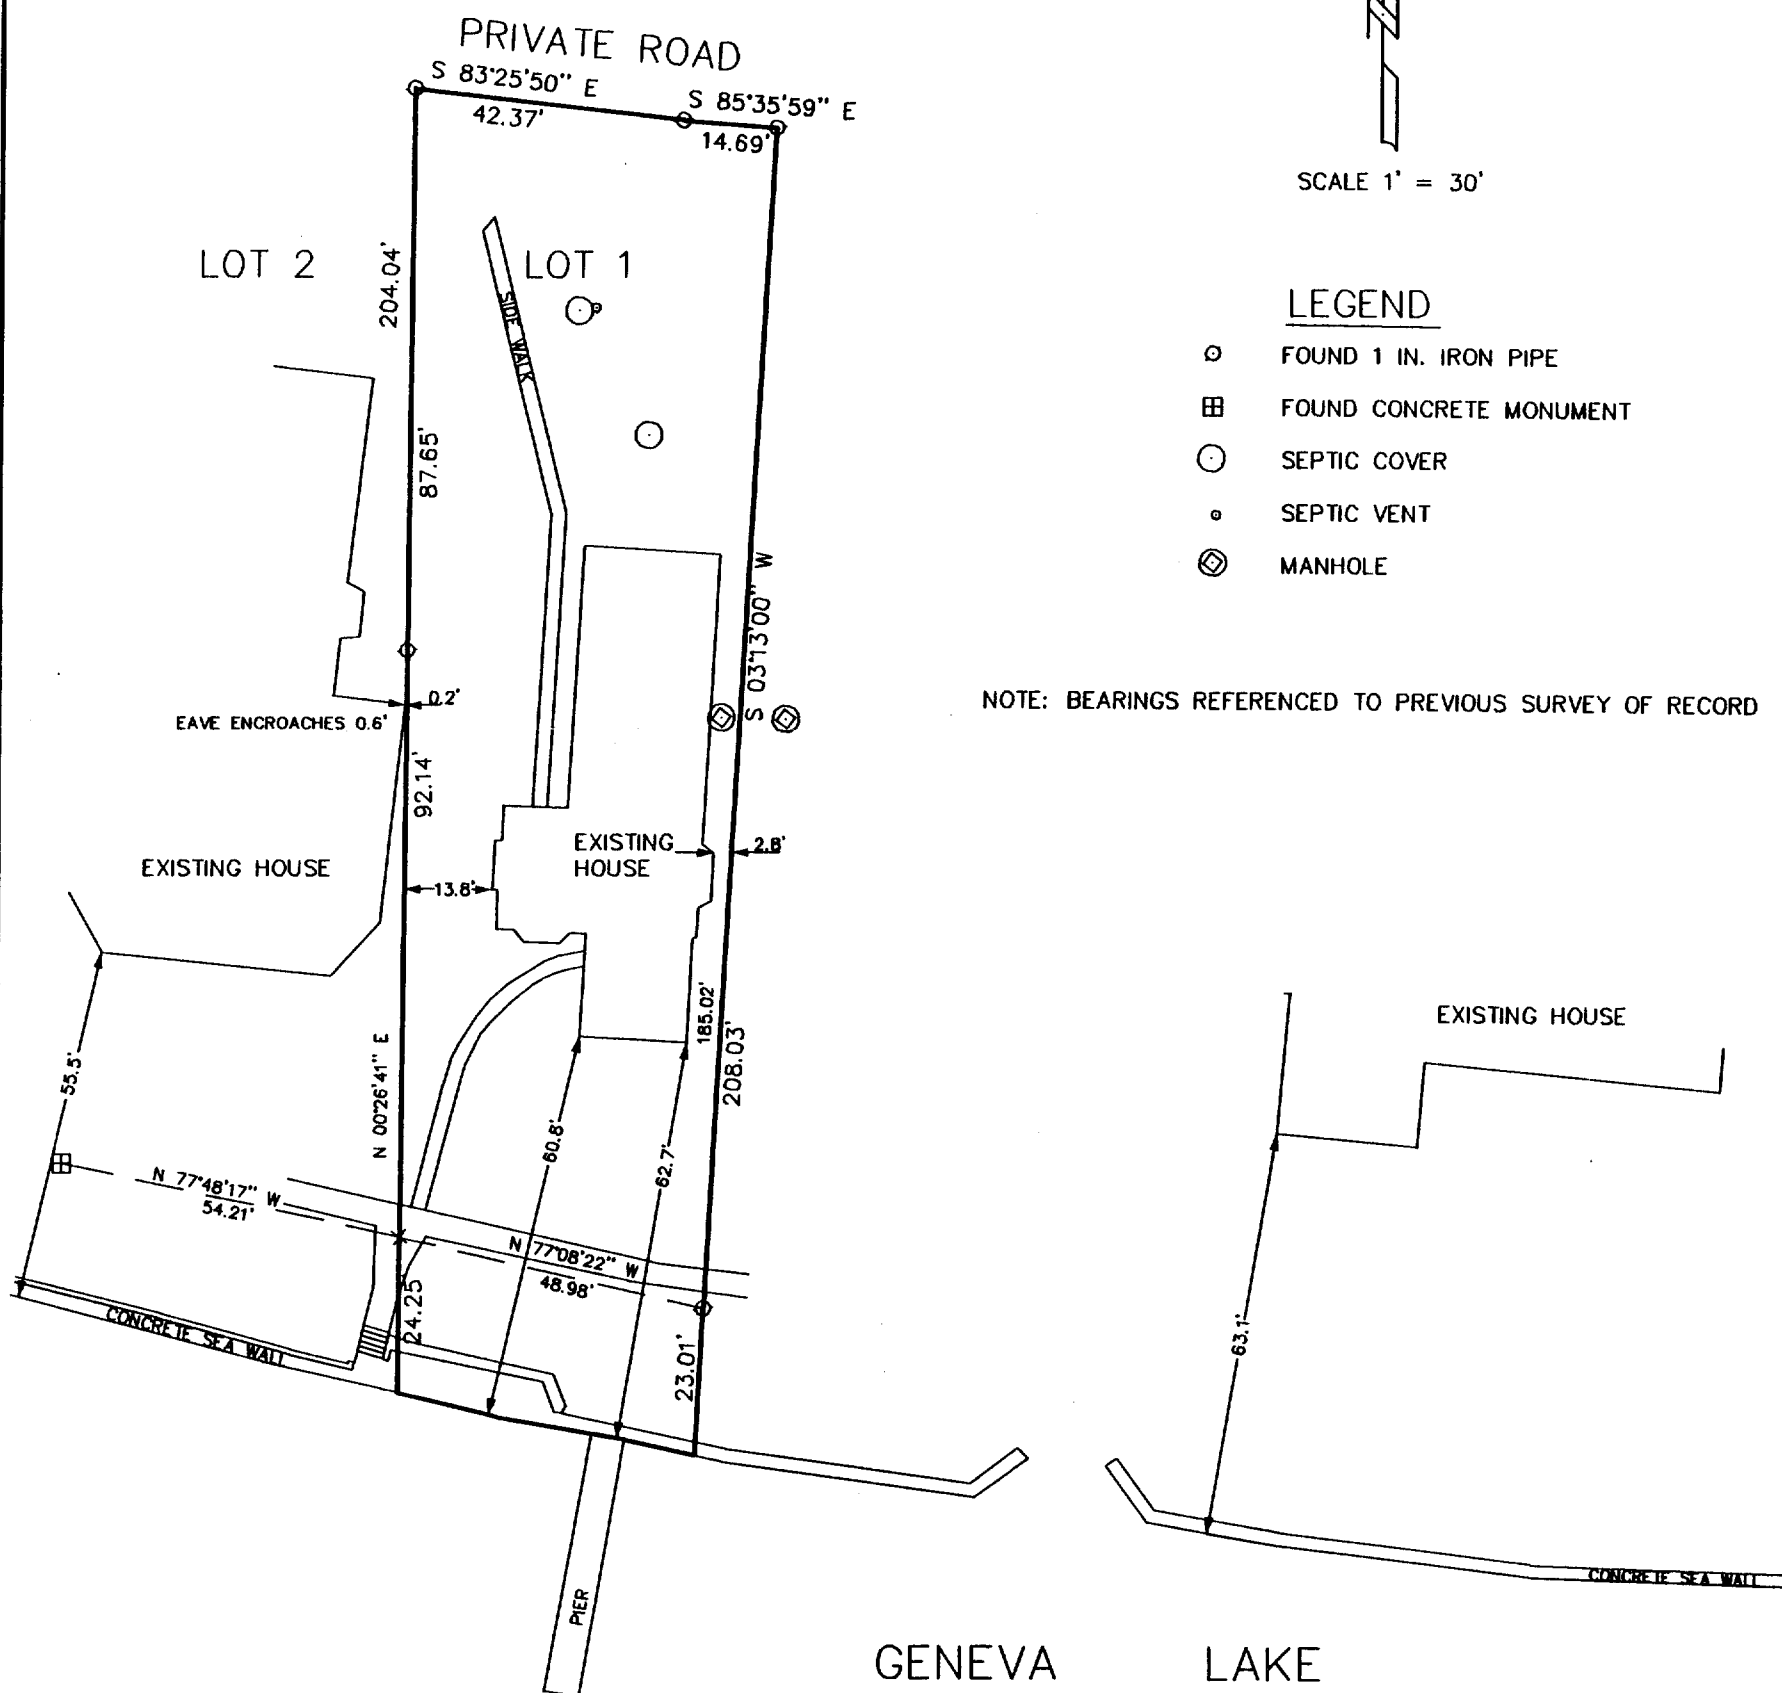

THE ABOVE MAP IS A TRUE REPRESENTATION THEREOF AND SHOWS THE SIZE AND LOCATION OF ALL THE PROPERTY, EXTERIOR BOUNDARIES, THE LOCATION OF ALL VISIBLE BOUNDARY FENCES, APPARENT EASEMENTS, ROADWAYS AND VISIBLE ENCROACHMENTS, IF ANY

THIS SURVEY IS MADE FOR THE USE OF THE PRESENT OWNERS OF THE PROPERTY, AND ALSO THOSE WHO PURCHASE, MORTGAGE OR GUARANTEE TITLE THERETO WITHIN ONE (1) YEAR FROM DATE HERETO.

John P. Krott
JOHN P. KROTT, R.L.S. 2258

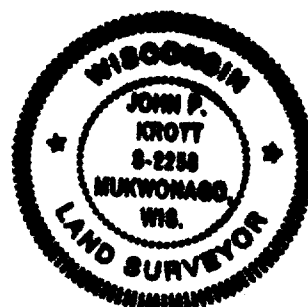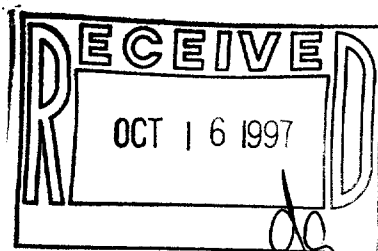

NOTE: THIS IS NOT A CERTIFIED COPY
UNLESS SEAL IS IN RED.
JOB NUMBER

IEC-1A
117-1691