

PLAT OF SURVEY

PATHFINDER SURVEYING
FORMERLY KOLB LAND CONSULTING
929 WILLIAMS STREET LAKE GENEVA, WI. 53147
(414) 248-3697


ORDERED BY:

KEEFE REAL ESTATE, INC. 751 GENEVA PKWY LAKE GENEVA WISCONSIN

DESCRIPTION:

LOTS 24 AND 25 OF ROBINSON'S SUBDIVISION LOCATED IN T1N, R17E, TOWN OF LYNN, WALWORTH COUNTY, WISCONSIN


DATE: 6/15/1998

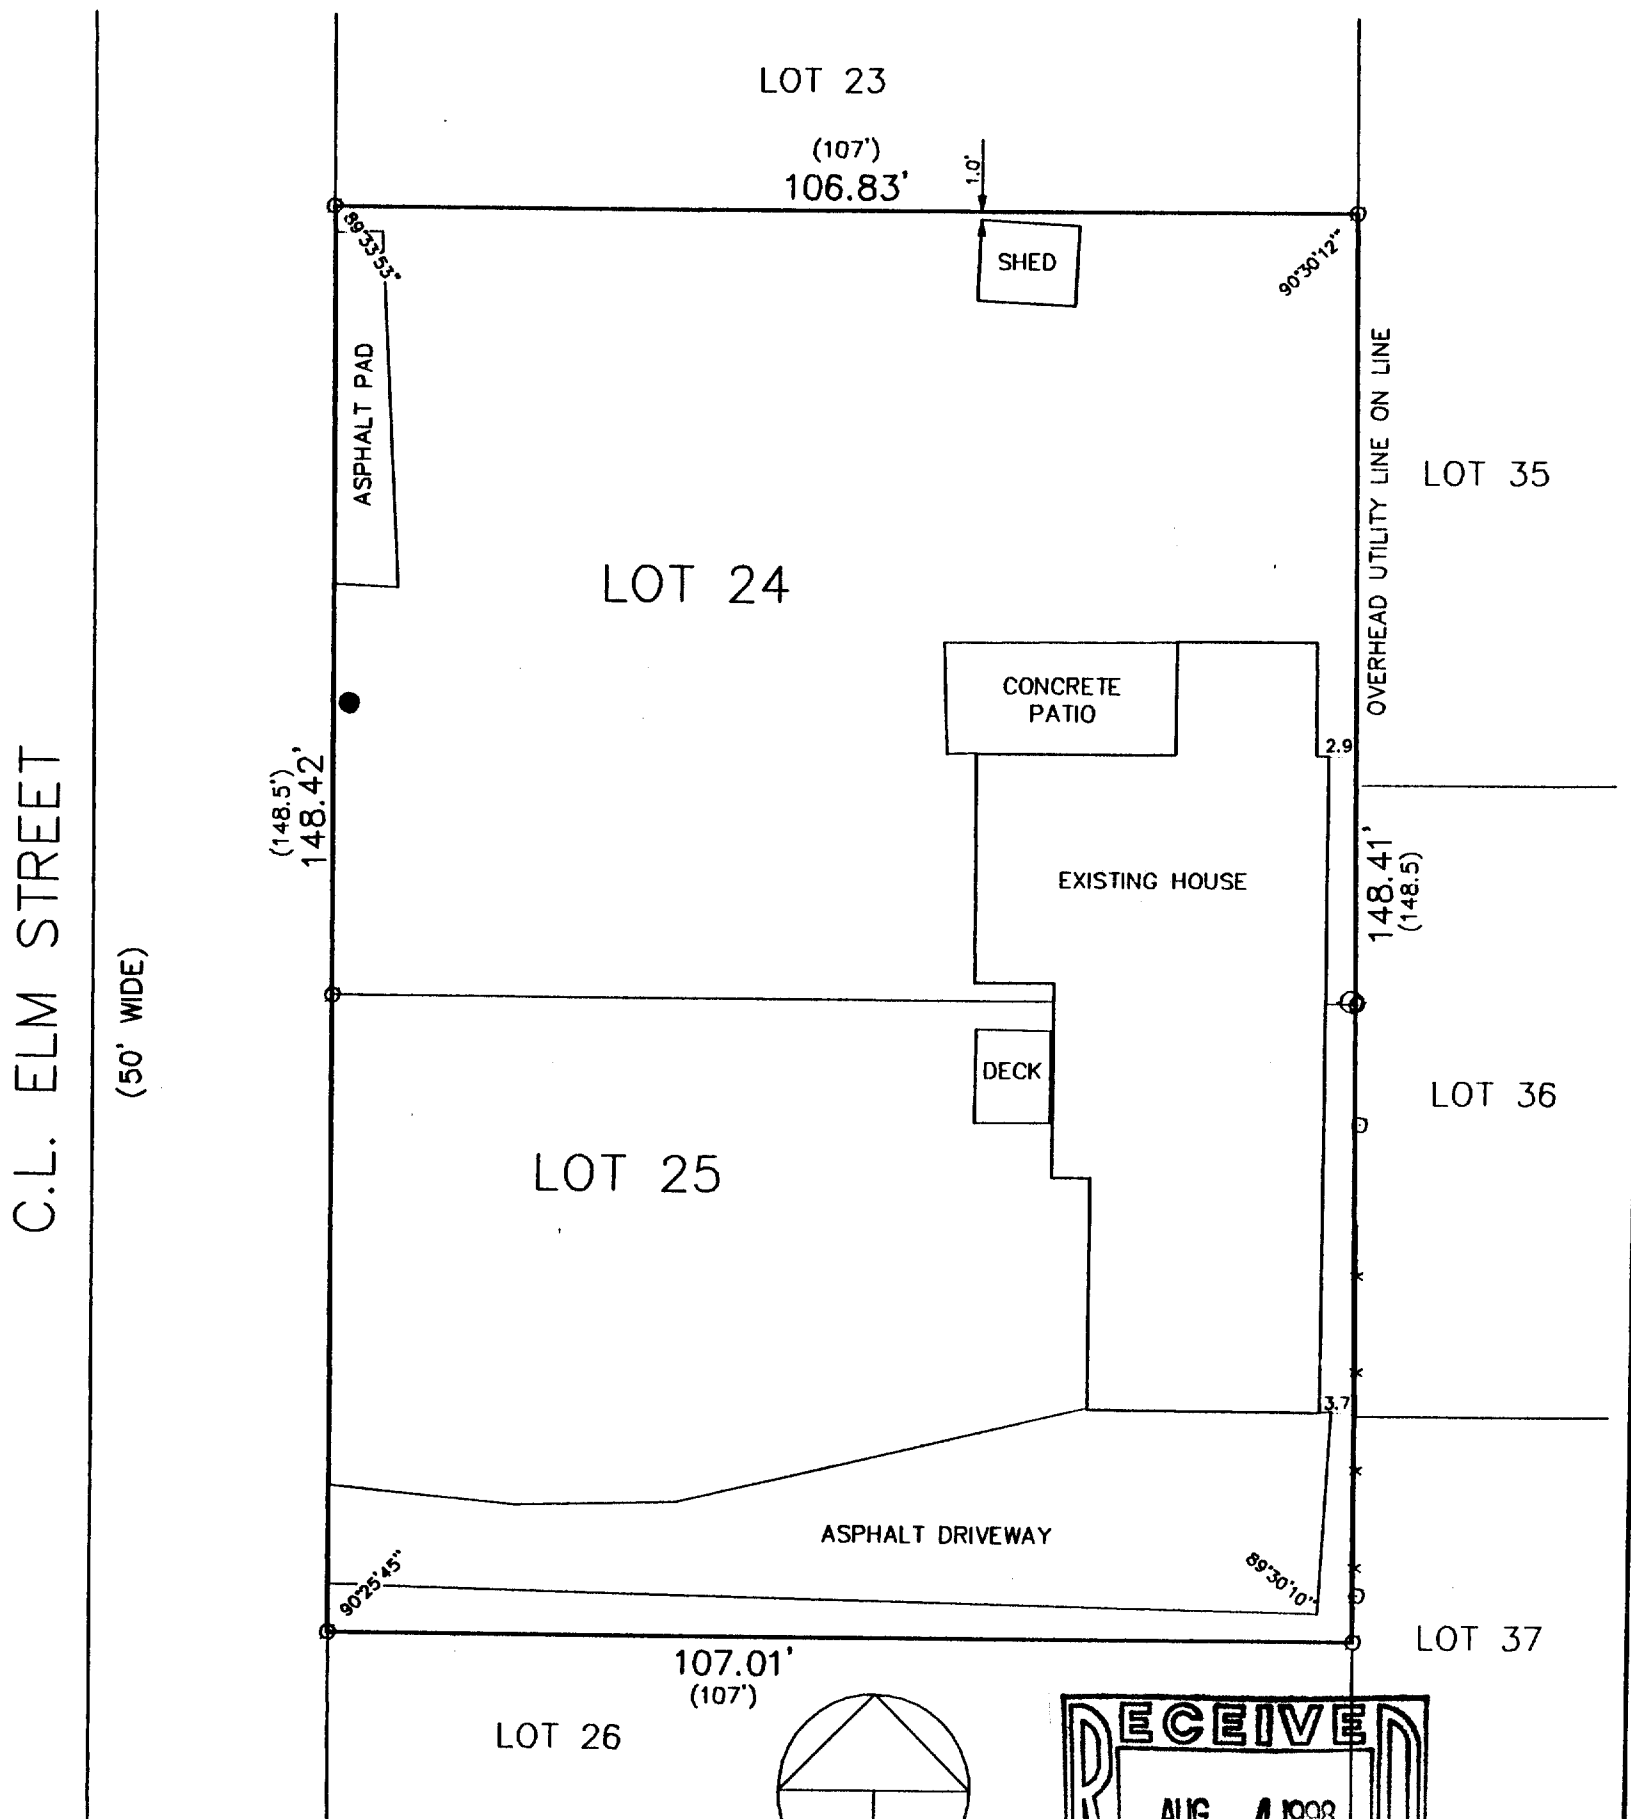

THE ABOVE MAP IS A TRUE REPRESENTATION THEREOF AND SHOWS THE SIZE AND LOCATION OF ALL THE PROPERTY, EXTERIOR BOUNDARIES, THE LOCATION OF ALL VISIBLE BOUNDARY FENCES, APPARENT EASEMENTS, ROADWAYS AND VISIBLE ENCROACHMENTS, IF ANY

THIS SURVEY IS MADE FOR THE USE OF THE PRESENT OWNERS OF THE PROPERTY, AND ALSO THOSE WHO PURCHASE, MORTGAGE OR GUARANTEE TITLE THERETO WITHIN ONE (1) YEAR FROM DATE HERETO.

John P. Krott
JOHN P. KROTT, R.L.S. 2258


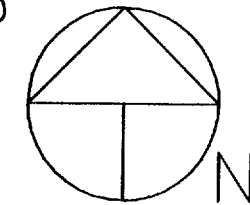


SCALE 1" = 20'

LEGEND

- FOUND IRON PIPE
- *— FENCE
- POWER POLE
- WATER WELL

(XXXX) RECORDED AS

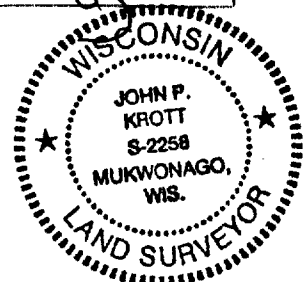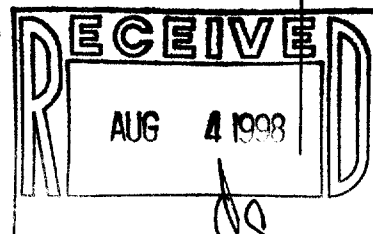

NOTE: THIS IS NOT A CERTIFIED COPY UNLESS SEAL IS IN RED.

JOB NUMBER 98100 1-17- IRB 100019

IRB1-19
117-1720