


GENEVA LAKE



- - Concrete monu.
- - Iron pipe

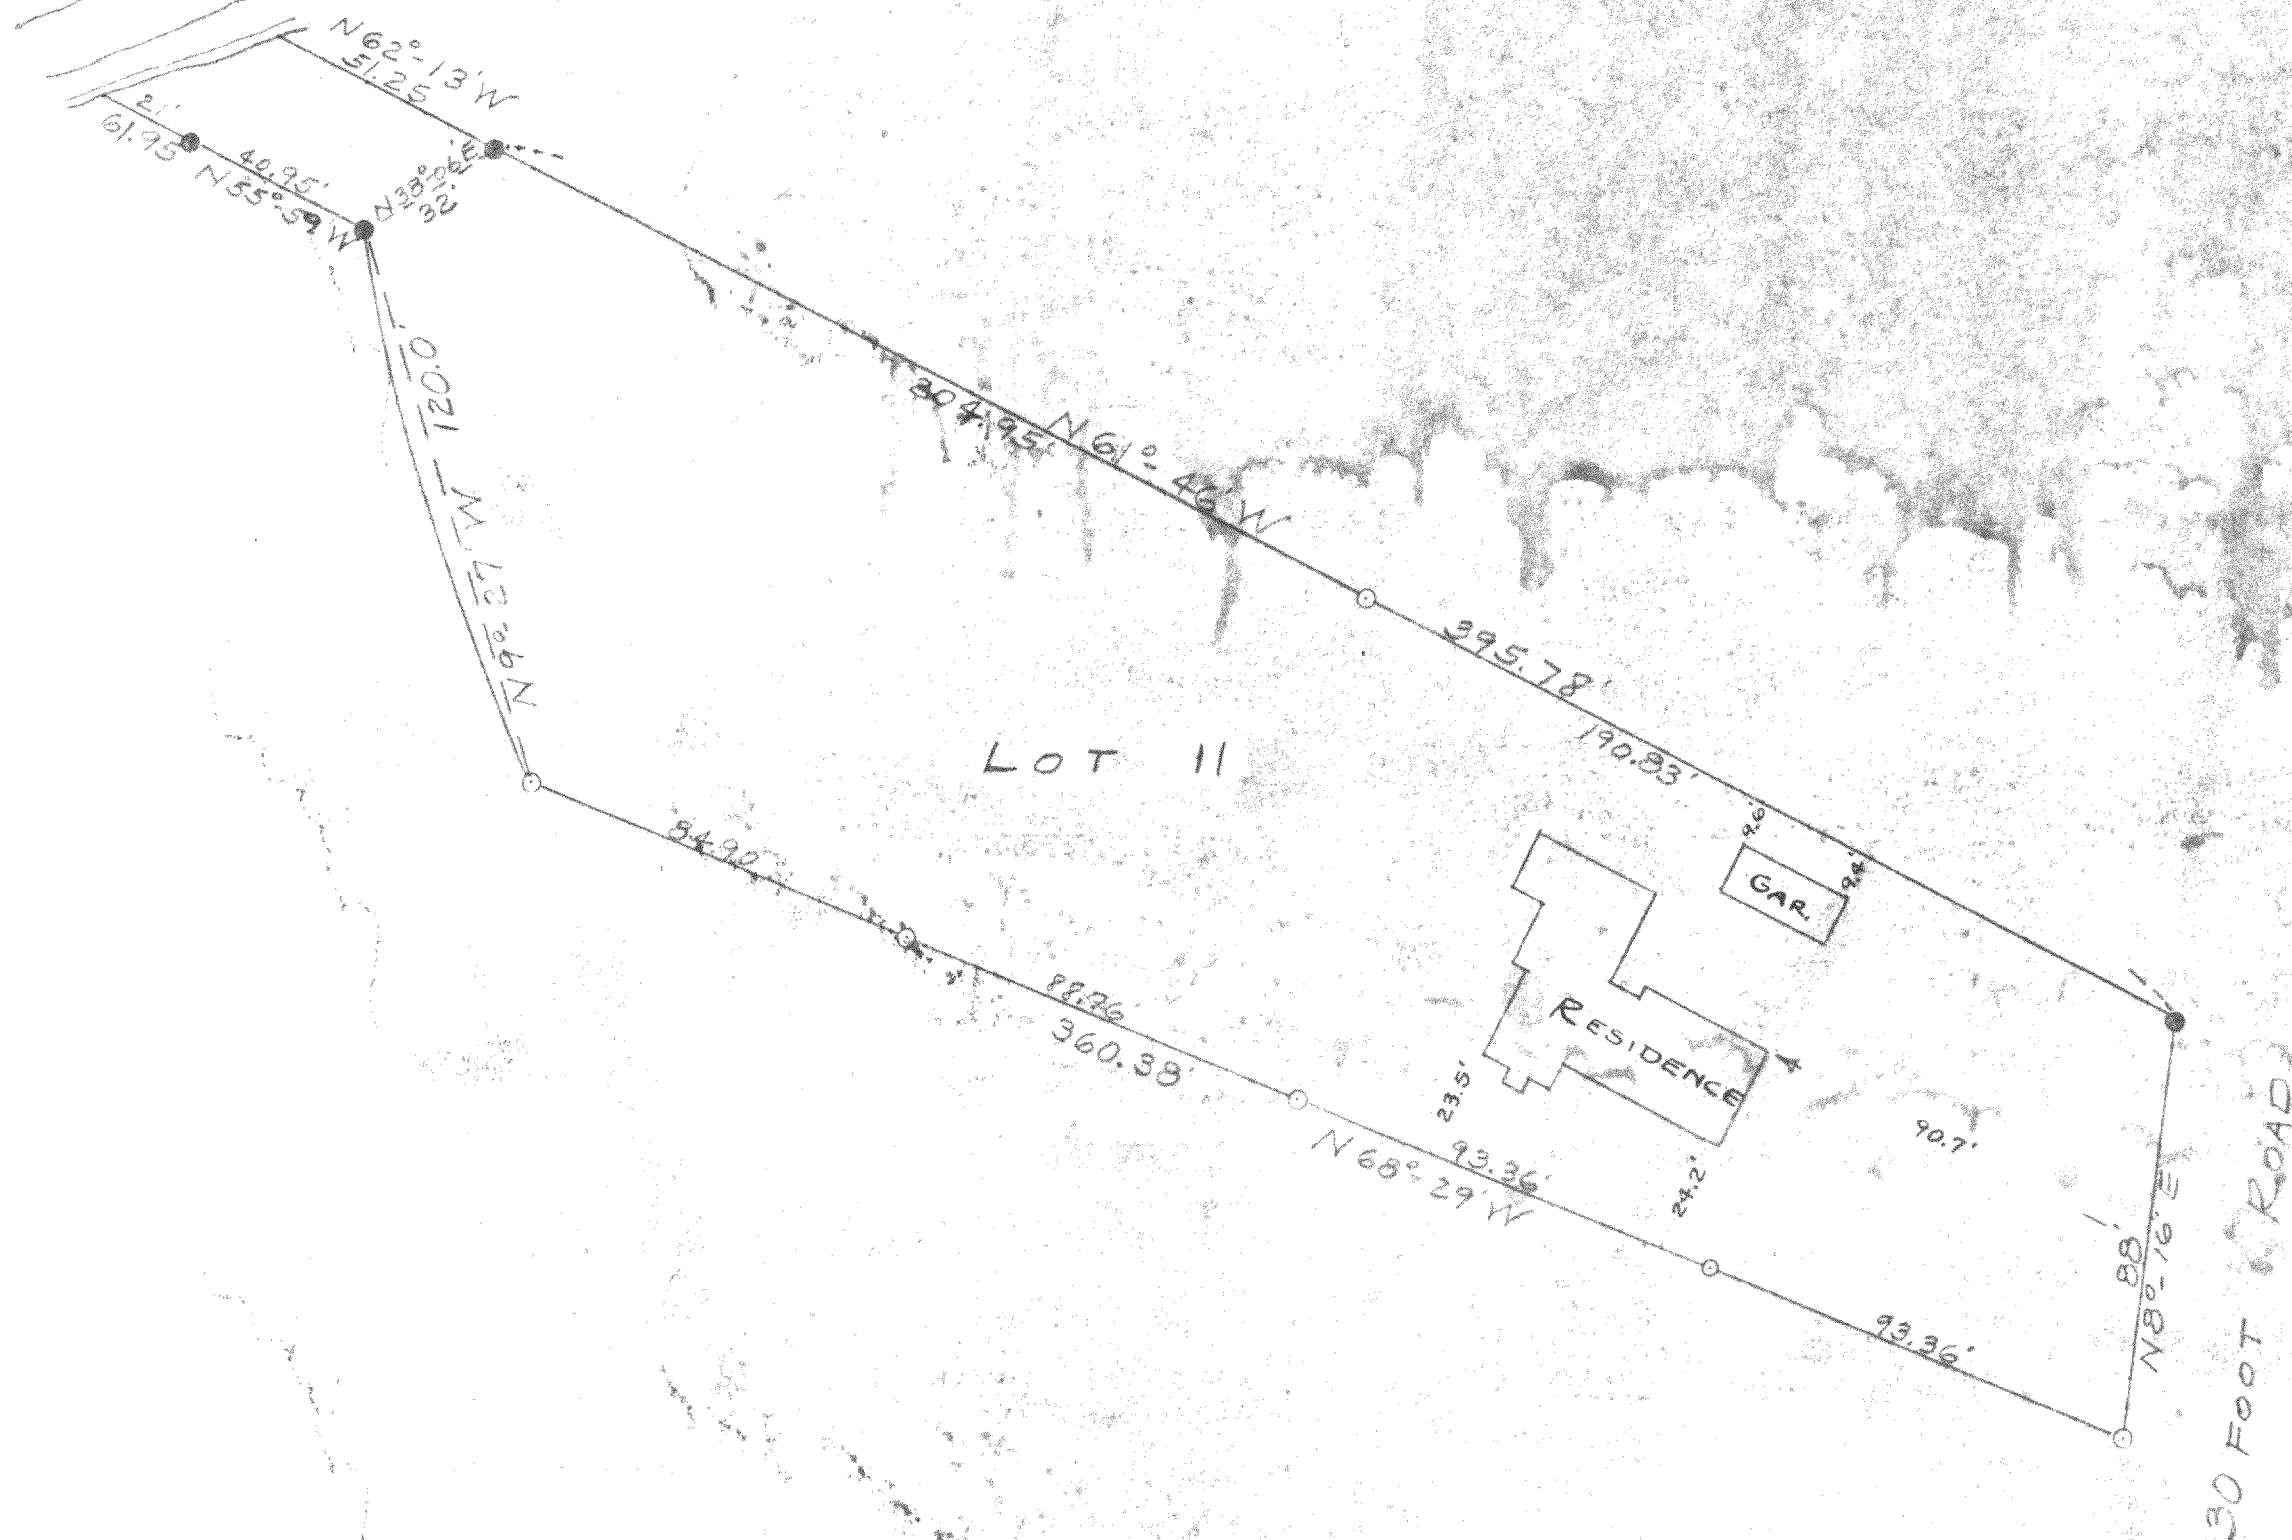

State of Wisconsin) ss
Walworth County)

I Lloyd L. Jensen, do hereby certify that I have surveyed the property described hereon according to the official records, and that the plat above is a correct representation of the lot lines and principal lines of buildings thereon.

JANUARY 1959

Lloyd L. Jensen
County Surveyor

PLAT OF SURVEY OF

LOT II OF THE BIRCHES
FIRST ADDITION TOWN
OF LINN, WALWORTH
COUNTY WISCONSIN.

Lloyd L. Jensen
SURVEYOR

SCALE 1" = 40'

DATE JAN 14 1959

IPA1-5B