


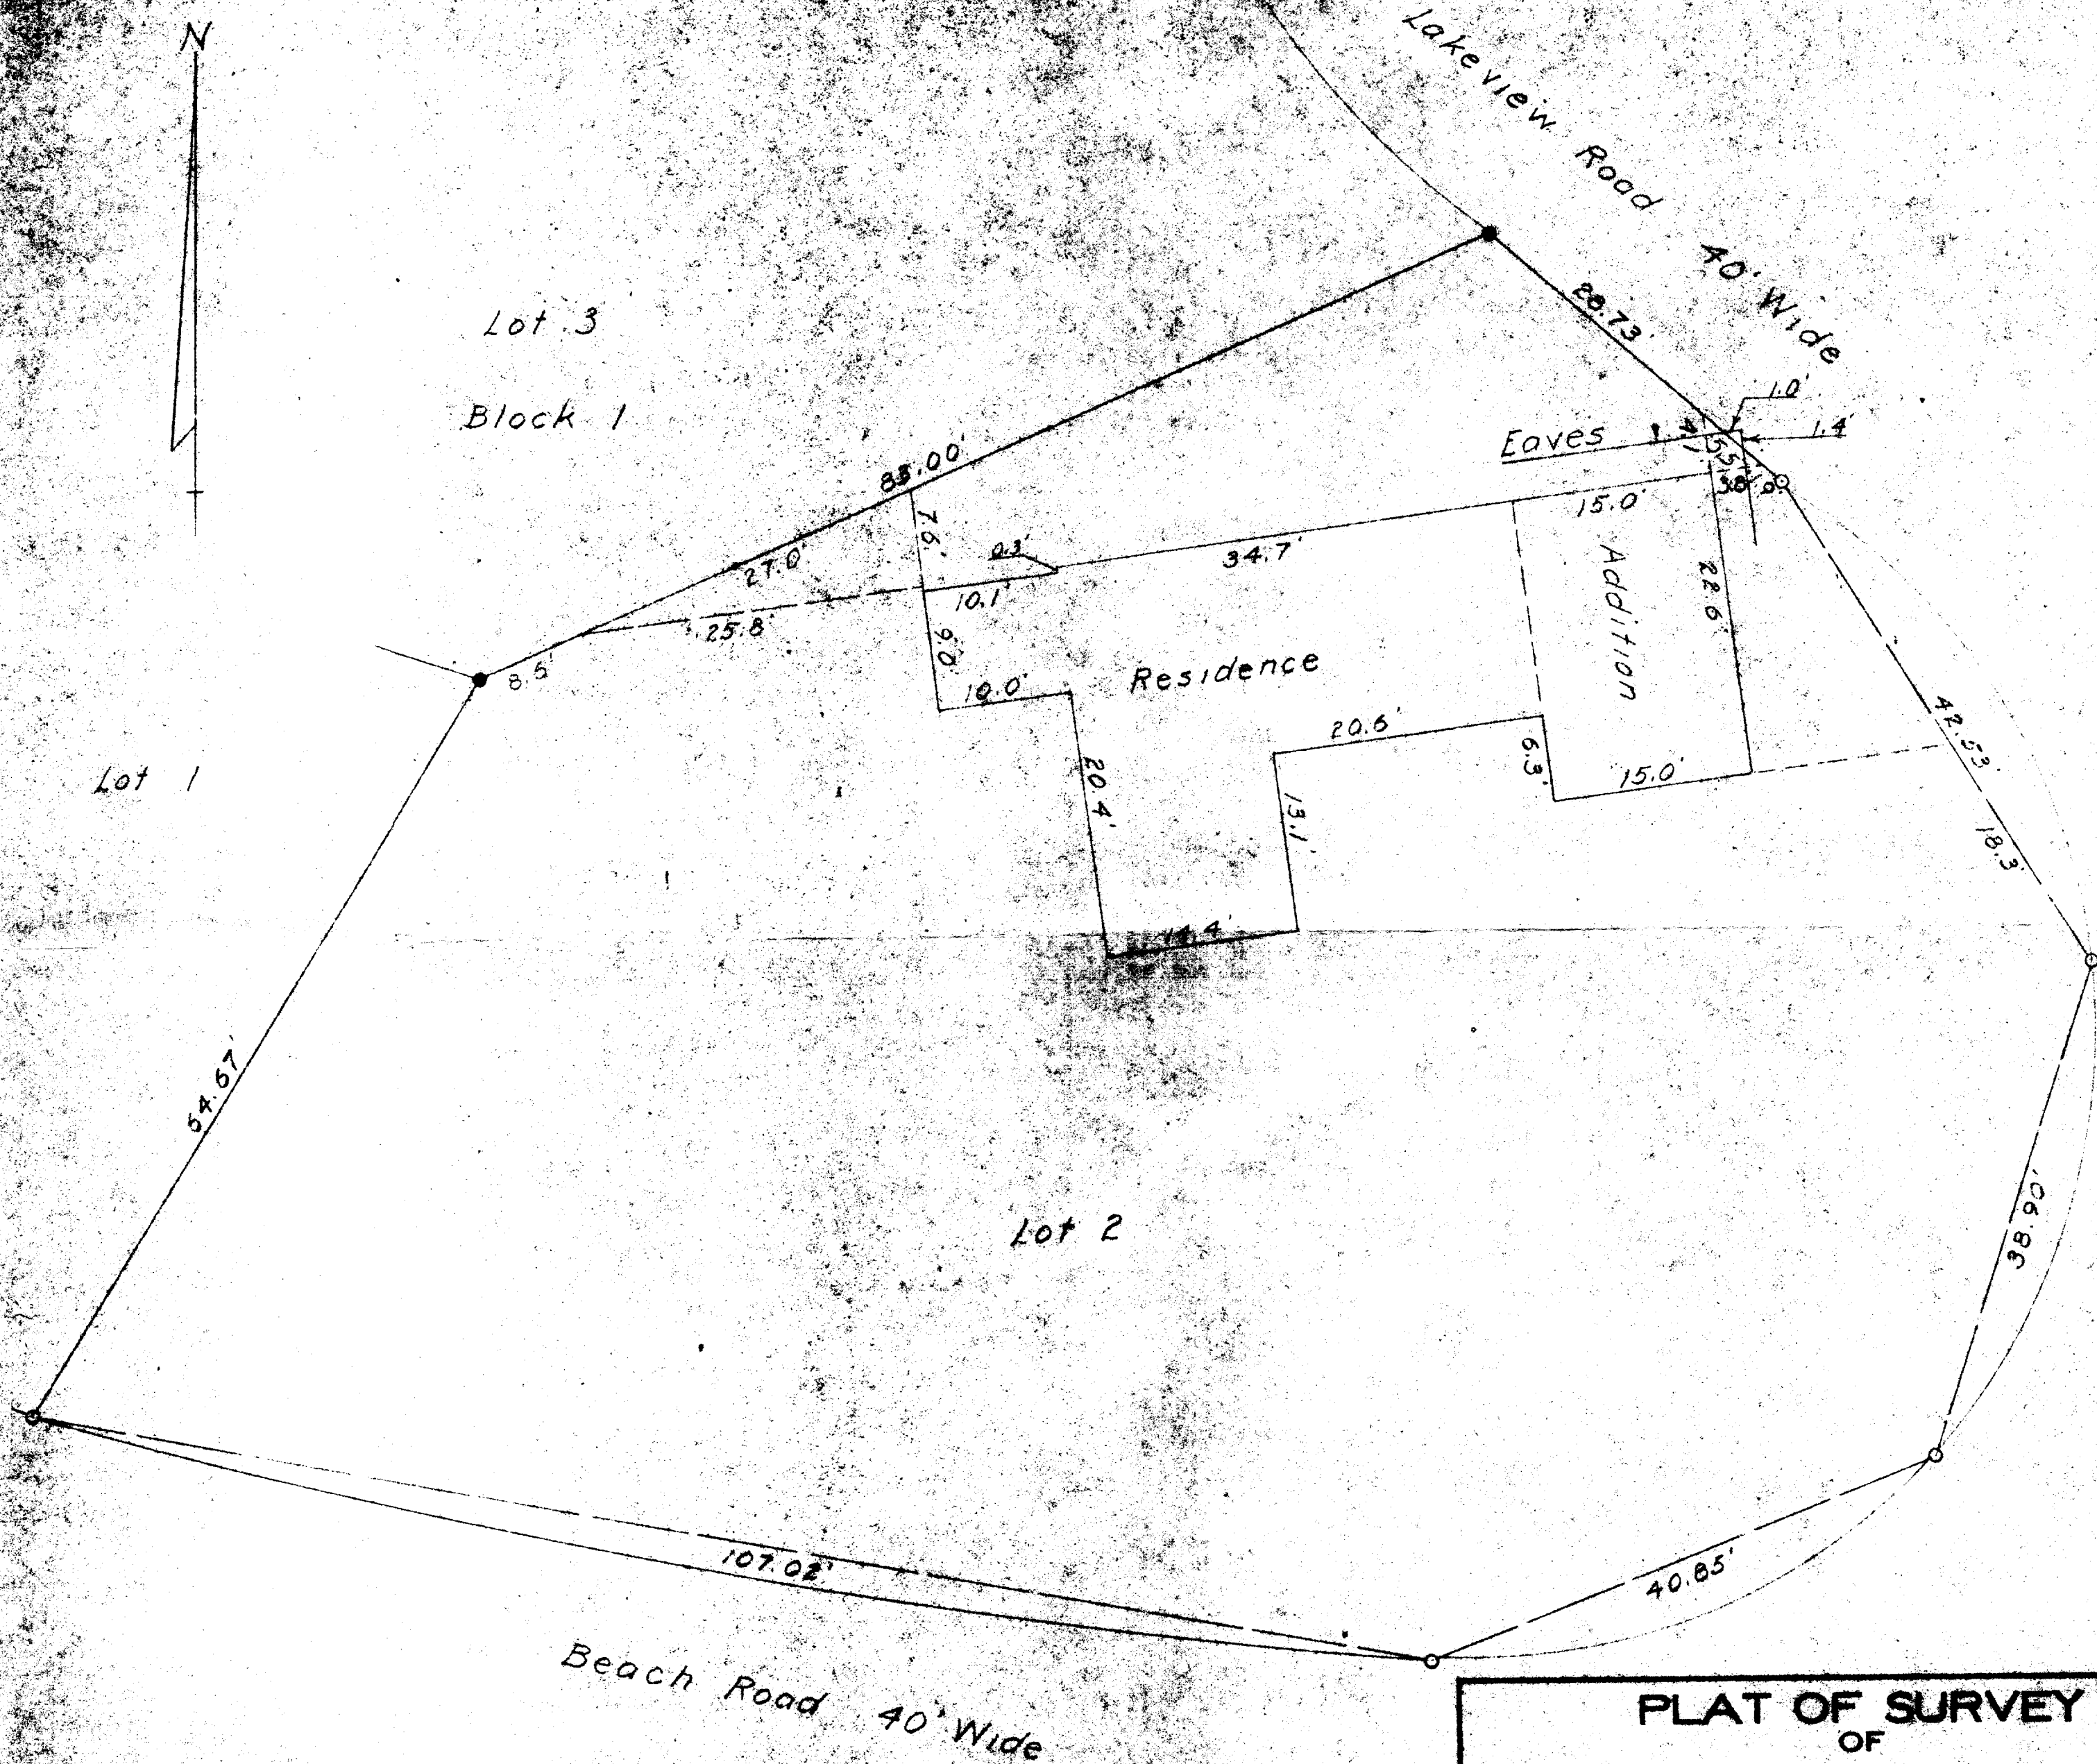

IW-2

o - Iron Pipe
 • - Concrete Monument

PLAT OF SURVEY
 OF
 Lot 2, Block 1, Wooddale Addition,
 Located in T1N, R17E, Walworth
 County, Wisconsin.

Floyd L. Jensen
 Surveyor

SCALE 1" = 10'

DATE July 1959