

ABERNATHY and ASSOCIATES

Kenneth B. Abernathy Jr.

Wisconsin Registered Land Surveyor S-1594

WA056 Bay Road
Elkhorn, Wisconsin 53121
Phone: (414) 723-4260 (office)
(414) 723-7209 (fax)


PLAT OF SURVEY

LOT 16 OF LAKE GENEVA HIGHLANDS
SUBDIVISION, LOCATED IN SECTION 8, TOWN 1
NORTH, RANGE 17 EAST, LINN TOWNSHIP,
WALNORTH COUNTY, WISCONSIN.

ORDERED BY: KARI SUE CLARK
OFFICE MANAGER
HOME DESIGN MANUFACTURING
POST OFFICE BOX 527
FONTANA, WISCONSIN
53125


OWNER: BARBARA BULMASH
764 BUNKER COURT
RIVERWOODS, ILL. 60015

NOTE:
THE ELEVATION OF GENEVA LAKE ON NOVEMBER 16, 1998 WAS 864.5'.
THE 100 YEAR FLOOD ELEVATION OF 865.0' FALLS IN THE RIP RAP ALONG
THE SHORE OF GENEVA LAKE.

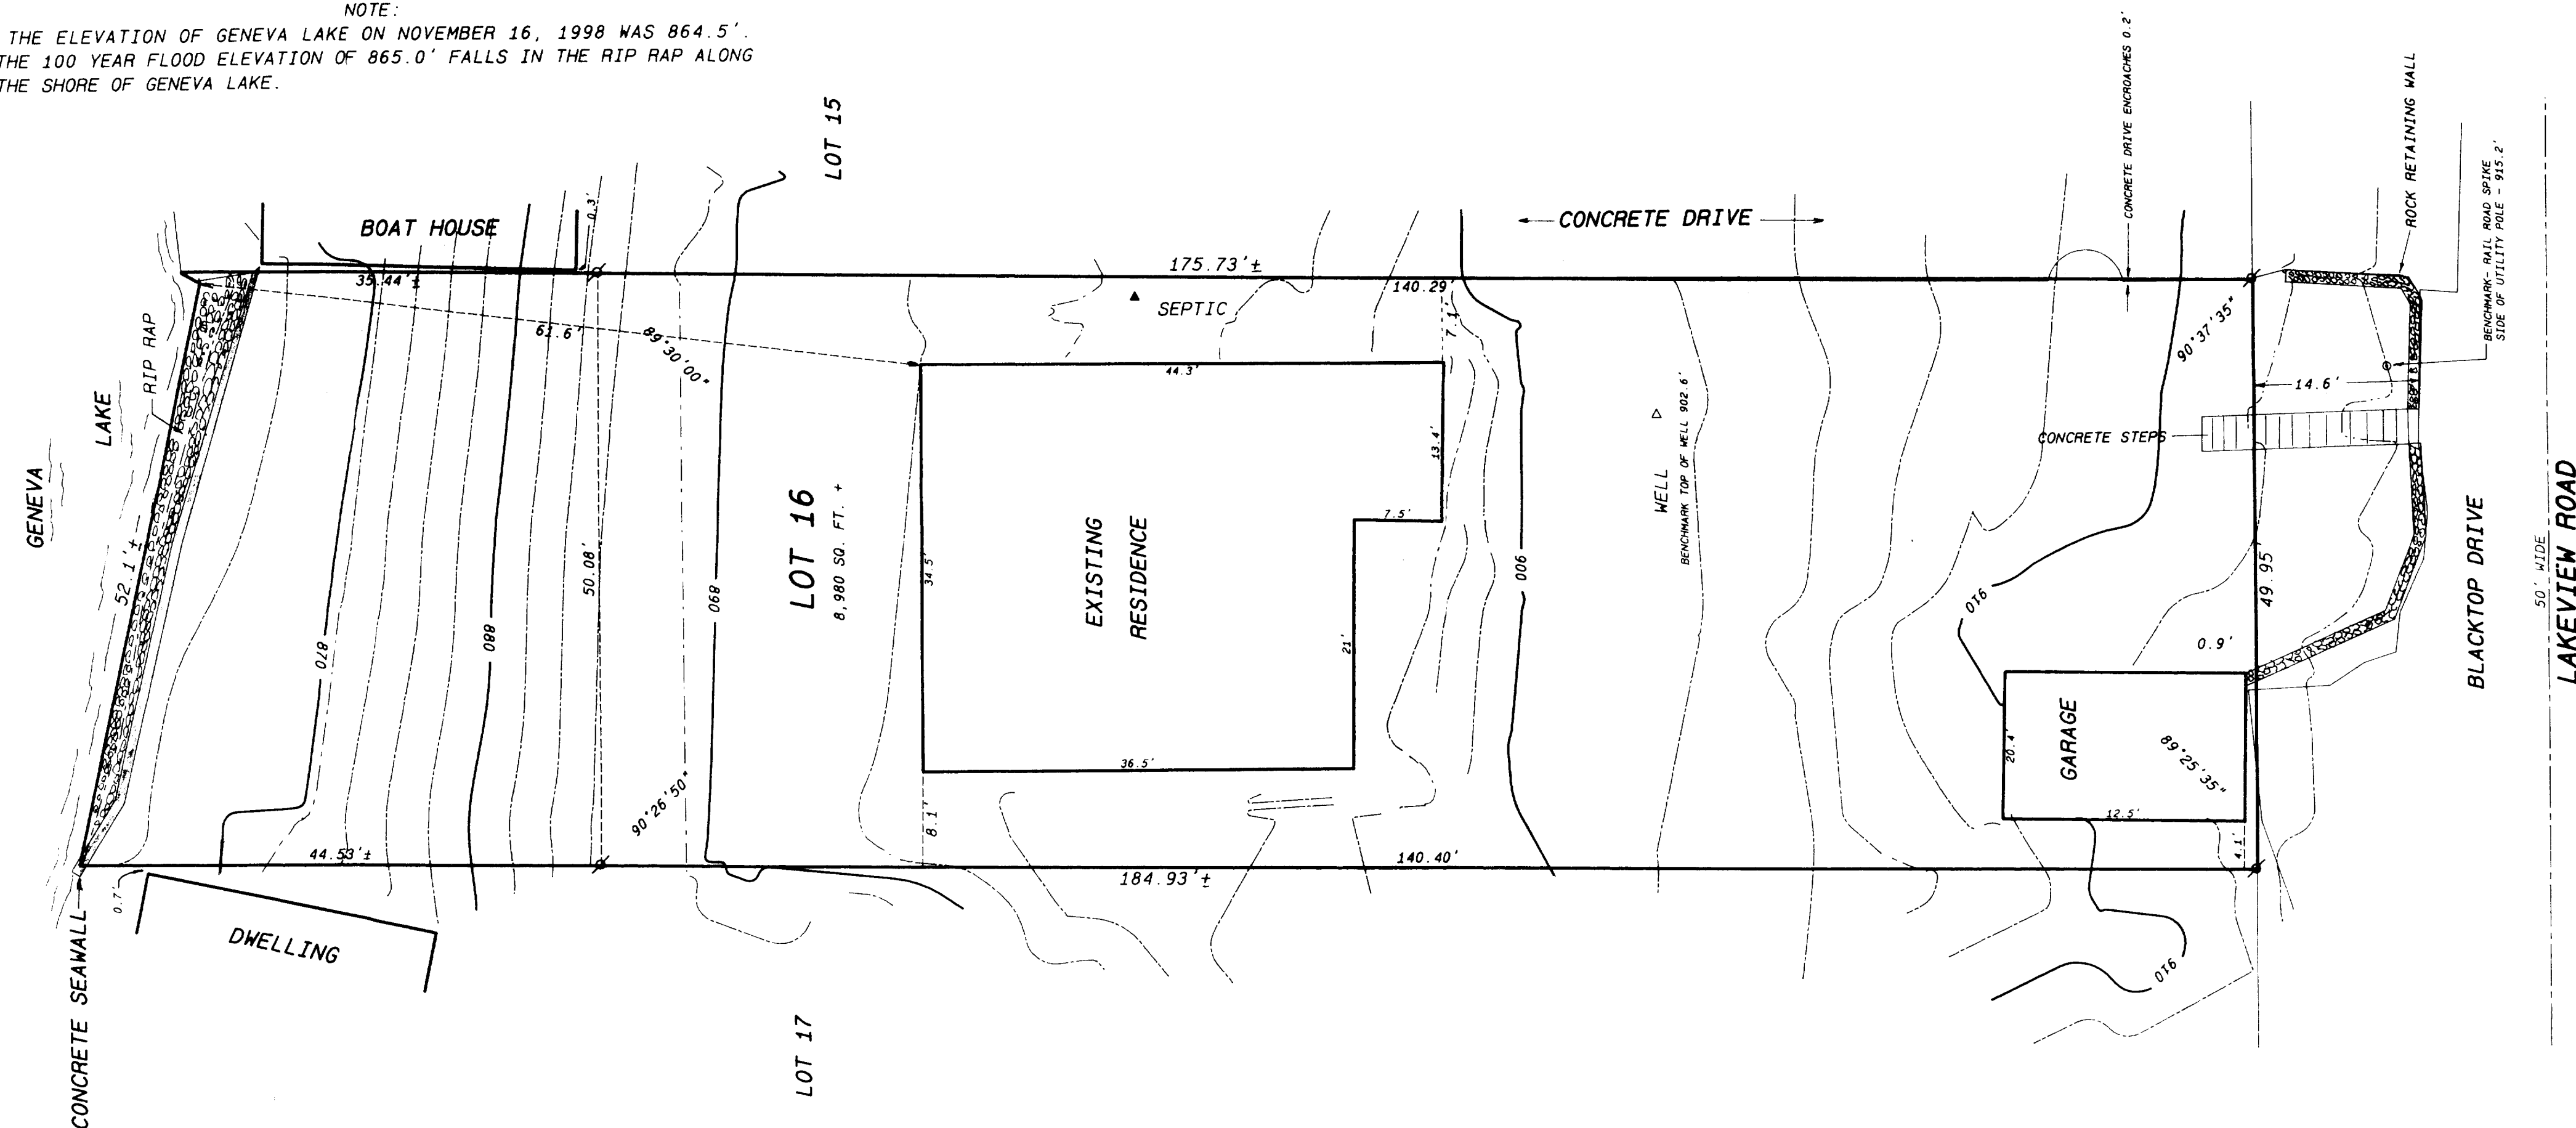


Legend

- FOUND IRON PIPE
- FOUND IRON ROD
- FOUND BRASS CAPPED MONUMENT
- FOUND CONCRETE MONUMENT
- CHISEL CUT IN CONCRETE
- SET IRON ROD, 24" LONG, WEIGHING 15 LBS. LINEAL FT., 3/4" DIA.
- SET IRON ROD, 18" LONG, WEIGHING 8 LBS. LINEAL FT., 1/2" DIA.
- RECORDED AS DIMENSION
- EXISTING FENCE

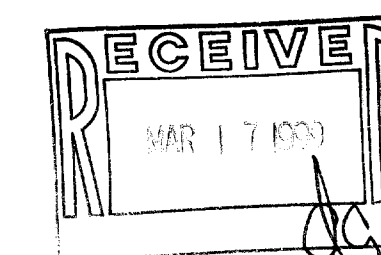

SCALE: 1" = 10 FEET

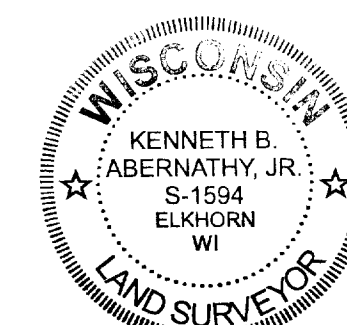

Kenneth B. Abernathy, Jr.
KENNETH B. ABERNATHY, JR.
WISCONSIN REGISTERED LAND SURVEYOR,
S-1594

Date: 11/25/98 Job No. 98-1107

ILGH-16
117-1784