


ABELL
SURVEYING & MAPPING
1140 SEQUOIA STREET • DELAVAN, WISCONSIN 53115
414-728-6737

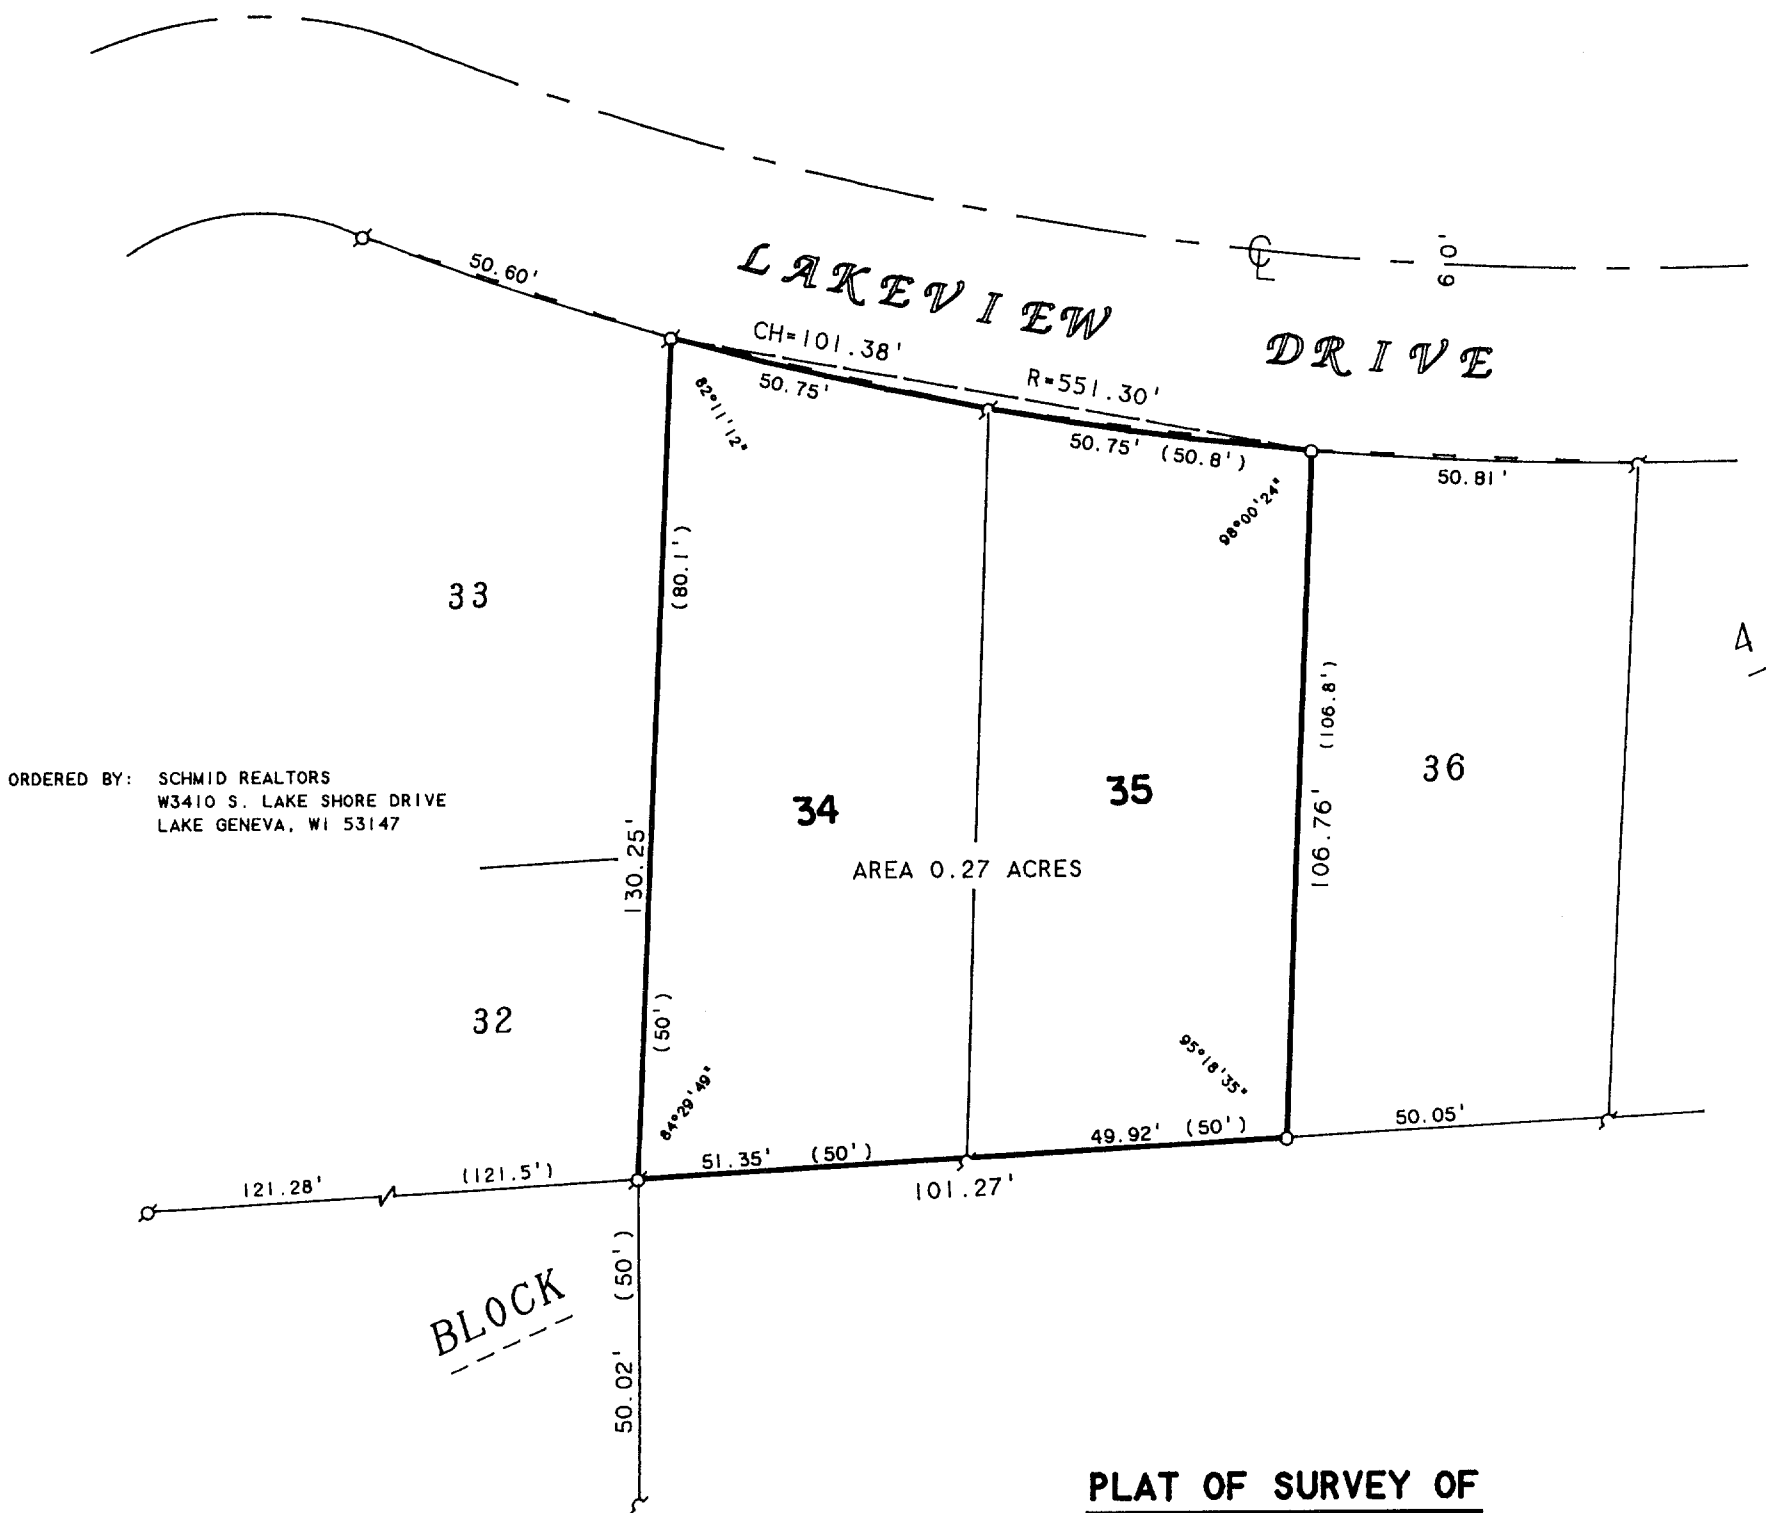

ORDERED BY: SCHMID REALTORS
W3410 S. LAKE SHORE DRIVE
LAKE GENEVA, WI 53147

PLAT OF SURVEY OF

LOTS 34-35, BLOCK 4 OF LAKE VIEW PARK, LOCATED
IN T1N. 17E, WALWORTH COUNTY, WISCONSIN.


N



SCALE 1"=30'

LEGEND

- Ø - IRON PIPE FOUND
- - IRON PIN FOUND, SET IRON PIPE
- ┌ - IRON PIN FOUND
- () - RECORDED AS

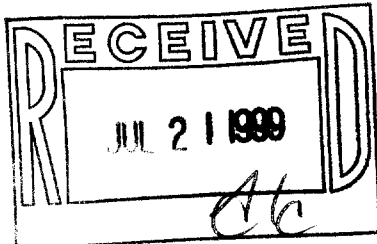

I HEREBY CERTIFY THAT I HAVE SURVEYED THE ABOVE DESCRIBED PROPERTY AND THAT THE ABOVE MAP IS A TRUE REPRESENTATION THEREOF AND SHOWS THE SIZE AND LOCATION OF THE PROPERTY, ITS EXTERIOR BOUNDARIES, THE LOCATION OF ALL VISIBLE STRUCTURES AND DIMENSIONS OF ALL PRINCIPAL BUILDINGS THEREON, BOUNDARY FENCES, APPARENT EASEMENTS, ROADWAYS AND VISIBLE ENCROACHMENTS, IF ANY, TO THE BEST OF MY KNOWLEDGE AND BELIEF.

THIS SURVEY IS MADE FOR THE USE OF THE PRESENT OWNERS OF THE PROPERTY, AND ALSO THOSE WHO PURCHASE, MORTGAGE, OR GUARANTEE THE TITLE THERETO WITHIN ONE (1) YEAR FROM DATE HEREON.

David F. Abell

DAVID F. ABELL
WISCONSIN REGISTERED LAND SURVEYOR, S-1596

April 28, 1999

DATE: April 28, 1999 JOB NUMBER - 91190C
NOTE: THIS IS NOT A CERTIFIED COPY UNLESS SEALED.

ILVP-196
117-1796