



PLAT OF SURVEY

PATHFINDER SURVEYING
FORMERLY KOLB LAND CONSULTING
929 WILLIAMS STREET LAKE GENEVA, WI. 53147
(414) 248-3697

ORDERED BY: ALLEN POLYOCK
P.O. BOX 43
ZENDA, WISCONSIN 53195

DATE: 4-20-1999

DESCRIPTION: LOTS 6 THRU 8, BLOCK 4 OF GENEVISTA,
A SUBDIVISION LOCATED IN SECTION 10,
T11N, R17E, WALWORTH COUNTY, WISCONSIN.

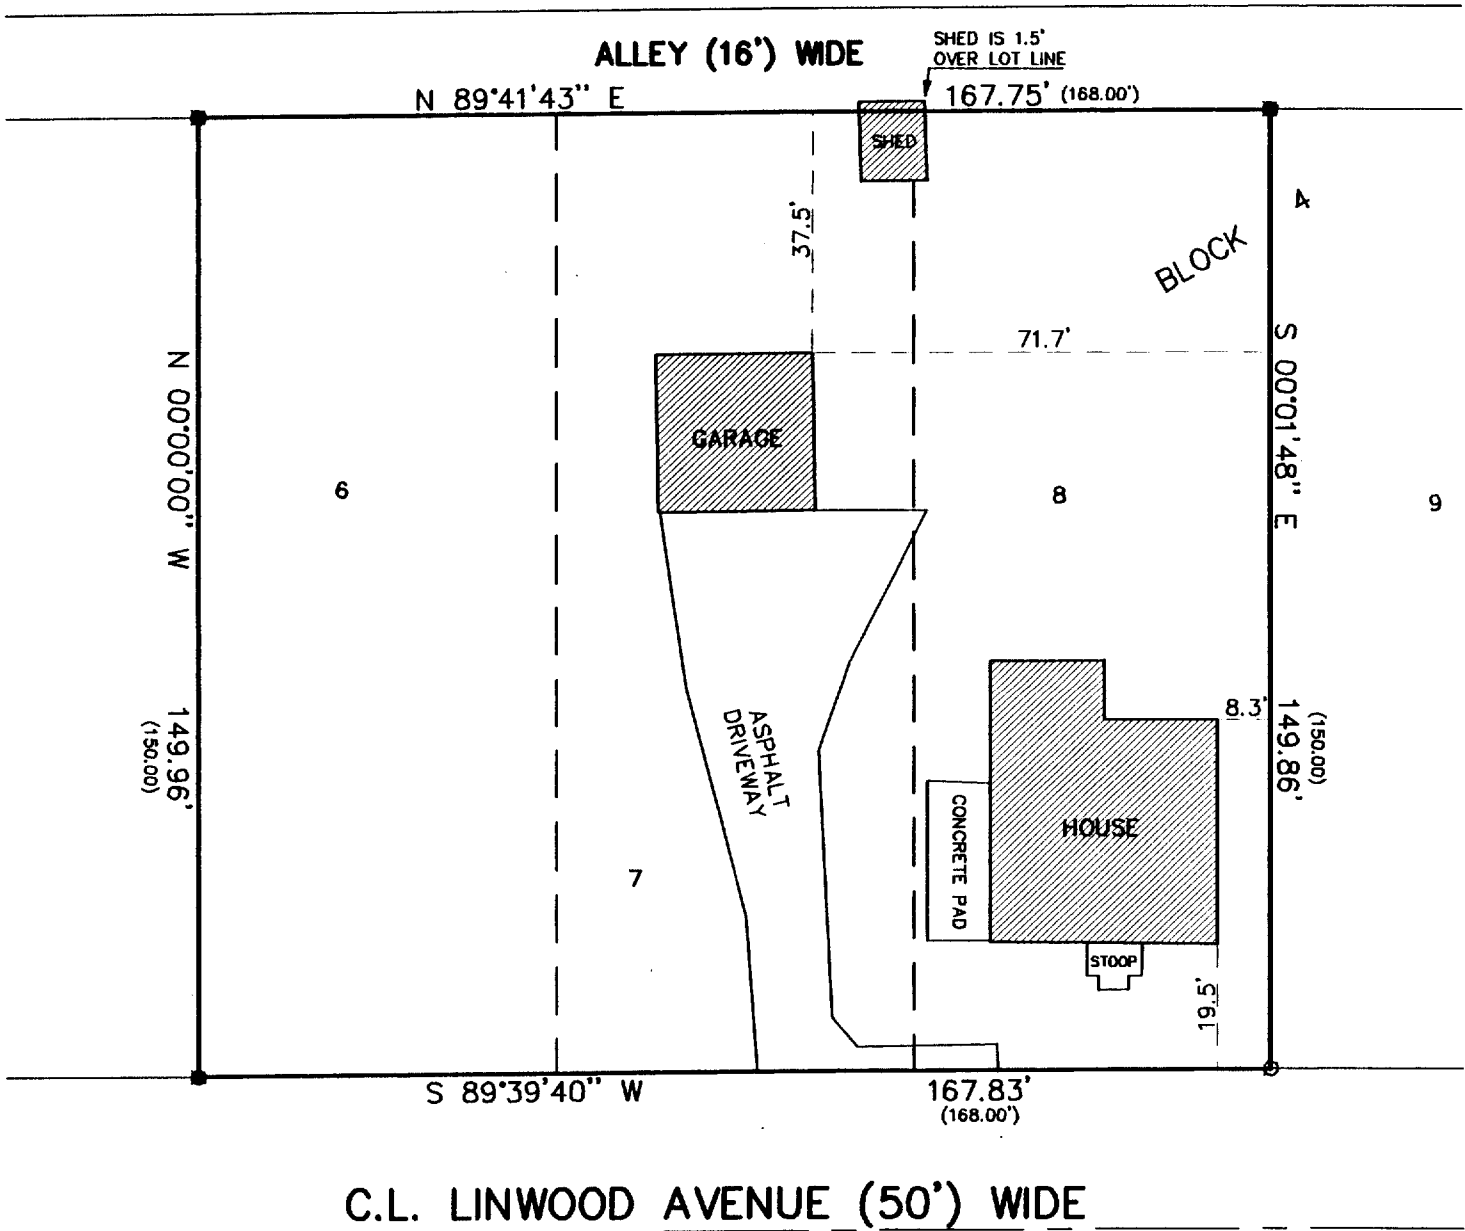
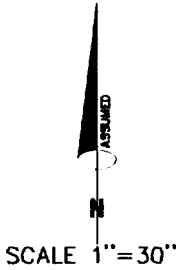


- LEGEND
- FOUND IRON PIPE
 - FOUND IRON PIN
 - (xxx) RECORDED AS

THE ABOVE MAP IS A TRUE REPRESENTATION THEREOF AND SHOWS THE SIZE AND LOCATION OF ALL THE PROPERTY, EXTERIOR BOUNDARIES, THE LOCATION OF ALL VISIBLE BOUNDARY FENCES, APPARENT EASEMENTS, ROADWAYS AND VISIBLE ENCROACHMENTS, IF ANY

THIS SURVEY IS MADE FOR THE USE OF THE PRESENT OWNERS OF THE PROPERTY, AND ALSO THOSE WHO PURCHASE, MORTGAGE OR GURANTEE TITLE THERETO WITHIN ONE (1) YEAR FROM DATE HERETO.

John P. Krott
JOHN P. KROTT, R.L.S. 2258

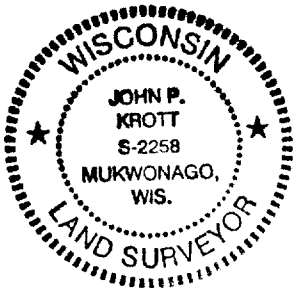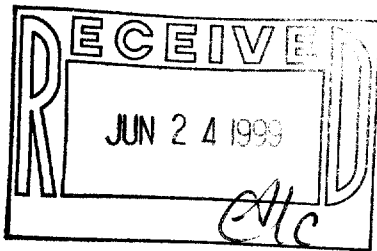

NOTE: THIS IS NOT A CERTIFIED COPY
UNLESS SEAL IS IN RED.
JOB NUMBER #99081 1-17 IGV 00015

117-1804 IGV-15