


LOCATION OF BONANNO PIER

PATHFINDER SURVEYING
FORMERLY KOLB LAND CONSULTING
929 WILLIAMS STREET LAKE GENEVA, WI. 53147
(414) 248-3697


ORDERED BY:
REED CONSTRUCTION
ROUTE 1, BOX 105
LAKE GENEVA, WI 53147

DATE: 6 / 23 / 1999

**PLAT SHOWING LOCATION OF PIER CRIB FOR
LOT B OF CERTIFIED SURVEY MAP NO. 22 A CERTIFIED SURVEY
MAP LOCATED IN LOT 4 AND PART OF LOT 5, S.B. CHAPINS
SUBDIVISION AND A PARCEL OF LAND LOCATED IN THE SOUTH
WEST 1/4 OF SECTION 4 , T.1.N. , R.17.E. ,WALWORTH COUNTY,
WISCONSIN.**

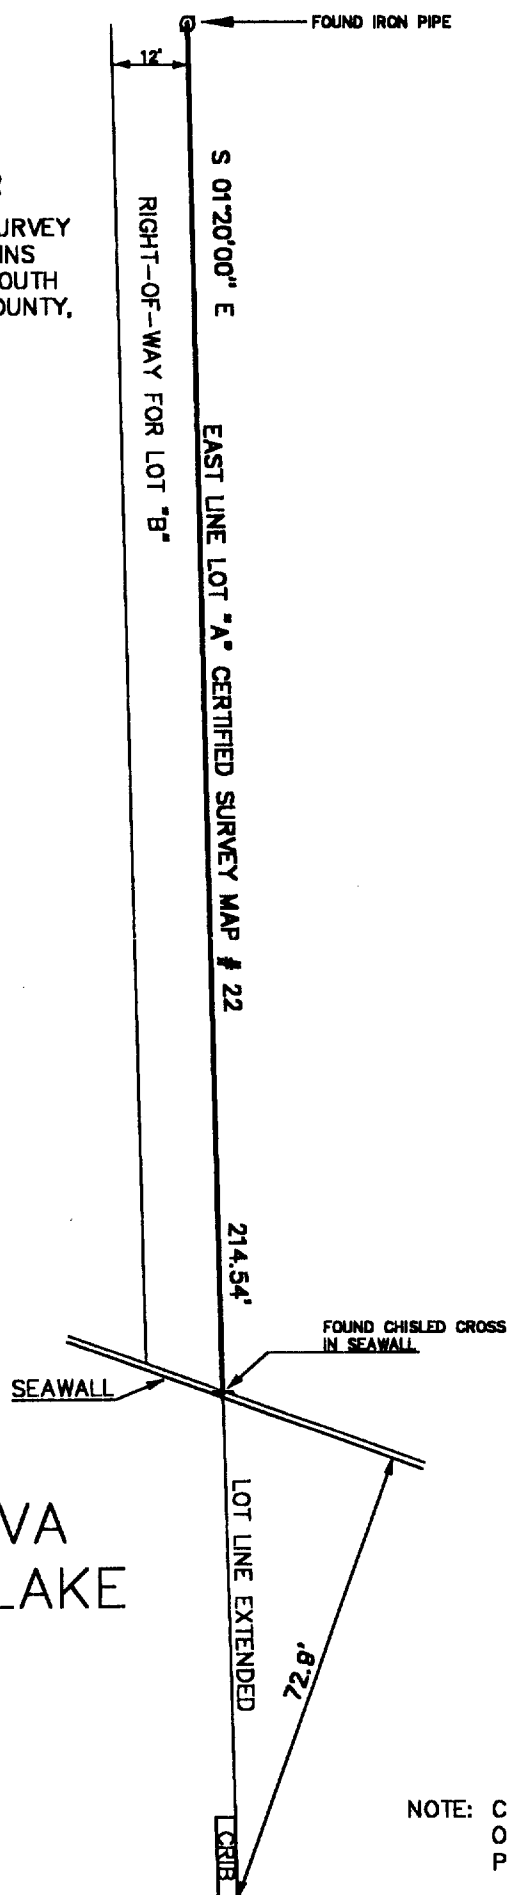


NOTE: CRIB FOR PIER PLACED
ON LOT LINE
PIER IS 78 FEET IN LENGTH

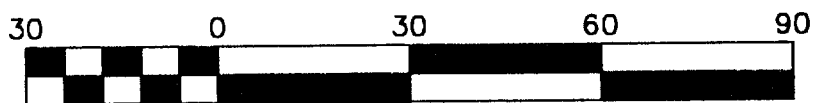

Scale 1" = 30'

BEARINGS REFERENCED TO CERTIFIED SURVEY MAP # 22

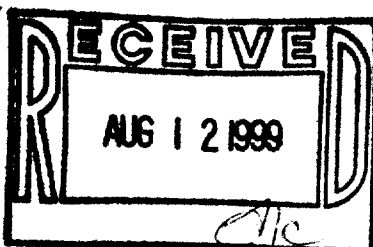

NOTE: THIS IS NOT A CERTIFIED COPY
UNLESS SEAL IS IN RED.

JOB NUMBER: 99133 1-17-1A2200002

John P. Krott
JOHN P. KROTT, R.L.S. 2258

71-92-2

177. 18/10