
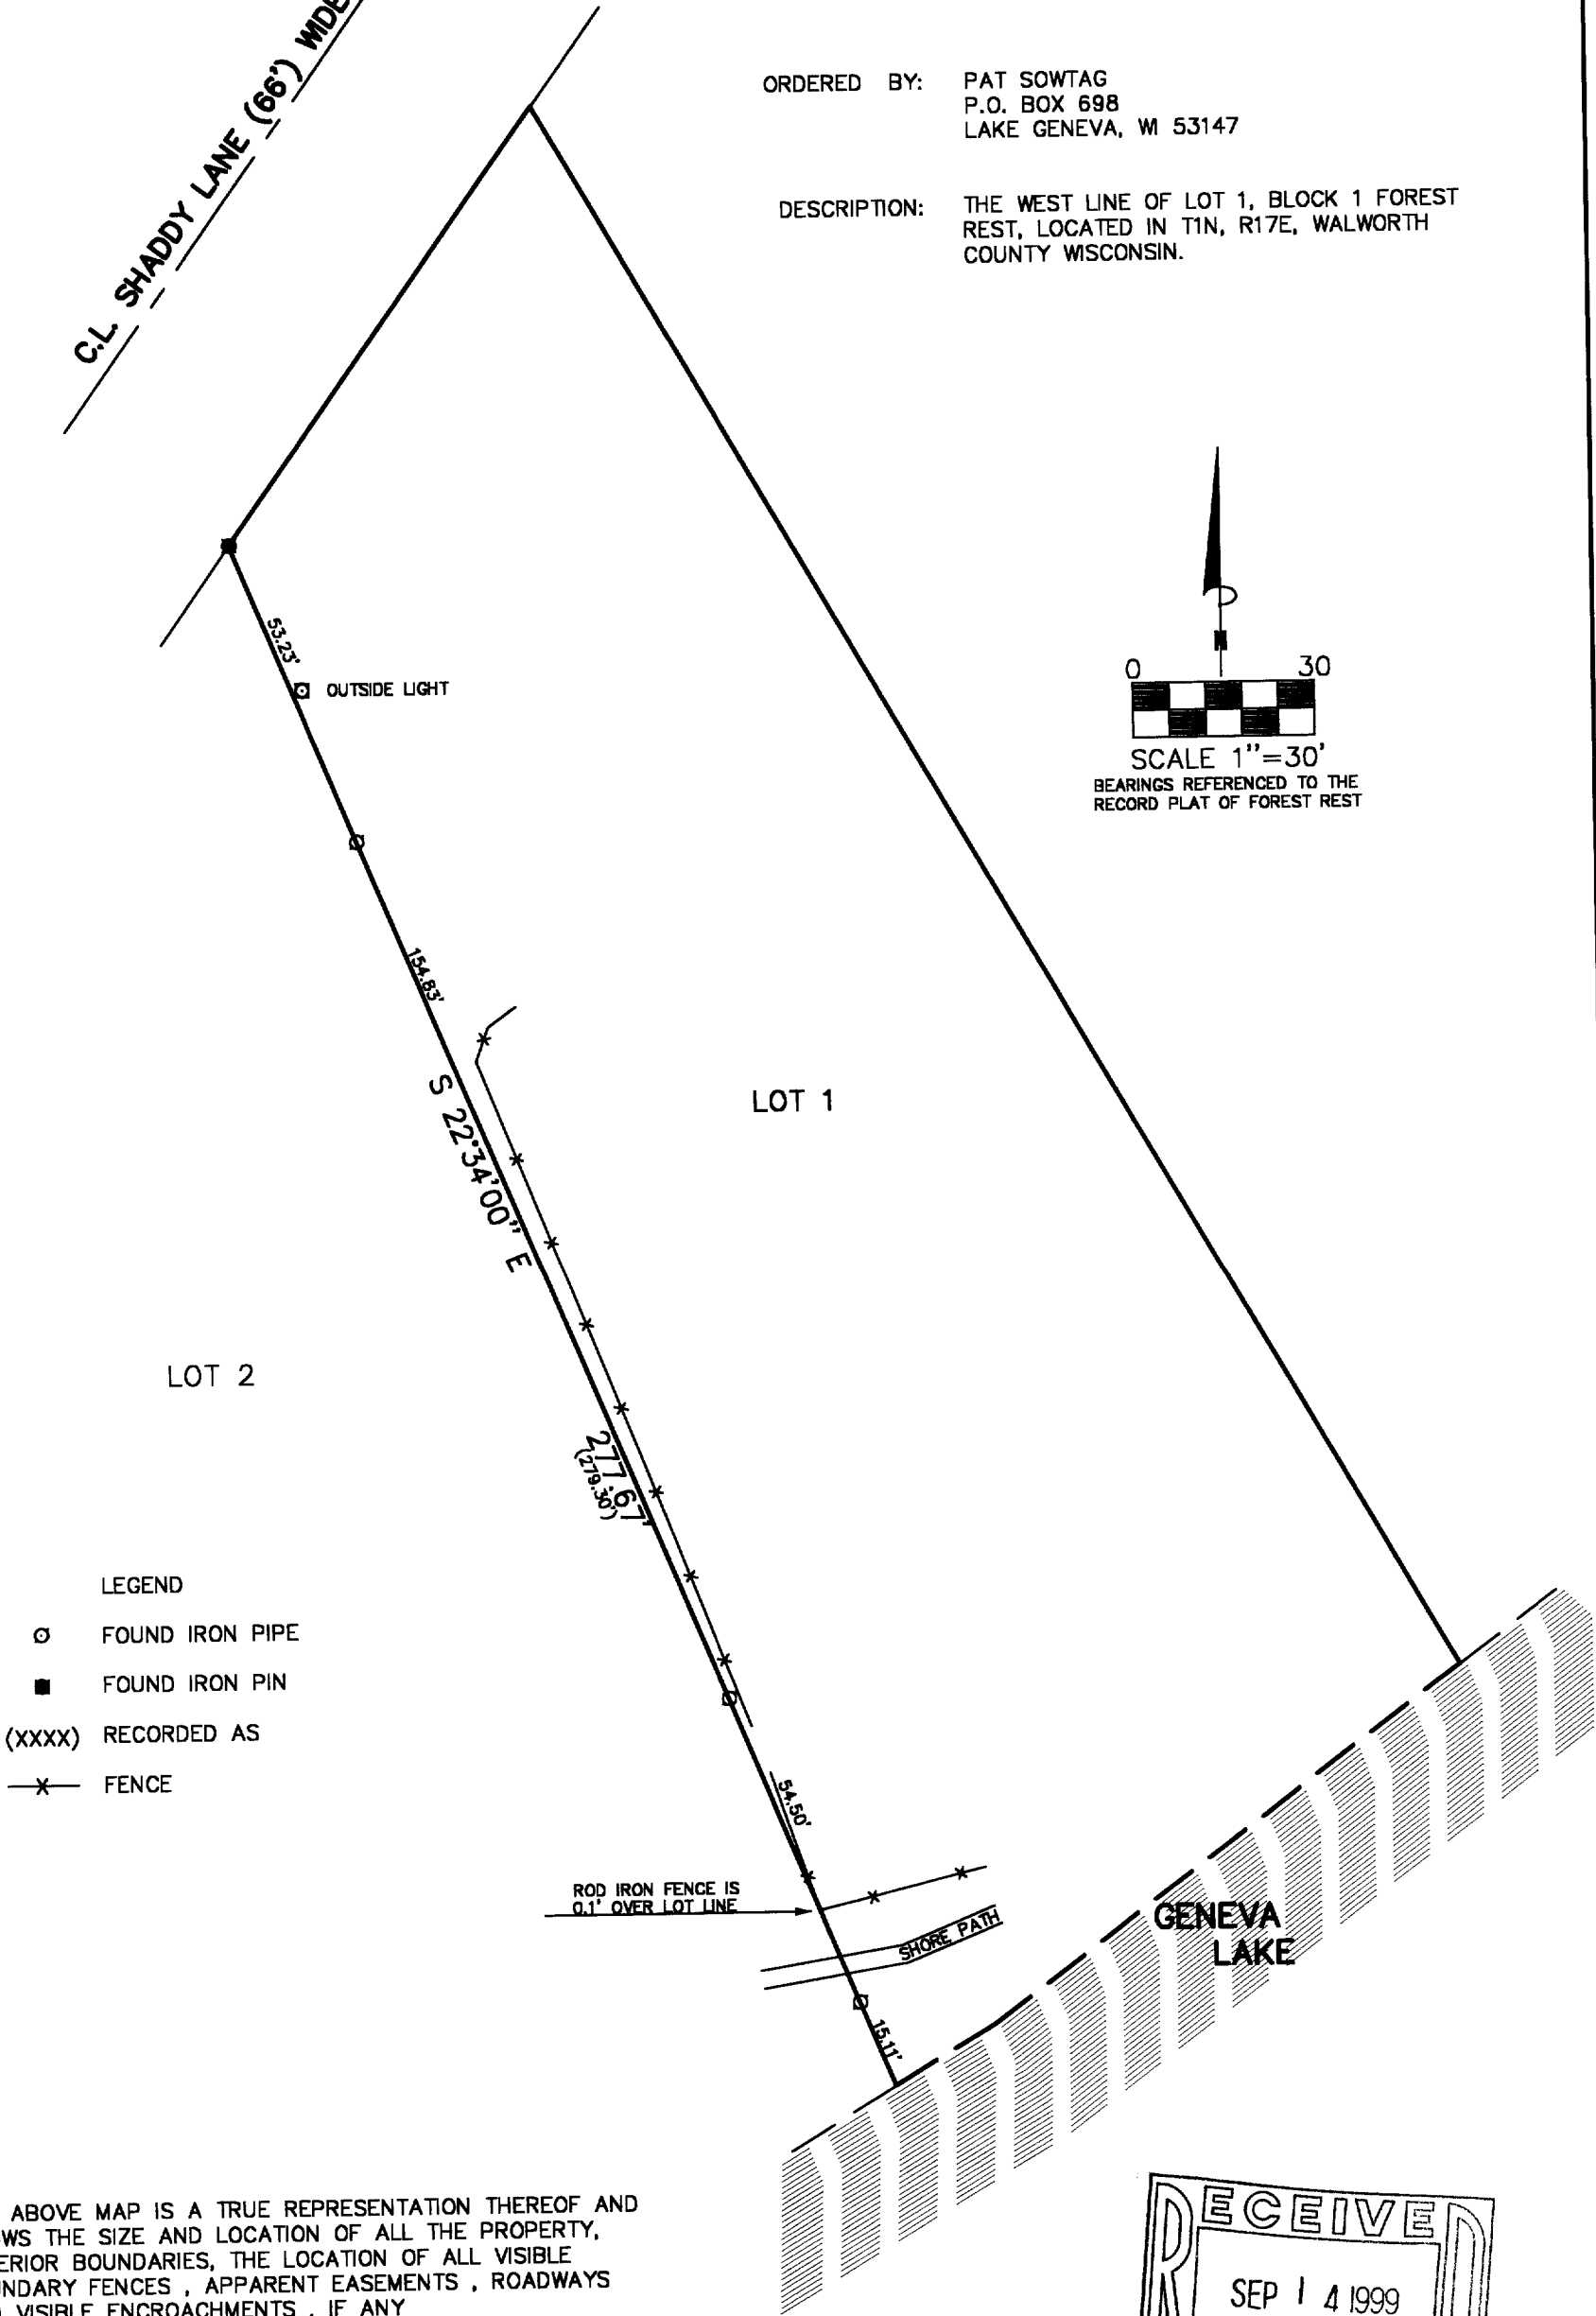


PLAT OF SURVEY

C.L. SHADY LANE (66') WIDE

ORDERED BY: PAT SOWTAG
P.O. BOX 698
LAKE GENEVA, WI 53147

DESCRIPTION: THE WEST LINE OF LOT 1, BLOCK 1 FOREST
REST, LOCATED IN T1N, R17E, WALWORTH
COUNTY WISCONSIN.

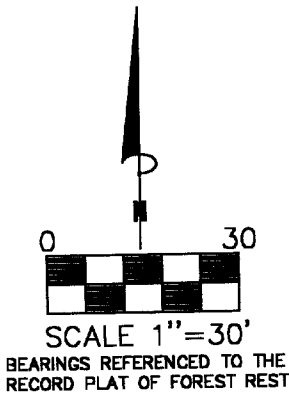


THE ABOVE MAP IS A TRUE REPRESENTATION THEREOF AND
SHOWS THE SIZE AND LOCATION OF ALL THE PROPERTY,
EXTERIOR BOUNDARIES, THE LOCATION OF ALL VISIBLE
BOUNDARY FENCES, APPARENT EASEMENTS, ROADWAYS
AND VISIBLE ENCROACHMENTS, IF ANY

THIS SURVEY IS MADE FOR THE USE OF THE PRESENT
OWNERS OF THE PROPERTY, AND ALSO THOSE WHO
PURCHASE, MORTGAGE OR GURANTEE TITLE THERETO
WITHIN ONE (1) YEAR FROM DATE HERETO.

DATE: 9-1-1999

PATHFINDER SURVEYING
FORMERLY KOLB LAND CONSULTING
929 WILLIAMS STREET LAKE GENEVA, WI. 53147
(414) 248-3697

JOHN P. KROTT, R.L.S. 2258

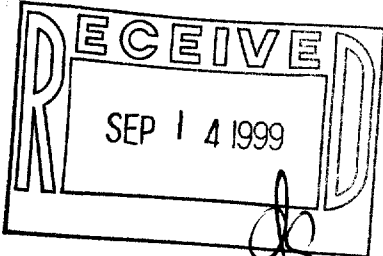

NOTE: THIS IS NOT A CERTIFIED COPY
UNLESS SEAL IS IN RED.

JOB NUMBER #99194 1-17-IRF 0001

IFR-1
117-1814