

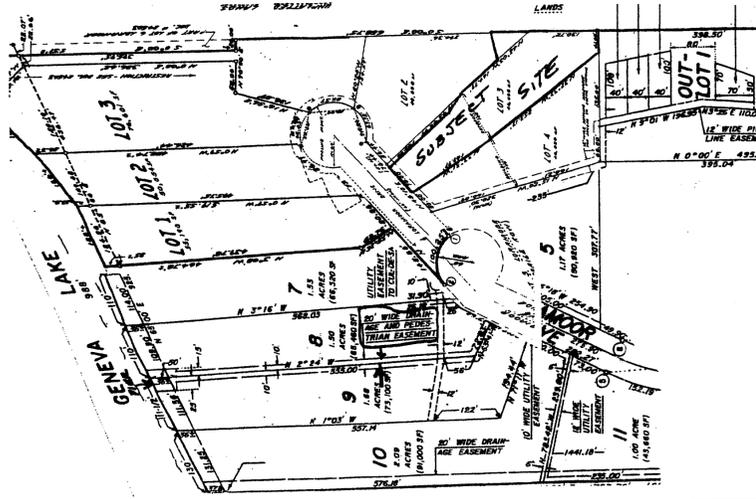


COMPOSITE PLANS SHOWING WALK EASEMENT TO SHORE

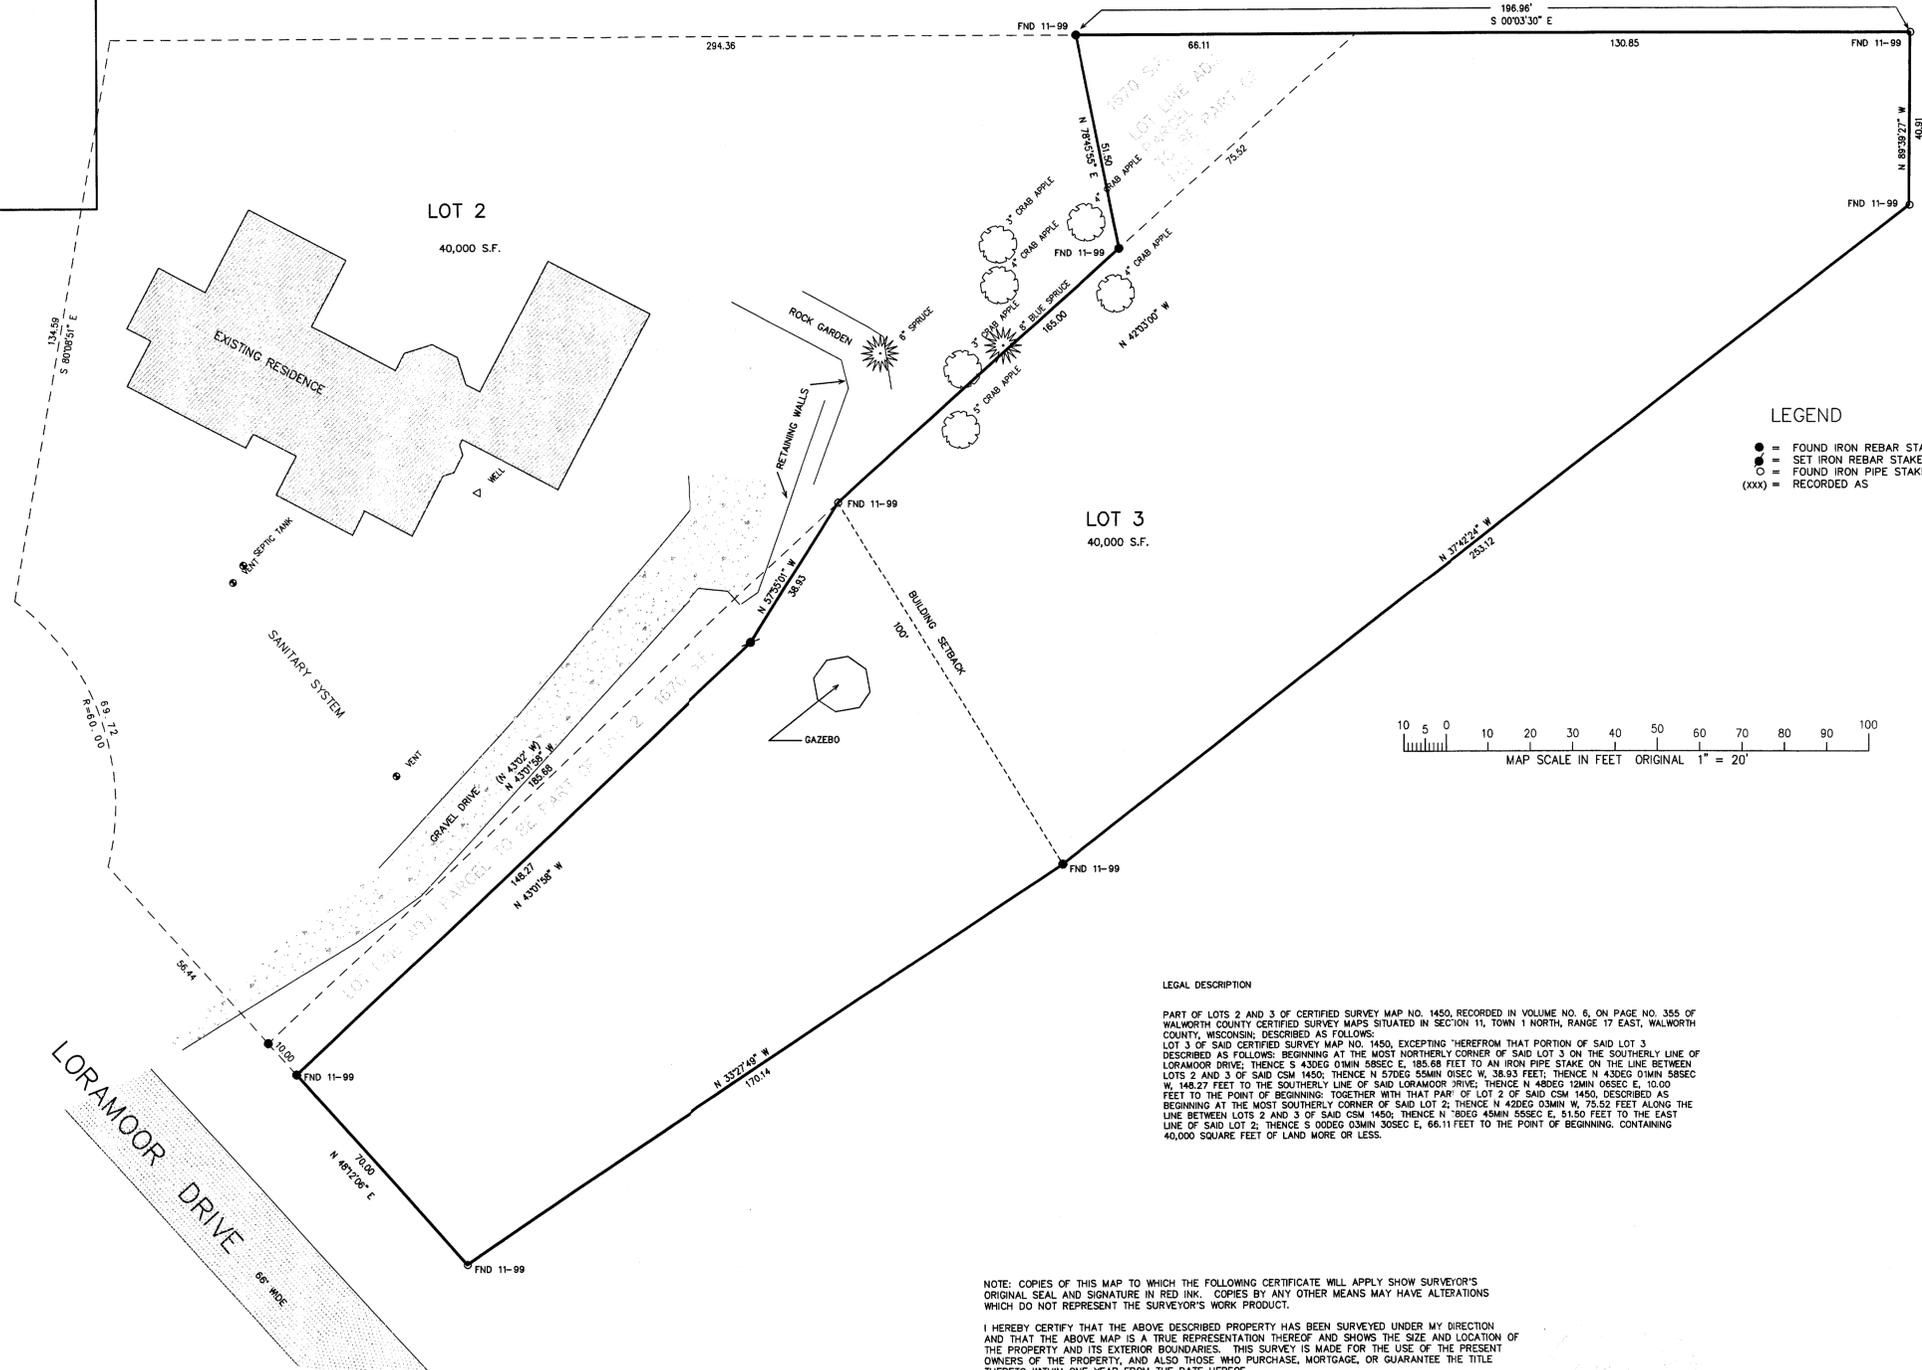


PLAT OF SURVEY

PART OF LOTS 2 & 3 OF CERTIFIED SURVEY MAP NO. 1450  
 REC. IN VOL. 6, ON PG. 355  
 TOWN OF LINN  
 WALWORTH COUNTY, WISCONSIN

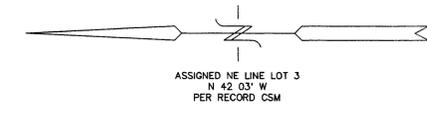

- LEGEND
- = FOUND IRON REBAR STAKE
  - = SET IRON REBAR STAKE
  - = FOUND IRON PIPE STAKE
  - (xxx) = RECORDED AS

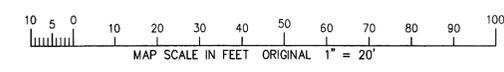

LEGAL DESCRIPTION

PART OF LOTS 2 AND 3 OF CERTIFIED SURVEY MAP NO. 1450, RECORDED IN VOLUME NO. 6, ON PAGE NO. 355 OF WALWORTH COUNTY CERTIFIED SURVEY MAPS SITUATED IN SECTION 11, TOWN 1 NORTH, RANGE 17 EAST, WALWORTH COUNTY, WISCONSIN; DESCRIBED AS FOLLOWS:



LOT 3 OF SAID CERTIFIED SURVEY MAP NO. 1450, EXCEPTING HEREFROM THAT PORTION OF SAID LOT 3 DESCRIBED AS FOLLOWS: BEGINNING AT THE MOST NORTHERLY CORNER OF SAID LOT 3 ON THE SOUTHERLY LINE OF LORAMOOR DRIVE; THENCE S 43DEG 0'31MIN 58SEC E, 185.88 FEET TO AN IRON PIPE STAKE ON THE LINE BETWEEN LOTS 2 AND 3 OF SAID CSM 1450; THENCE N 57DEG 55MIN 01SEC W, 38.83 FEET; THENCE N 43DEG 0'31MIN 58SEC W, 148.27 FEET TO THE SOUTHERLY LINE OF SAID LORAMOOR DRIVE; THENCE N 48DEG 12MIN 06SEC E, 10.00 FEET TO THE POINT OF BEGINNING; TOGETHER WITH THAT PART OF LOT 2 OF SAID CSM 1450, DESCRIBED AS BEGINNING AT THE MOST SOUTHERLY CORNER OF SAID LOT 2; THENCE N 42DEG 0'31MIN W, 75.52 FEET ALONG THE LINE BETWEEN LOTS 2 AND 3 OF SAID CSM 1450; THENCE N 70DEG 45MIN 45SEC E, 151.50 FEET TO THE EAST LINE OF SAID LOT 2; THENCE S 00DEG 0'31MIN 30SEC E, 66.11 FEET TO THE POINT OF BEGINNING, CONTAINING 40,000 SQUARE FEET OF LAND MORE OR LESS.

NOTE: COPIES OF THIS MAP TO WHICH THE FOLLOWING CERTIFICATE WILL APPLY SHOW SURVEYOR'S ORIGINAL SEAL AND SIGNATURE IN RED INK. COPIES BY ANY OTHER MEANS MAY HAVE ALTERATIONS WHICH DO NOT REPRESENT THE SURVEYOR'S WORK PRODUCT.

I HEREBY CERTIFY THAT THE ABOVE DESCRIBED PROPERTY HAS BEEN SURVEYED UNDER MY DIRECTION AND THAT THE ABOVE MAP IS A TRUE REPRESENTATION THEREOF AND SHOWS THE SIZE AND LOCATION OF THE PROPERTY AND ITS EXTERIOR BOUNDARIES. THIS SURVEY IS MADE FOR THE USE OF THE PRESENT OWNERS OF THE PROPERTY, AND ALSO THOSE WHO PURCHASE, MORTGAGE, OR GUARANTEE THE TITLE THERETO WITHIN ONE YEAR FROM THE DATE HEREOF.

DATED: 11-18-99

*Peter S. Gordon*  
 PETER S. GORDON R.L.S. 2101

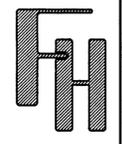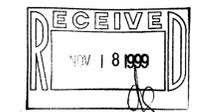

WORK ORDERED BY: EVELYN SHERIDAN  
 N 1922 LORAMOOR DRIVE  
 LAKE GENEVA, WI. 53147

FARRIS, HANSEN & ASSOCIATES, INC.  
 Engineering, Architecture, Surveying  
 7 Ridgeway Court P.O. Box 437  
 ELKHORN, WISCONSIN 53121  
 Office: (414) 723-2098  
 Fax: (414) 723-5886

REVISIONS

NO.	DATE	DESCRIPTION

PROJECT NO.  
2267.3

DATE  
11-03-98

SHEET NO.  
1 OF 1

JA-1450-2  
 JA-1450-3  
 117-1834