
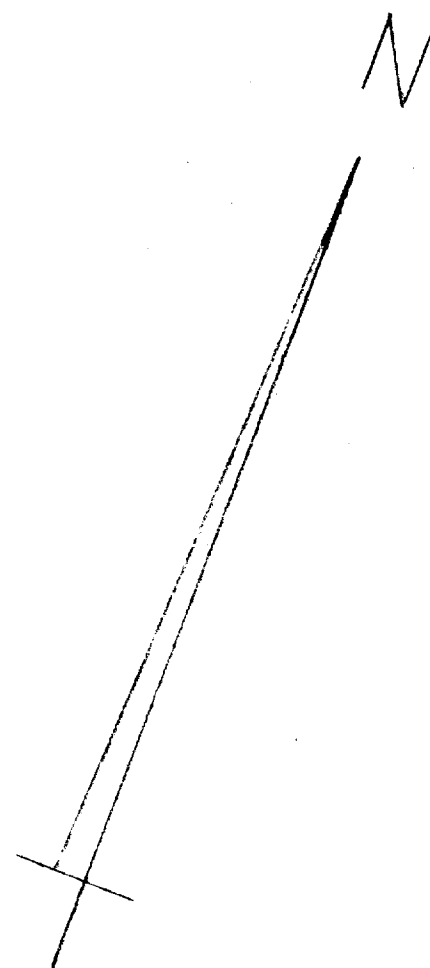


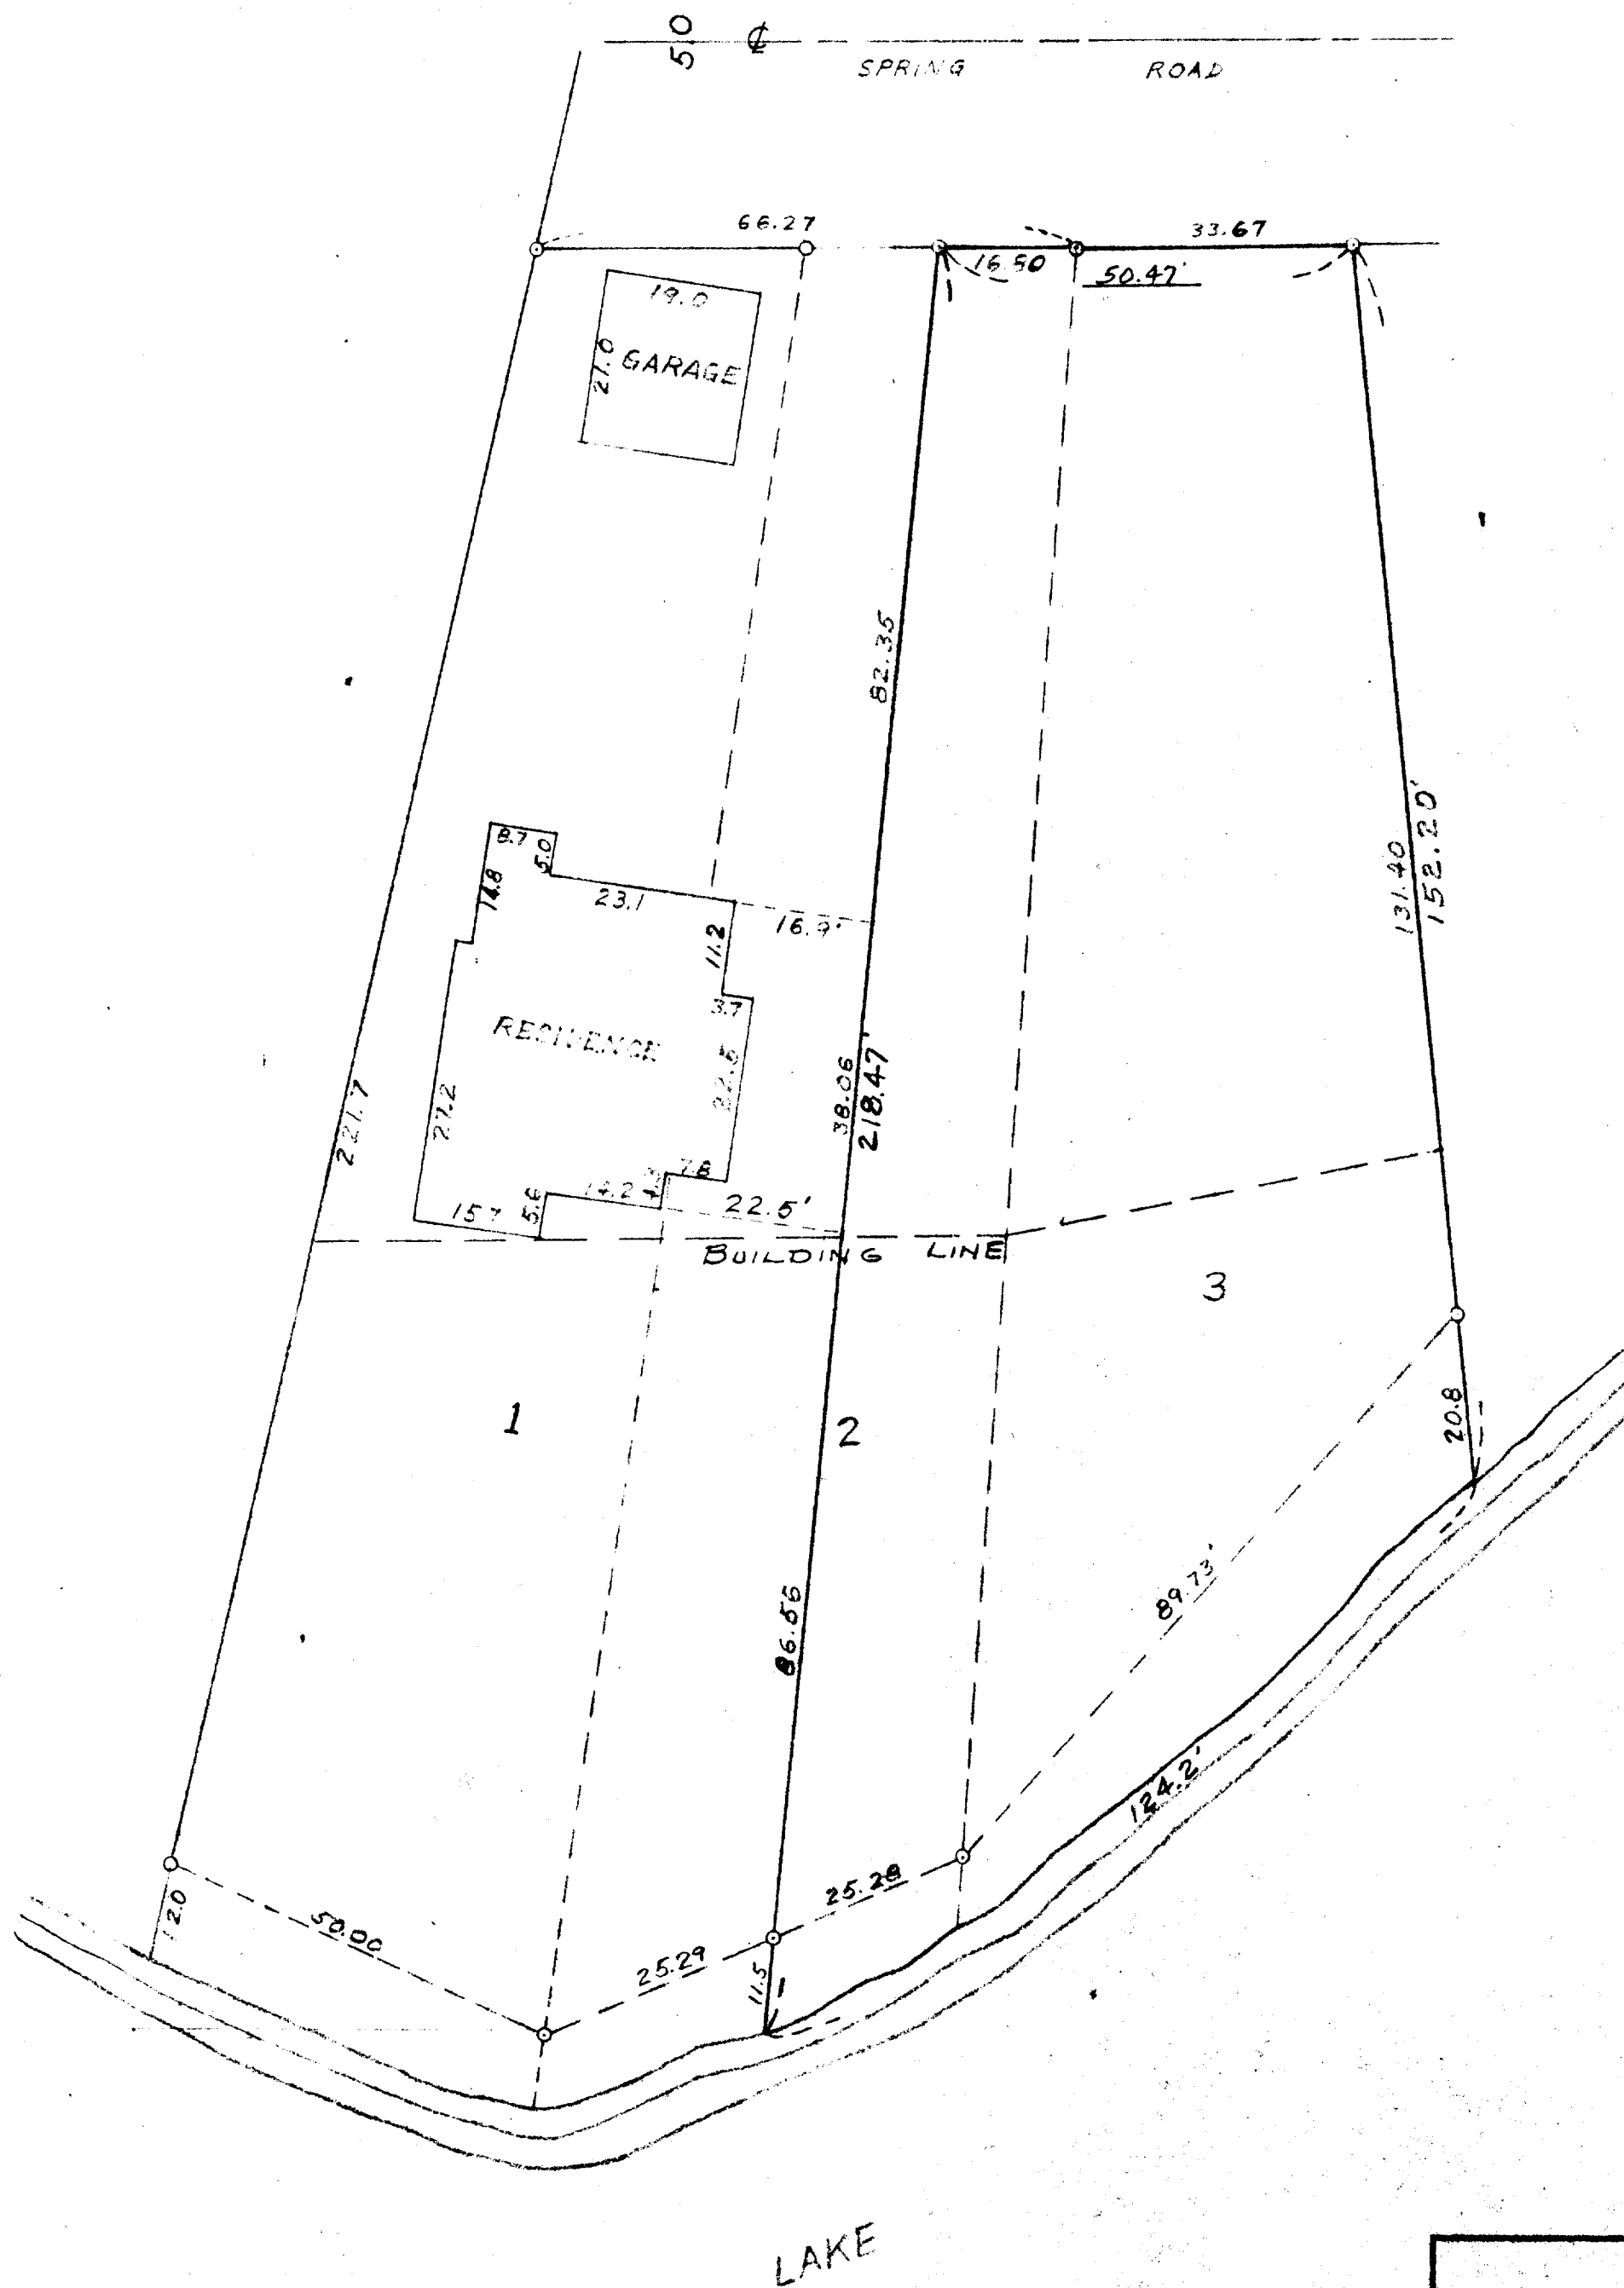


PLAT OF SURVEY OF

LOT 3 AND THE EAST 1/2 OF LOT 2
BLOCK A, CISCO BEACH SUBDIVISION
T 1 N, R 17 E, WALWORTH COUNTY, WISCONSIN

Lloyd L. Jensen
SURVEYOR

SCALE 1" = 20'

DATE AUG. 1959

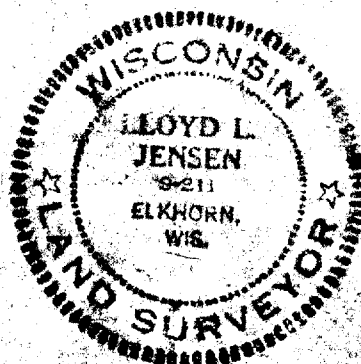

ICI-1.2