



PLAT OF SURVEY

DATE: 2-2-2000

PATHFINDER SURVEYING
FORMERLY KOLB LAND CONSULTING
929 WILLIAMS STREET LAKE GENEVA, WI. 53147
(262) 248-3697

ORDERED BY: CONSTANDINO BIRIS
W 3650 S LAKE SHORE DR.
LAKE GENEVA, WI 53147

DESCRIPTION: THE EAST 40 FEET OF LOT 23 AND ALL OF LOT 24 ALL IN BLOCK 7 OF LAKE GENEVA TERRACE IN THE TOWN OF LINN, WALWORTH CUUNTY, WISCONSIN.

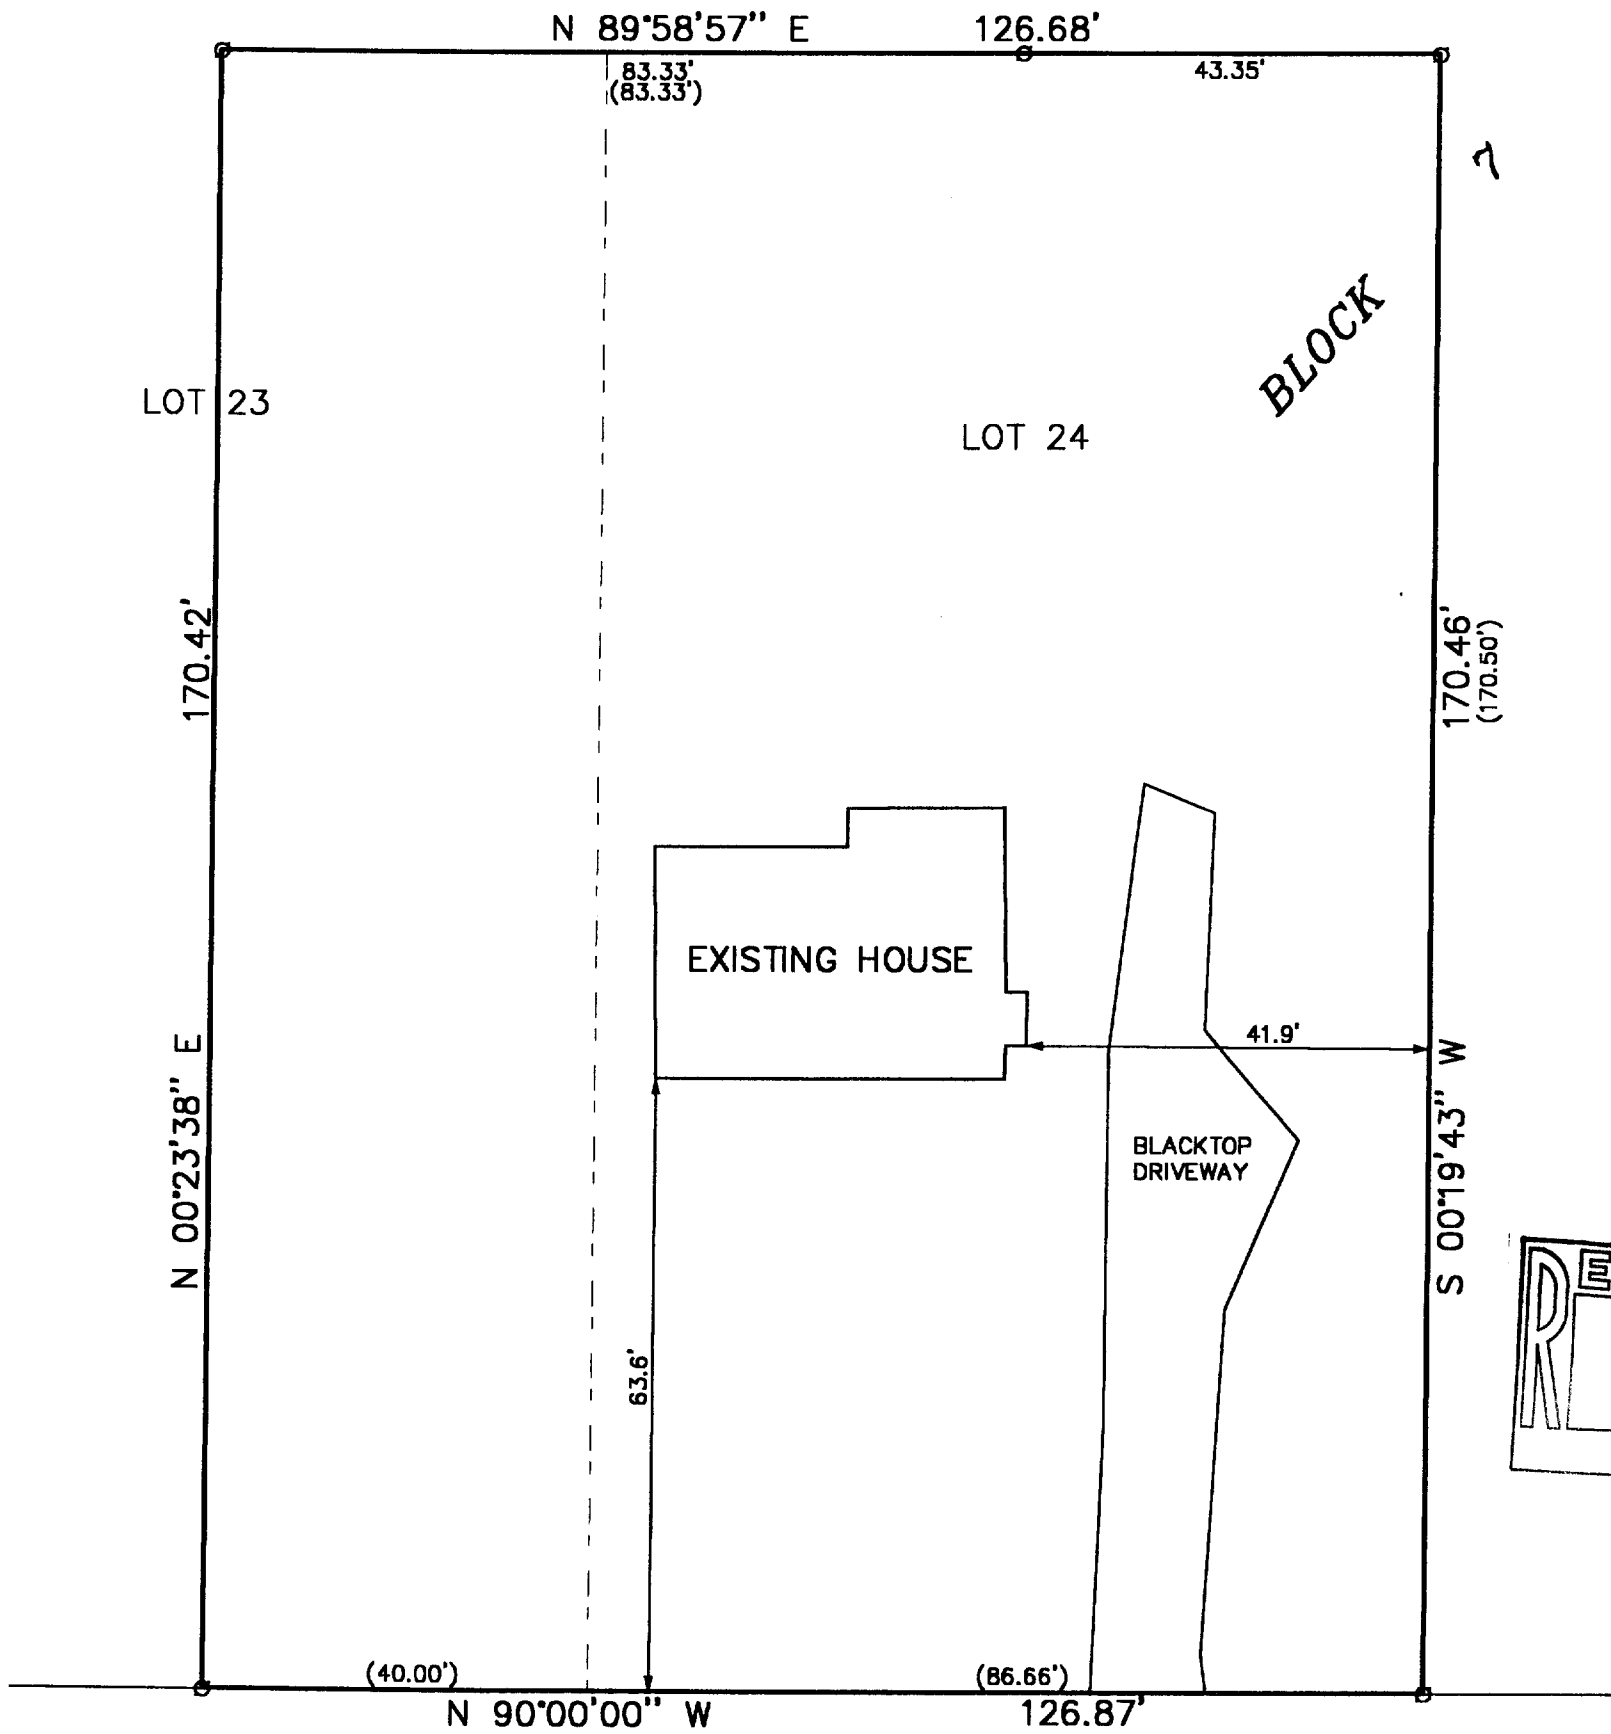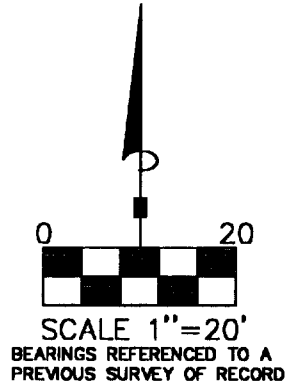

SOUTH SHORE DRIVE

THE ABOVE MAP IS A TRUE REPRESENTATION THEREOF AND SHOWS THE SIZE AND LOCATION OF ALL THE PROPERTY, EXTERIOR BOUNDARIES, THE LOCATION OF ALL VISIBLE BOUNDARY FENCES, APPARENT EASEMENTS, ROADWAYS AND VISIBLE ENCROACHMENTS, IF ANY

THIS SURVEY IS MADE FOR THE USE OF THE PRESENT OWNERS OF THE PROPERTY, AND ALSO THOSE WHO PURCHASE, MORTGAGE OR GUARANTEE TITLE THERETO WITHIN ONE (1) YEAR FROM DATE HERETO.

John P. Krott
JOHN P. KROTT, R.L.S. 2258

LEGEND
■ FOUND IRON PIPE
○ FOUND IRON PIN
(XXXX) RECORDED AS



NOTE: THIS IS NOT A CERTIFIED COPY UNLESS SEAL IS IN RED.

JOB NUMBER 00006 ILGT 00031

117-1849

ILGT-31