

ABELL
SURVEYING & MAPPING

1140 SEQUOIA STREET • DELAVAN, WISCONSIN 53115
262-728-6737

N



SCALE 1"=20'

LEGEND

- - IRON PIPE FOUND
- X—X— - WOOD FENCE
- XX—XX— - CHAINLINK FENCE
- ~~~~~ - ROCK WALL
- △ - UTILITY POLE
- () - RECORDED AS

PLAT OF SURVEY OF

LOT 41 OF SHORE HAVEN, A SUBDIVISION
LOCATED IN T1N, R17E, WALWORTH
COUNTY, WISCONSIN.


I, DAVID F. ABELL, DO HEREBY CERTIFY THAT I HAVE SURVEYED THE PROPERTY HEREON
DESCRIBED ACCORDING TO THE OFFICIAL RECORDS AND THAT THE PLAT HEREON IS A
CORRECT REPRESENTATION OF THE PROPERTY LINES TO THE BEST OF MY KNOWLEDGE AND
BELIEF.

David F. Abell


DAVID F. ABELL
WISCONSIN REGISTERED LAND SURVEYOR, S-1596

February 25, 2000

DATE: _____ JOB NUMBER - 00014
NOTE: THIS IS NOT A CERTIFIED COPY UNLESS SEALED.

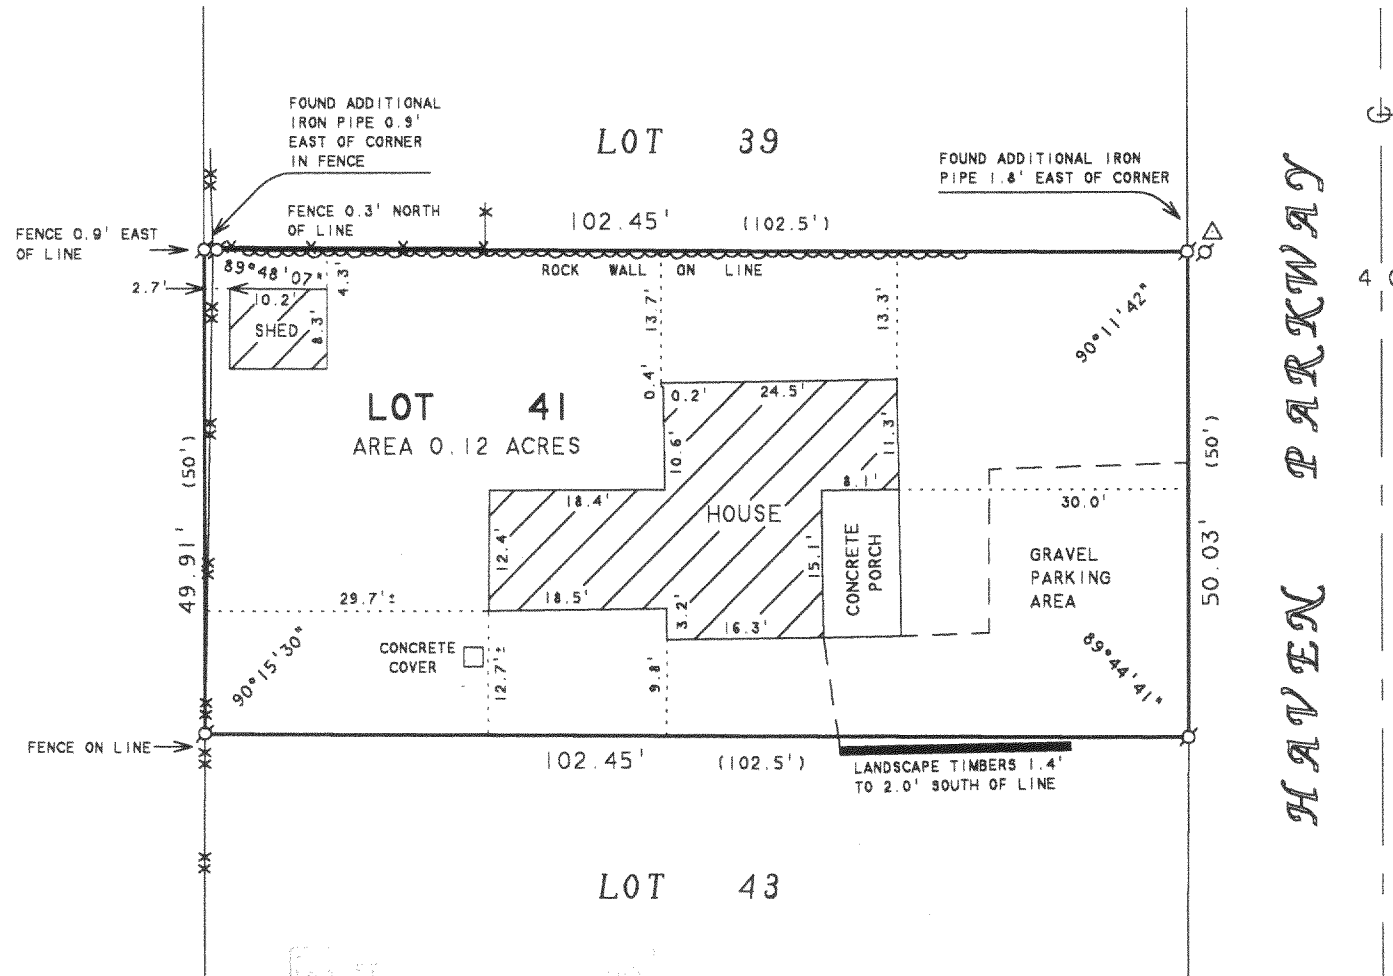

ORDERED BY: SCHLOEMER BUILDERS
W6302 NORTH WALWORTH ROAD
WALWORTH, WI 53184

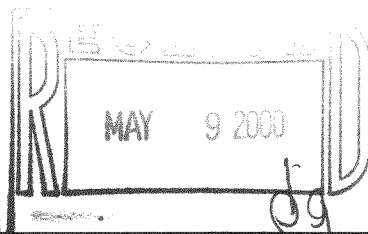

ISA-40

117-1868