

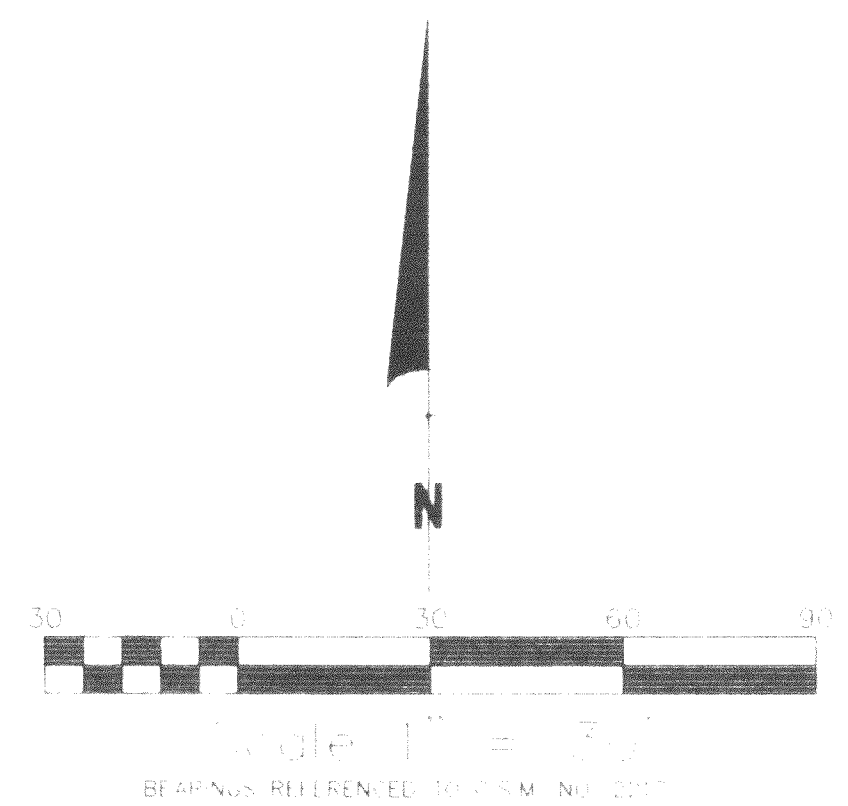


PLAT OF SURVEY

DESCRIPTION: LOT 4 AND OUTLOT 1 OF CERTIFIED SURVEY MAP NO. 2217, LOCATED IN THE NORTHEAST 1/4 AND THE SOUTHEAST 1/4 OF SECTION 5, T 1 N, R 17 E, WALWORTH COUNTY, WISCONSIN.

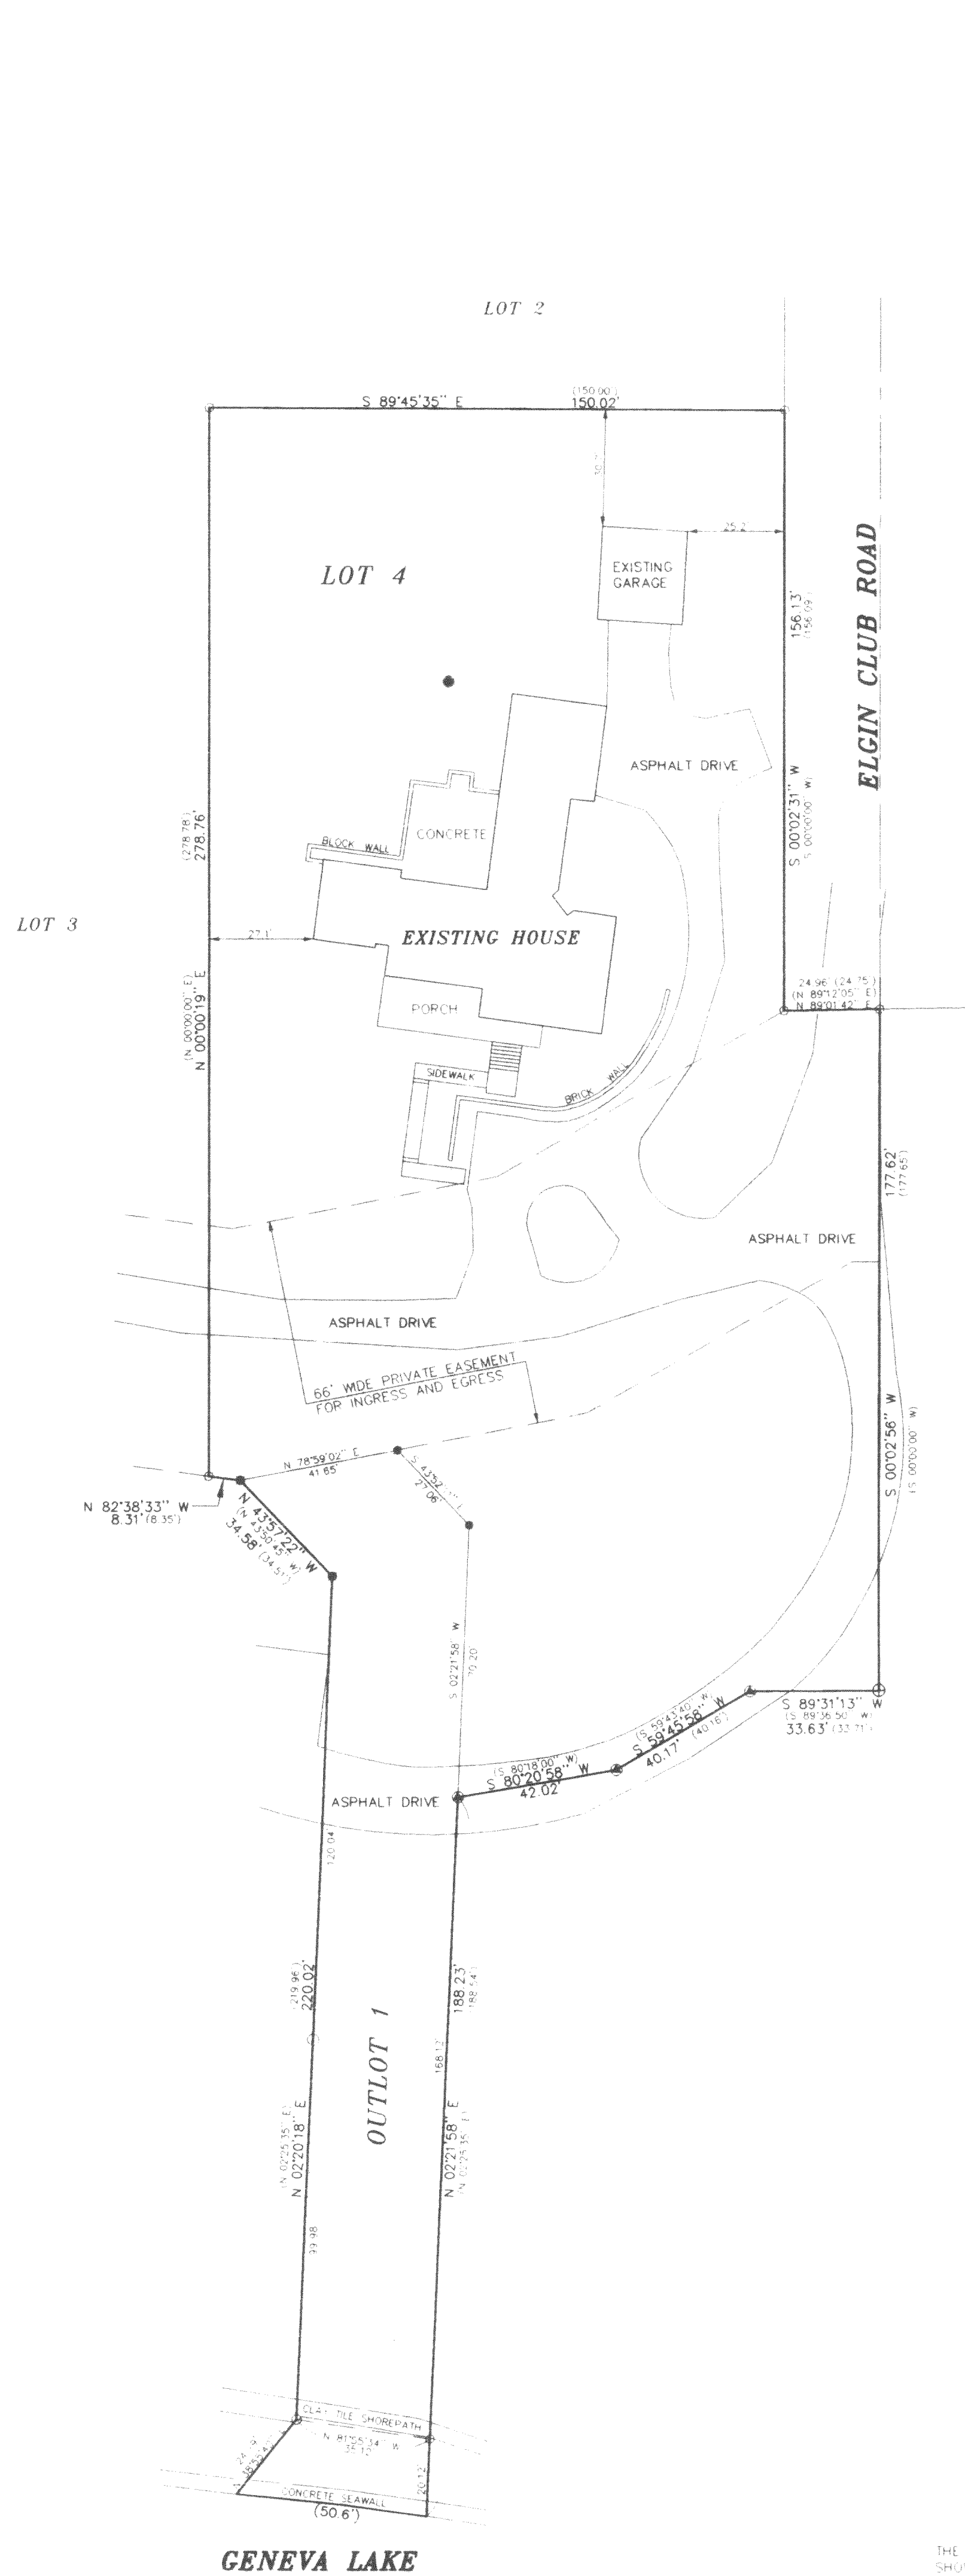

- LEGEND
- ⊕ FOUND CONCRETE MONUMENT
 - FOUND IRON PIPE
 - SET IRON PIPE
 - FOUND IRON PIN
 - FOUND IRON SPIKE
 - ▲ FOUND P.N. NAIL
 - (XXXX) RECORDED AS
 - WELL

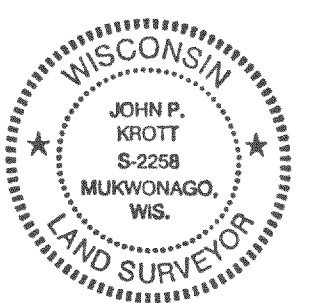

THE ABOVE MAP IS A TRUE REPRESENTATION THEREOF AND SHOWS THE SIZE AND LOCATION OF ALL THE PROPERTY, EXTERIOR BOUNDARIES, THE LOCATION OF ALL VISIBLE BOUNDARY TIES, APPARENT EASEMENTS, ROADWAYS, AND VISIBLE ENCROACHMENTS, IF ANY.

THIS SURVEY IS MADE FOR THE USE OF THE PRESENT OWNERS OF THE PROPERTY, AND ALSO THOSE WHO PURCHASE, MORTGAGE OR GUARANTEE TITLE THEREIN WITHIN ONE (1) YEAR FROM DATE HERETO.

DATE: 3-12-2000

John P. Krott
JOHN P. KROTT, S-2258

ORDERED BY: LARRY & SALL PAINE
P.O. BOX 3619
NORTHFIELD, IL 60091

PATHFINDER SURVEYING
FORMERLY KOLB LAND CONSULTING
929 WILLIAMS STREET LAKE GENEVA, WI. 53147
(262) 248-3697

NOTE: THIS IS NOT A CERTIFIED COPY
UNLESS SEAL IS IN RED
JOB NUMBER #00045-1-17-1A 221703004

117-1873

JA-2217-4