


PLAT OF SURVEY


LOT 1, LAKE GENEVA HIGHLANDS SUBDIVISION,
LOCATED IN SECTION 8, TOWN 1 NORTH, RANGE 17
EAST, LINN TOWNSHIP, WALWORTH COUNTY,
WISCONSIN.

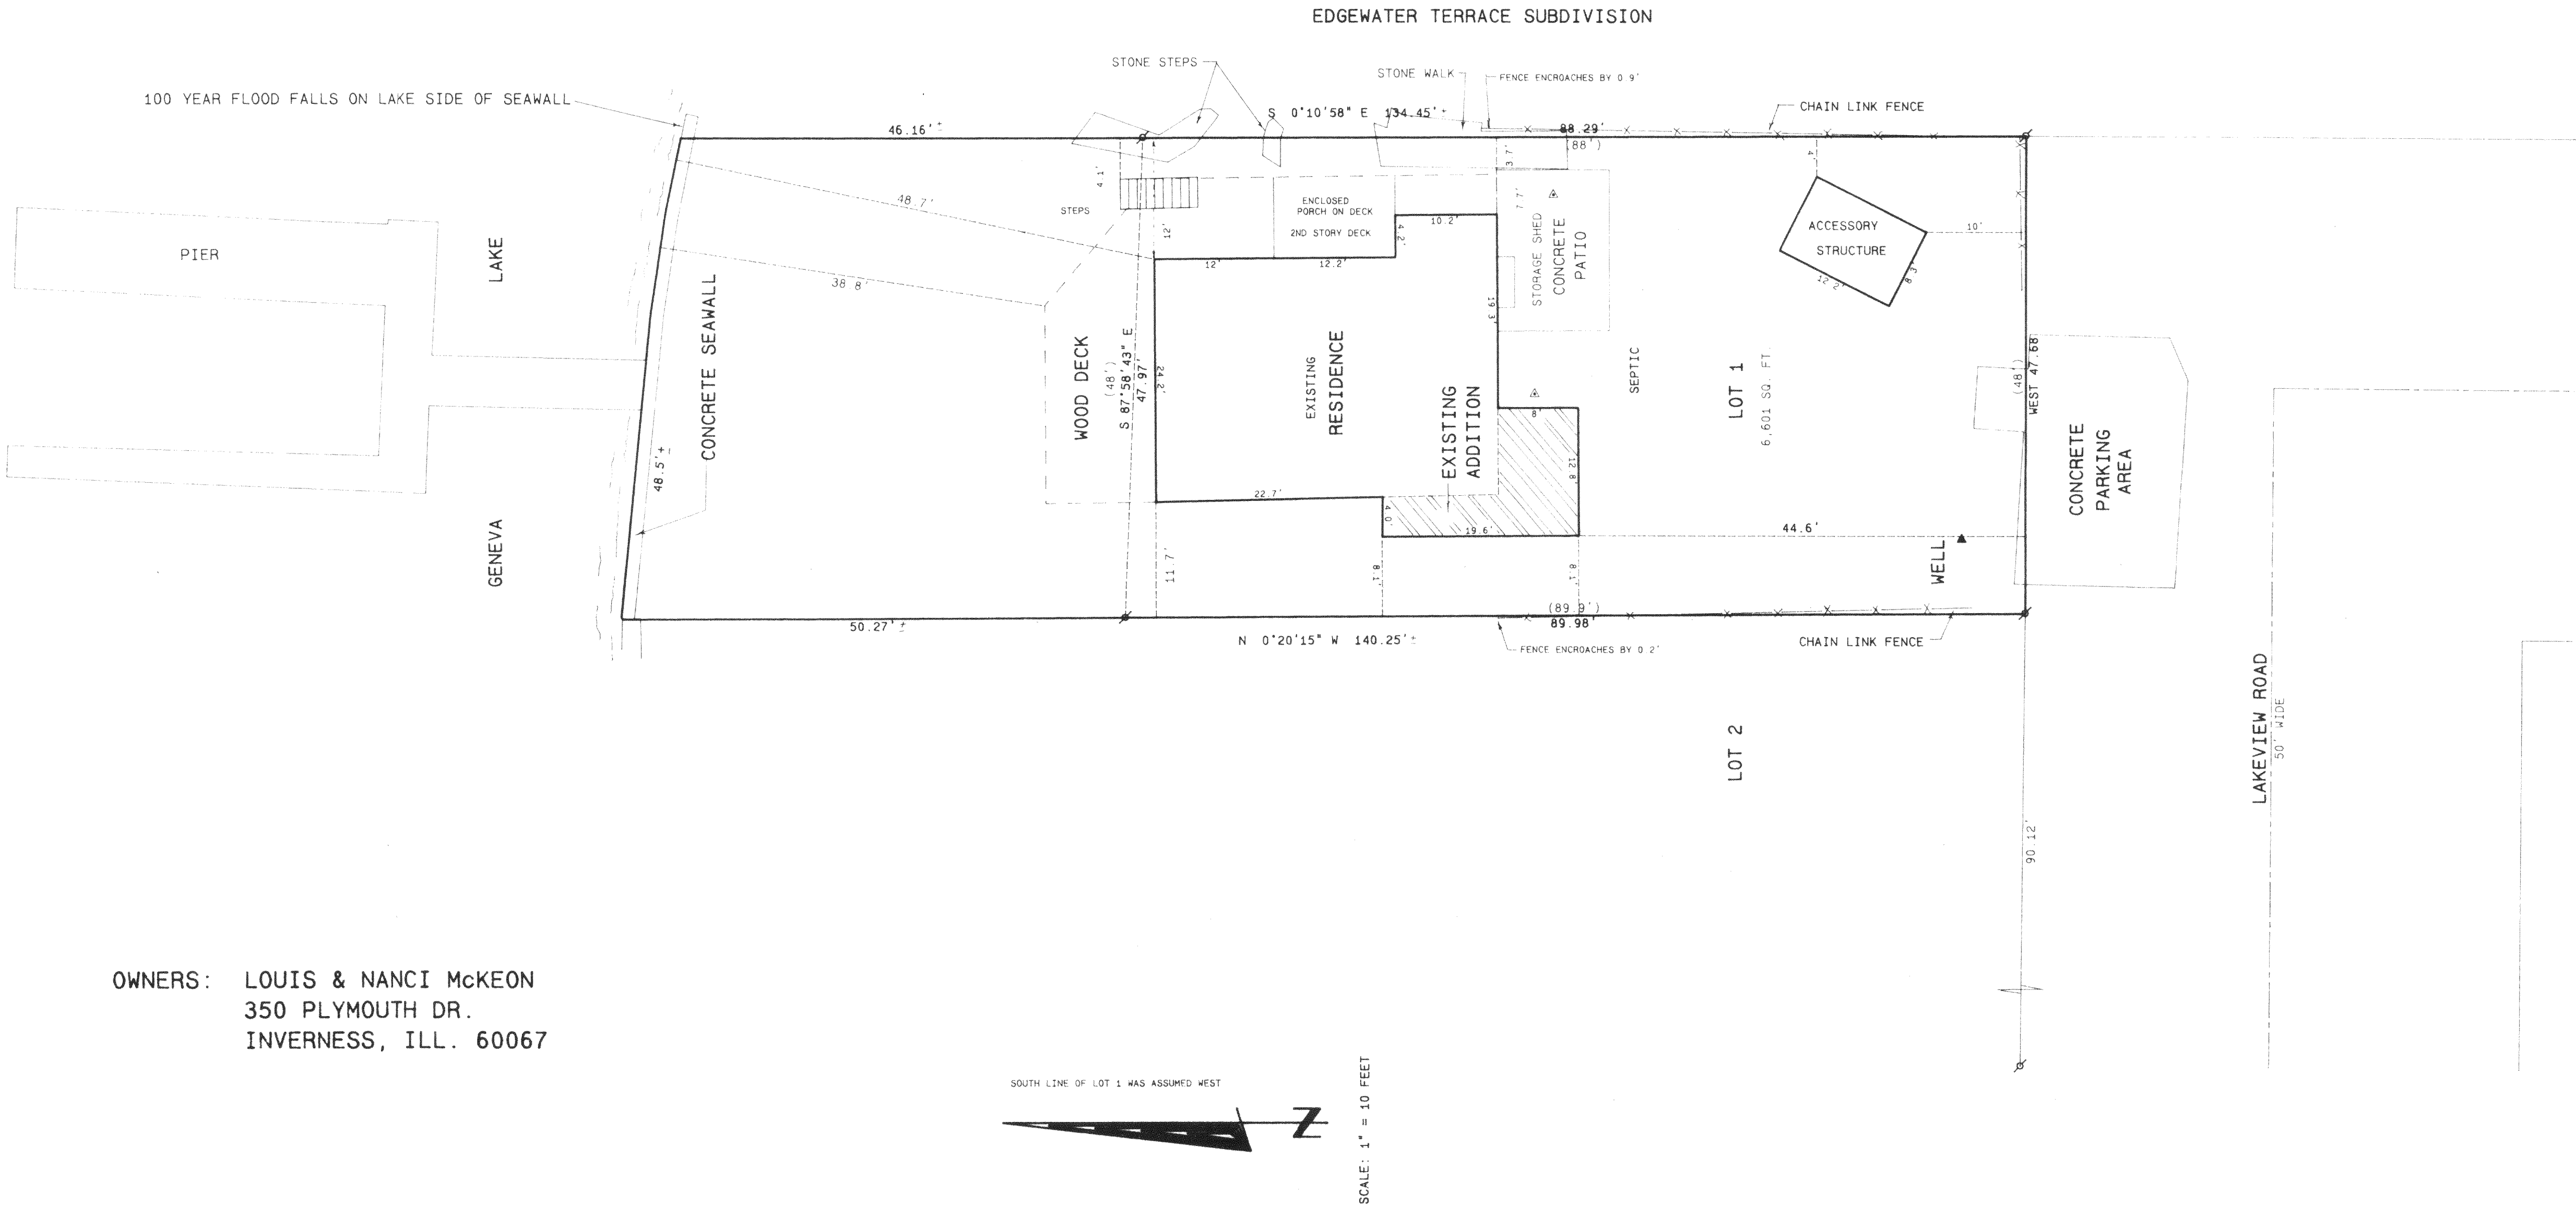

OWNERS: LOUIS & Nanci McKEON
350 PLYMOUTH DR.
INVERNESS, ILL. 60067

Legend

- FOUND IRON PIPE
- FOUND IRON ROD
- FOUND BRASS-CAPPED MONUMENT
- FOUND CONCRETE MONUMENT
- CHISEL CUT IN CONCRETE
- SET IRON ROD, 24" LONG, WEIGHING 1.5 LBS. LINEAL FT., 3/4" DIA.
- SET IRON ROD, 36" LONG, WEIGHING 4.5 LBS. LINEAL FT., 1 1/16" DIA.
- RECORDED AS DIMENSION
- EXISTING FENCE

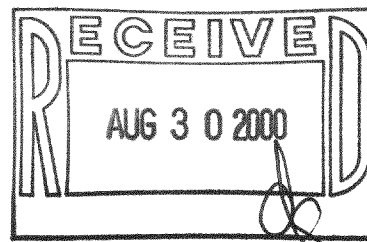

SCALE: 1" = 10 FEET

PLAT REVISED TO SHOW ADDITION,
ACCESSORY STRUCTURE AND REVISED FENCE

REVISED 4/26/00



I hereby certify that the above described property has been surveyed by me or under my direction, and that the above map is a true representation thereof and shows the size and location of the property, its exterior boundaries, the location of all visible structures and dimensions of all principal buildings thereon, boundary fences, apparent easements, roadways and visible encroachments, if any.

This survey is made for the use of the present owners of the property, and also those who purchase, mortgage, or guarantee the title thereto within one year from date hereof.

Kenneth B. Abernathy Jr.

KENNETH B. ABERNATHY, JR.
WISCONSIN REGISTERED LAND SURVEYOR,
S-1594

Date: JUNE 25, 1998 Job No. 16644

ILGH-1

117-1895