

Kenneth B. Abernathy Jr.


**W4056 BRAY RD.
ELKHORN, WI. 53121
PHONE: (262) 723-4260 (OFFICE)
(262) 723-7209 (FAX)
Email: abernathy@elknet.net**

LOTS 13-15 INCLUSIVE AND THE EAST
1/2 OF LOT 16 OF BLOCK "F" OF
CISCO BEACH SUBDIVISION, LOCATED
IN TOWN 1 NORTH, RANGE 17 EAST,
WALWORTH COUNTY, WISCONSIN.

ORDERED BY: JUDY HOWE
COLDWELL BANKER
GENEVA LAKES AREA REALTORS
623 W. MAIN ST.
LAKE GENEVA, WI. 53147


OWNER: SALUDA G. McNEIL
2730 S. HIGHWAY A1A BOX 96
MELBOURNE, FL. 32951

SUBJECT PROPERTY: W4272 CRESCENT DR.

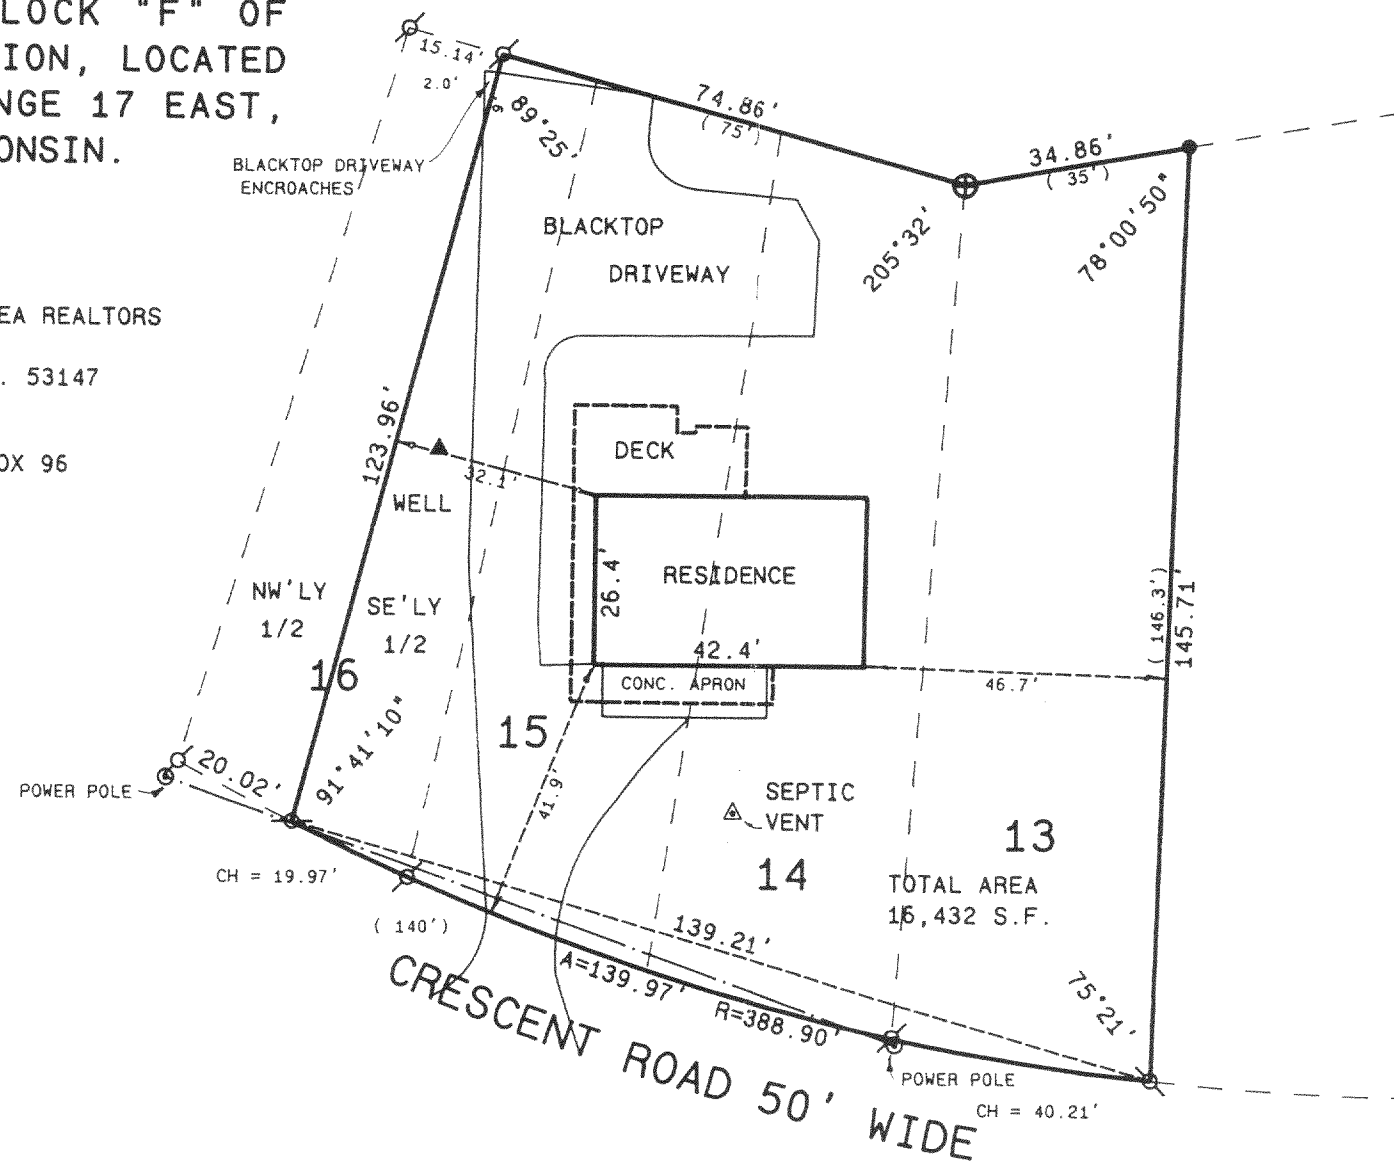

Legend

-  FOUND IRON PIPE
-  FOUND IRON ROD
-  FOUND BRASS CAPPED MONUMENT
-  FOUND CONCRETE MONUMENT
-  CHISEL CUT IN CONCRETE
-  SET IRON ROD, 24" LONG, WEIGHING
1.5 LBS./LINEAL FT., 3/4" DIA.
-  SET IRON ROD, 30" LONG, WEIGHING
4.5 LBS./LINEAL FT., 1-11/16" DIA.
- (xx) RECORDED AS DIMENSION
- x—x—x— EXISTING FENCE

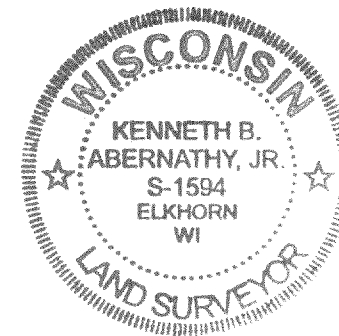

SCALE: 1" = 30 FEET

"I hereby certify that the above described property has been surveyed by me or under my direction and that the above map is a true representation thereof and shows the size and location of the property, its exterior boundaries, the location of all visible structures and dimensions of all principal buildings thereon, boundary fences, apparent easements, roadways and visible encroachments, if any."


"This survey is made for the use of the present owners of the property, and also those who purchase, mortgage, or guarantee the title thereto within one year from date hereof."

Kenneth B. Abernathy

ETH B. ABERNATHY, JR.

KENNETH B. ABERNATHY, JR. 10
WISCONSIN REGISTERED LAND SURVEYOR,
S-1594

Date: SEPT. 15, 2000 Job No. 00.905

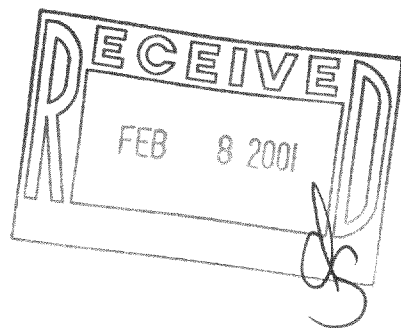

ICI-116 117-1957