



West 1/4 Corner
Section 3-1-17.

(South 80.30')

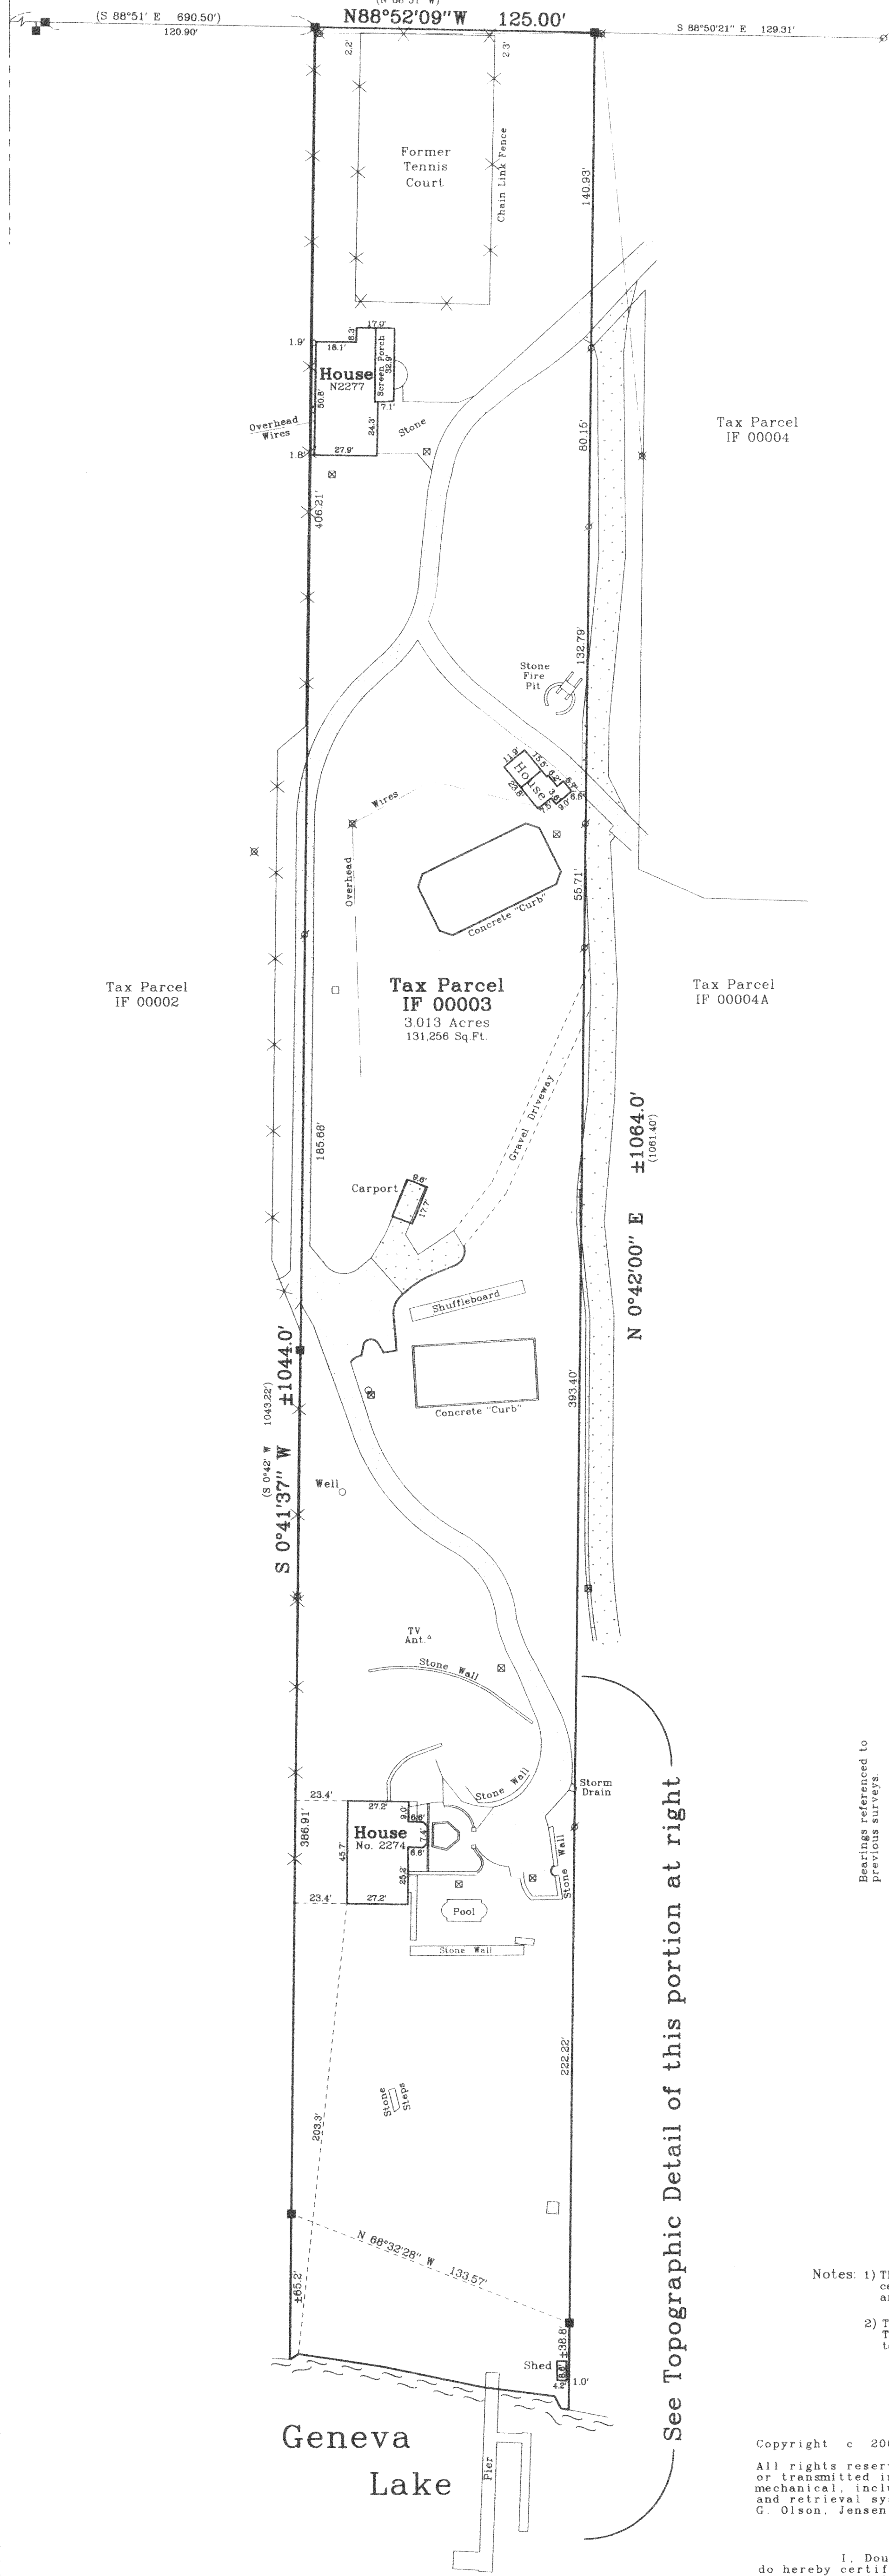

Plat of Survey

of

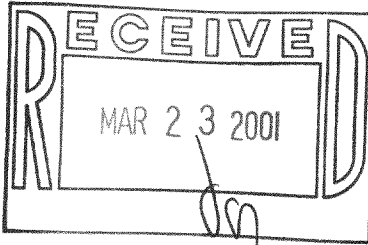


Lands described in a Warranty Deed recorded in Vol. 493 on Page 139 as Document No. 477947 as follows:
The parcel of land located in Section Three (3), Township One (1) North, Range Seventeen (17) East and being a part of Lot One (1) of the Subdivision "The Folly" of Walworth County, Wisconsin, described as follows, to-wit: Commencing at the West Quarter Section corner of Section Three (3), Town One (1) North, Range Seventeen (17) East; thence South Eighty and thirty hundredths (80.30) feet; thence South Eighty-eight degrees, Fifty-one minutes (88°) East Six Hundred Ninety and fifty hundredths (690.50) feet to the place of beginning; thence South Forty-two minutes (0°) West One Thousand Forty-three and twenty-two hundredths (1043.22) feet to the shore of Lake Geneva; thence Easterly along the shore to a point that is located One Hundred Twenty-five (125) feet at right angles from the last described line; thence North Forty-two minutes (0°) East One Thousand Sixty-one and forty hundredths (1061.40) feet to a point on the North line of said lot; thence North Eighty-eight degrees, Fifty-one minutes (88°) West One Hundred Twenty-five (125) feet to the place of beginning, having servient and dominant easements noted on the plat of survey dated June 7, 1939, and certified by Lloyd L. Jensen, County Surveyor, together with improvements located thereon.

Surveyed for: **Paul & Elsie Makray**
642 Edgemont Lane
Park Ridge, Illinois 60068

c/o

Matt Riley
735 South Brockway
Palatine, Illinois 60067

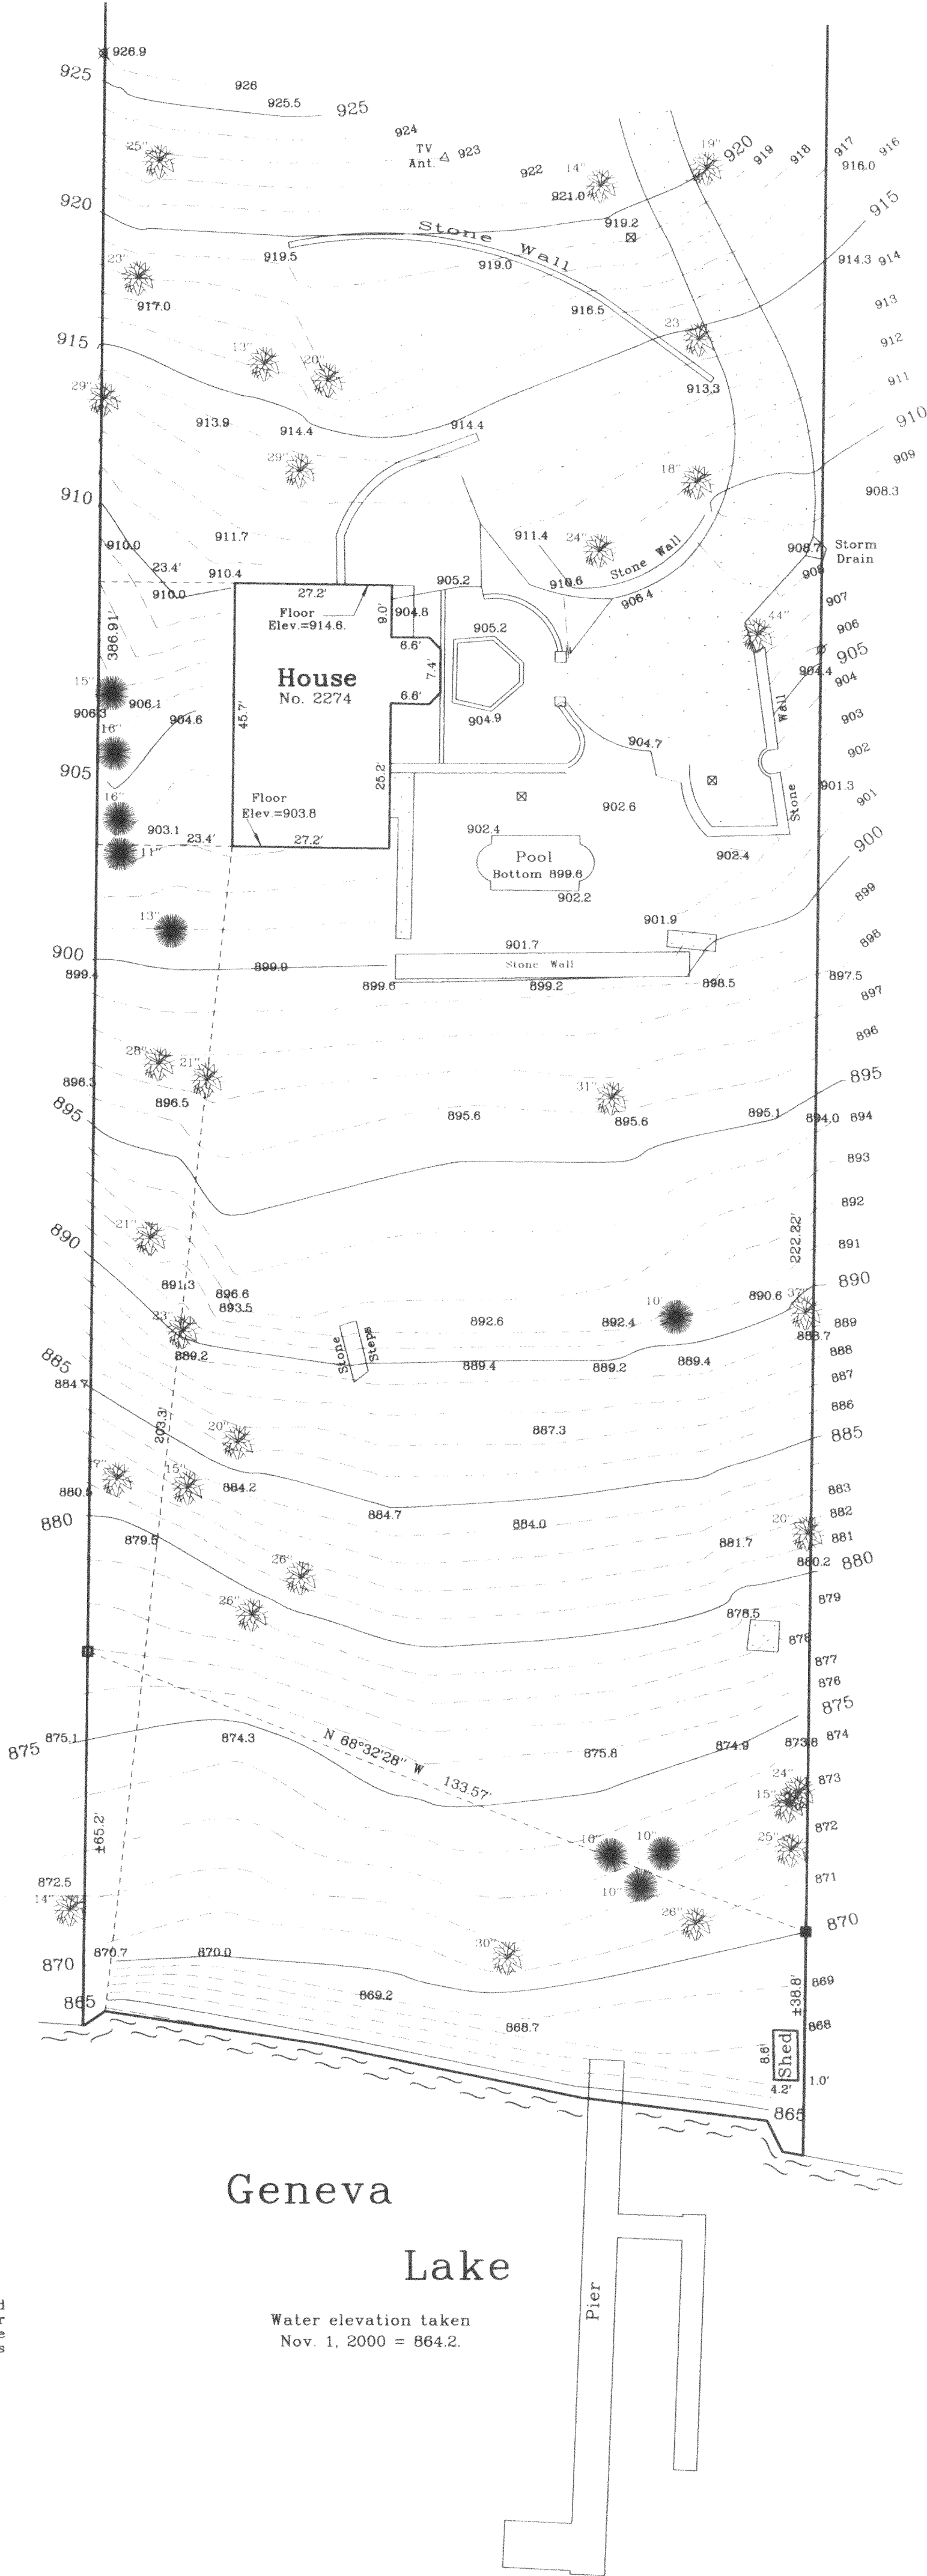

See Topographic Detail of this portion at right

- Notes: 1) This survey plat is not certified unless signed and sealed in red ink.
2) This survey is subject to Wisconsin lien laws. This Plat of Survey is the notice of intent to file lien. Lien waiver required.

Copyright © 2000 by Jensen & Olson Land Surveying, LLC.

All rights reserved. No part of this survey plat may be reproduced or transmitted in any form by any means - graphic, electronic, or mechanical, including photocopying, tracing, or information storage and retrieval systems - without permission in writing from Douglas G. Olson, Jensen & Olson Land Surveying, LLC.

I, Douglas G. Olson, Wisconsin Registered Land Surveyor, do hereby certify that this survey was performed by me or under my direction in full compliance with the owner's/agent's instructions and Chapter A-E 7 of the Wisconsin Administrative Code "Minimum Standards for Property Surveying", and that this map is an accurate representation thereof to the best of my knowledge and belief.

Douglas G. Olson
Wisconsin Registered Land Surveyor - 2093

2000.135

Sheet 1 of 1 Sheets.

Job Reference Number

2000.135

Legend


- Found Concrete Monument
- Found Iron Pipe
- Recorded Information
- Utility Pole
- Utility Pedestal
- Manhole
- Asphalt Surface
- Concrete Surface
- Wire Fence
- Deciduous Tree with diameter
- Coniferous Tree

Jensen & Olson Land Surveying, LLC

45 South Wisconsin Street P.O. Box 322
Elkhorn, Wisconsin 53121
Telephone: (262) 723-3434
Facsimile: (262) 723-8044

Scale in Feet

1" = 40'

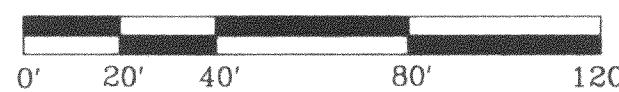

Survey date: November 1, 2000.

Revisions:

IF-0003

117-1963