


HAROLD H. KOLB

REGISTERED PROFESSIONAL LAND SURVEYOR
LAKE GENEVA, WISCONSIN

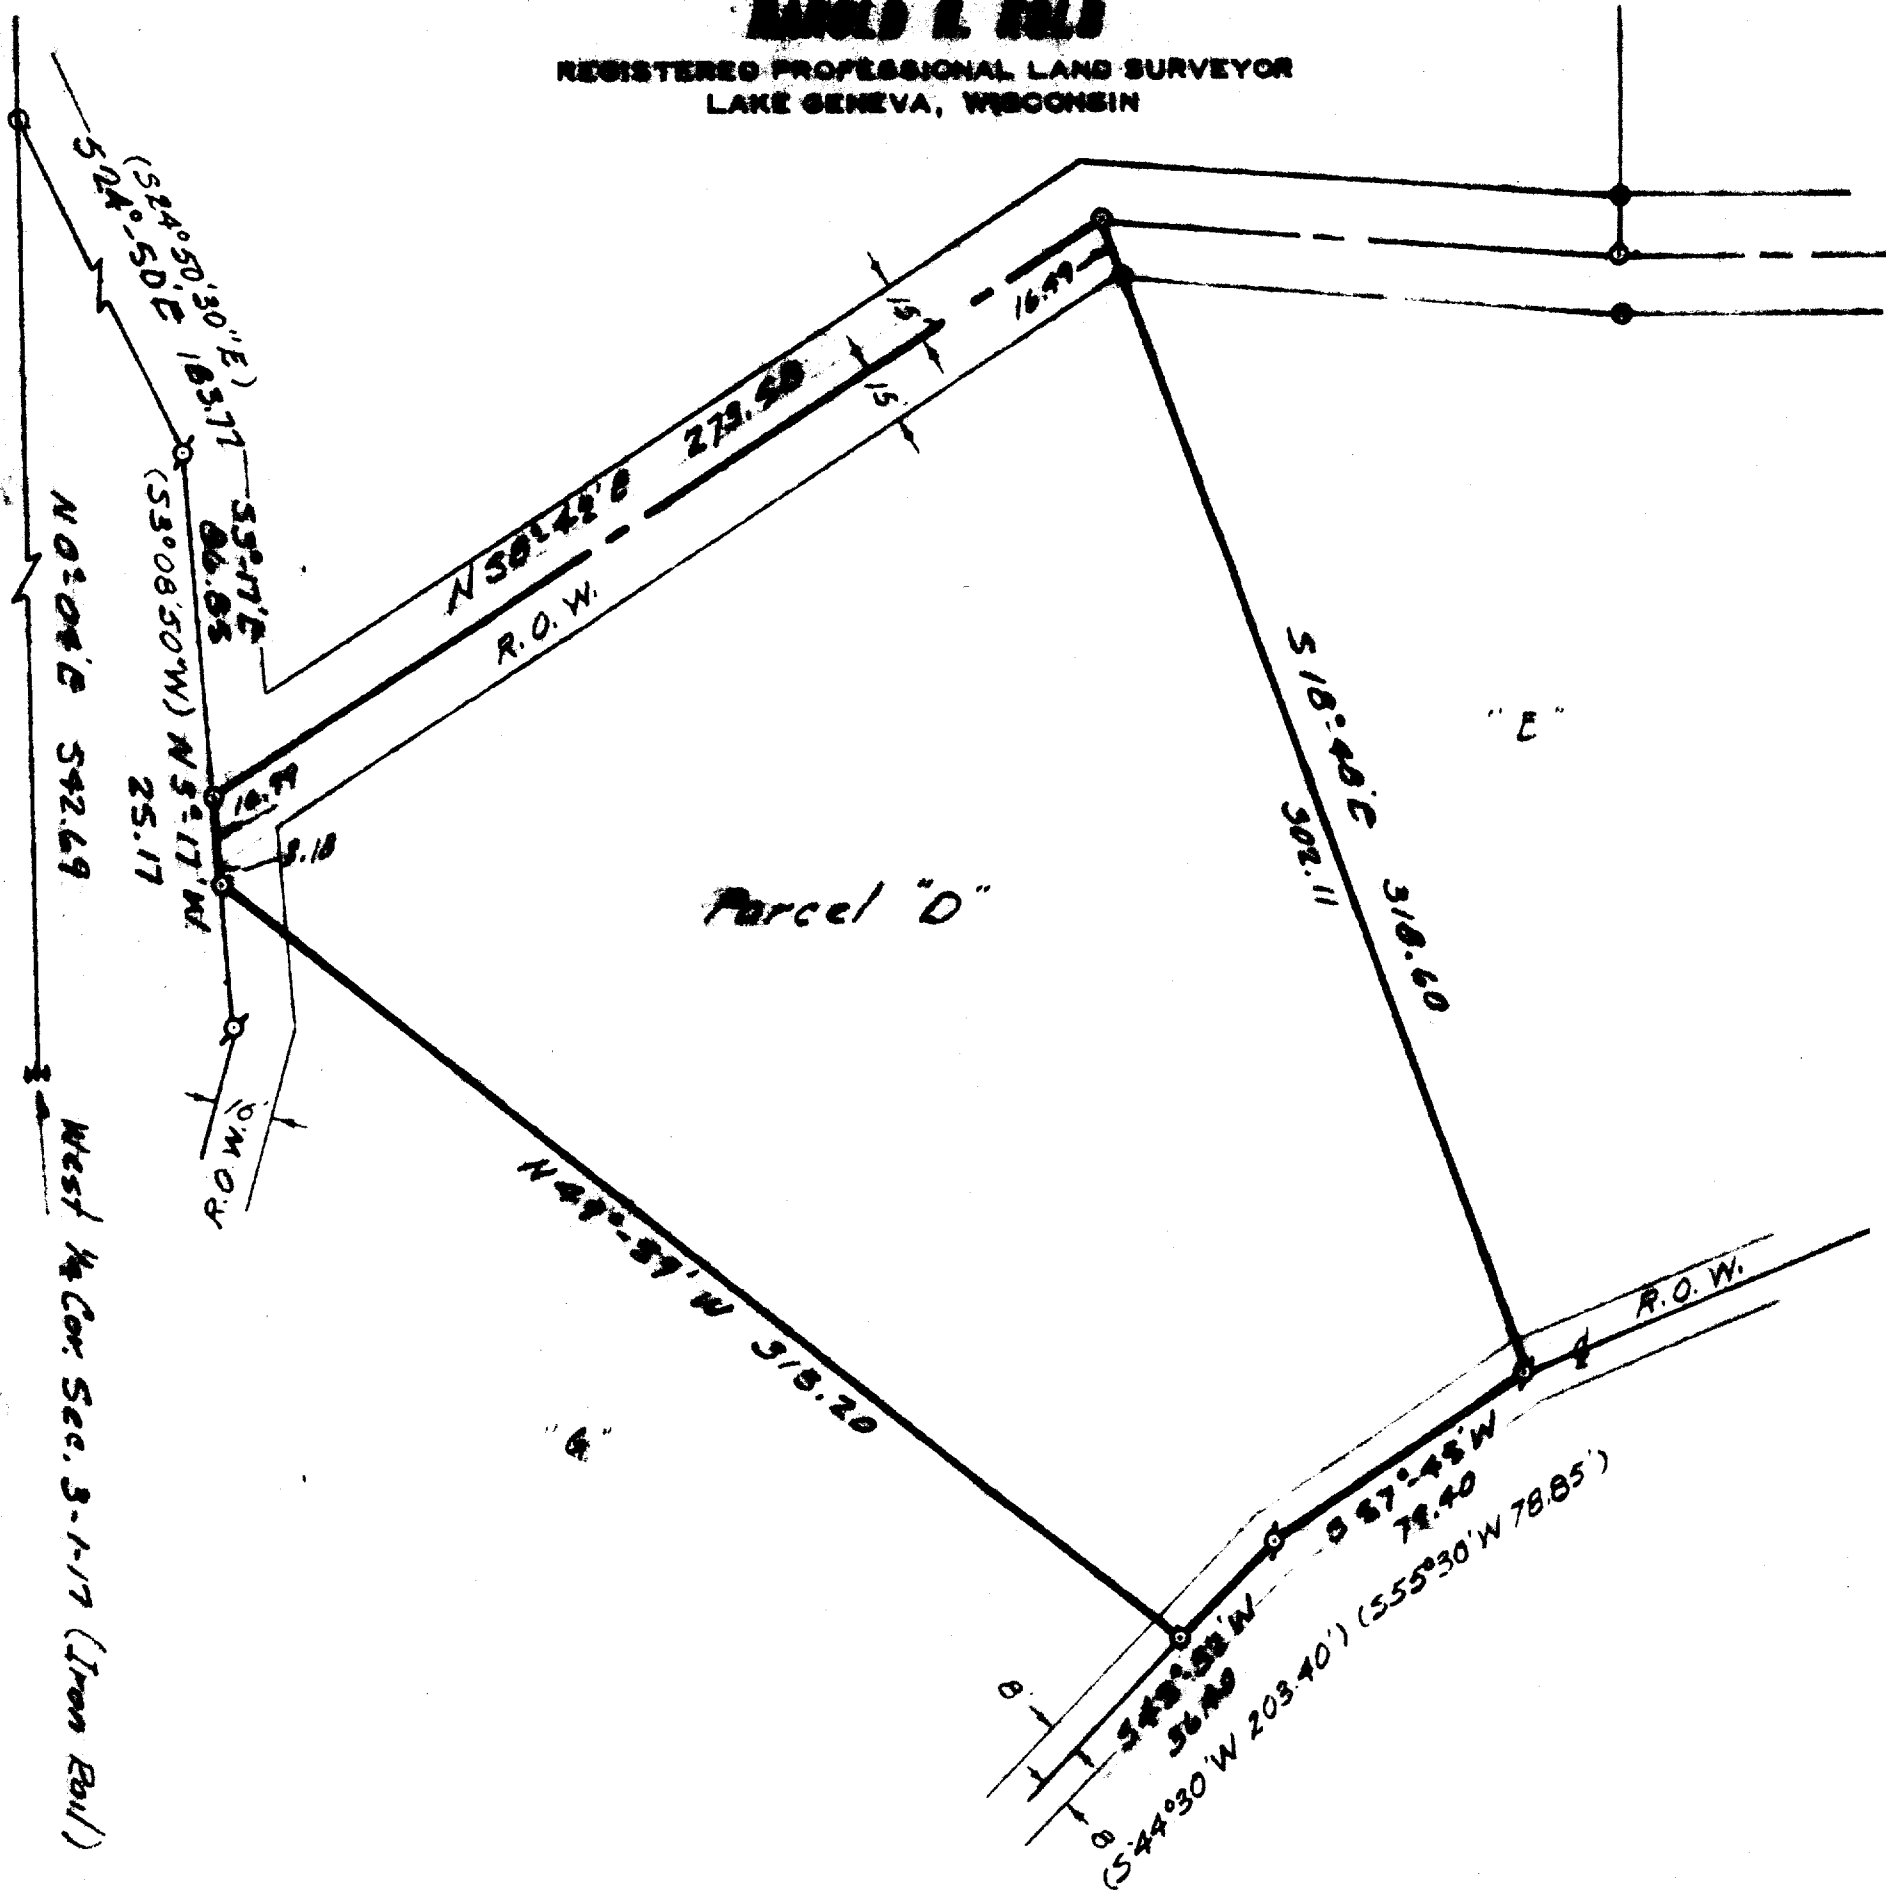

PLAT OF SURVEY OF

A parcel of land located in the West 1/2 of Section 3, T 1 N, R 17 E, Walworth County, Wisconsin and described as follows; to wit: Commencing at the West 1/4 corner of said Section 3; thence N 0°04' E 542.69 feet; thence S 24°50' E 183.77 feet; thence S 3°17' E 86.85 feet to the place of beginning; thence N 58°42' E 273.58 feet; thence S 18°48' E 318.60 feet; thence S 57°45' W 79.40 feet; thence S 45°52' W 36.40 feet; thence N 49°59' W 315.20 feet; thence N 3°17' W 25.17 feet to the place of beginning. Containing 1.46 acres.



SCALE: 1" = 50'

LEGEND

- ∘ - IRON PIPE FOUND
- - IRON PIPE PLACED
- - CONCRETE MONUMENT
- ✕ - SPIKE
- () - Recorded distance or bearing
- R.O.W. - Right-of-Way

BB 102 - S'ly part of parcel

I, HAROLD H. KOLB, DO HEREBY CERTIFY THAT I HAVE SURVEYED THE PROPERTY HEREON DESCRIBED ACCORDING TO THE OFFICIAL RECORDS, AND THAT THE PLAT HEREON IS A CORRECT REPRESENTATION OF THE LOT LINES.

Harold H. Kolb
HAROLD H. KOLB

WISCONSIN REGISTERED LAND SURVEYOR, S-187
DATE May 18, 1967

117-198