


HAROLD H. KOLB

REGISTERED PROFESSIONAL LAND SURVEYOR
LAKE GENEVA, WISCONSIN

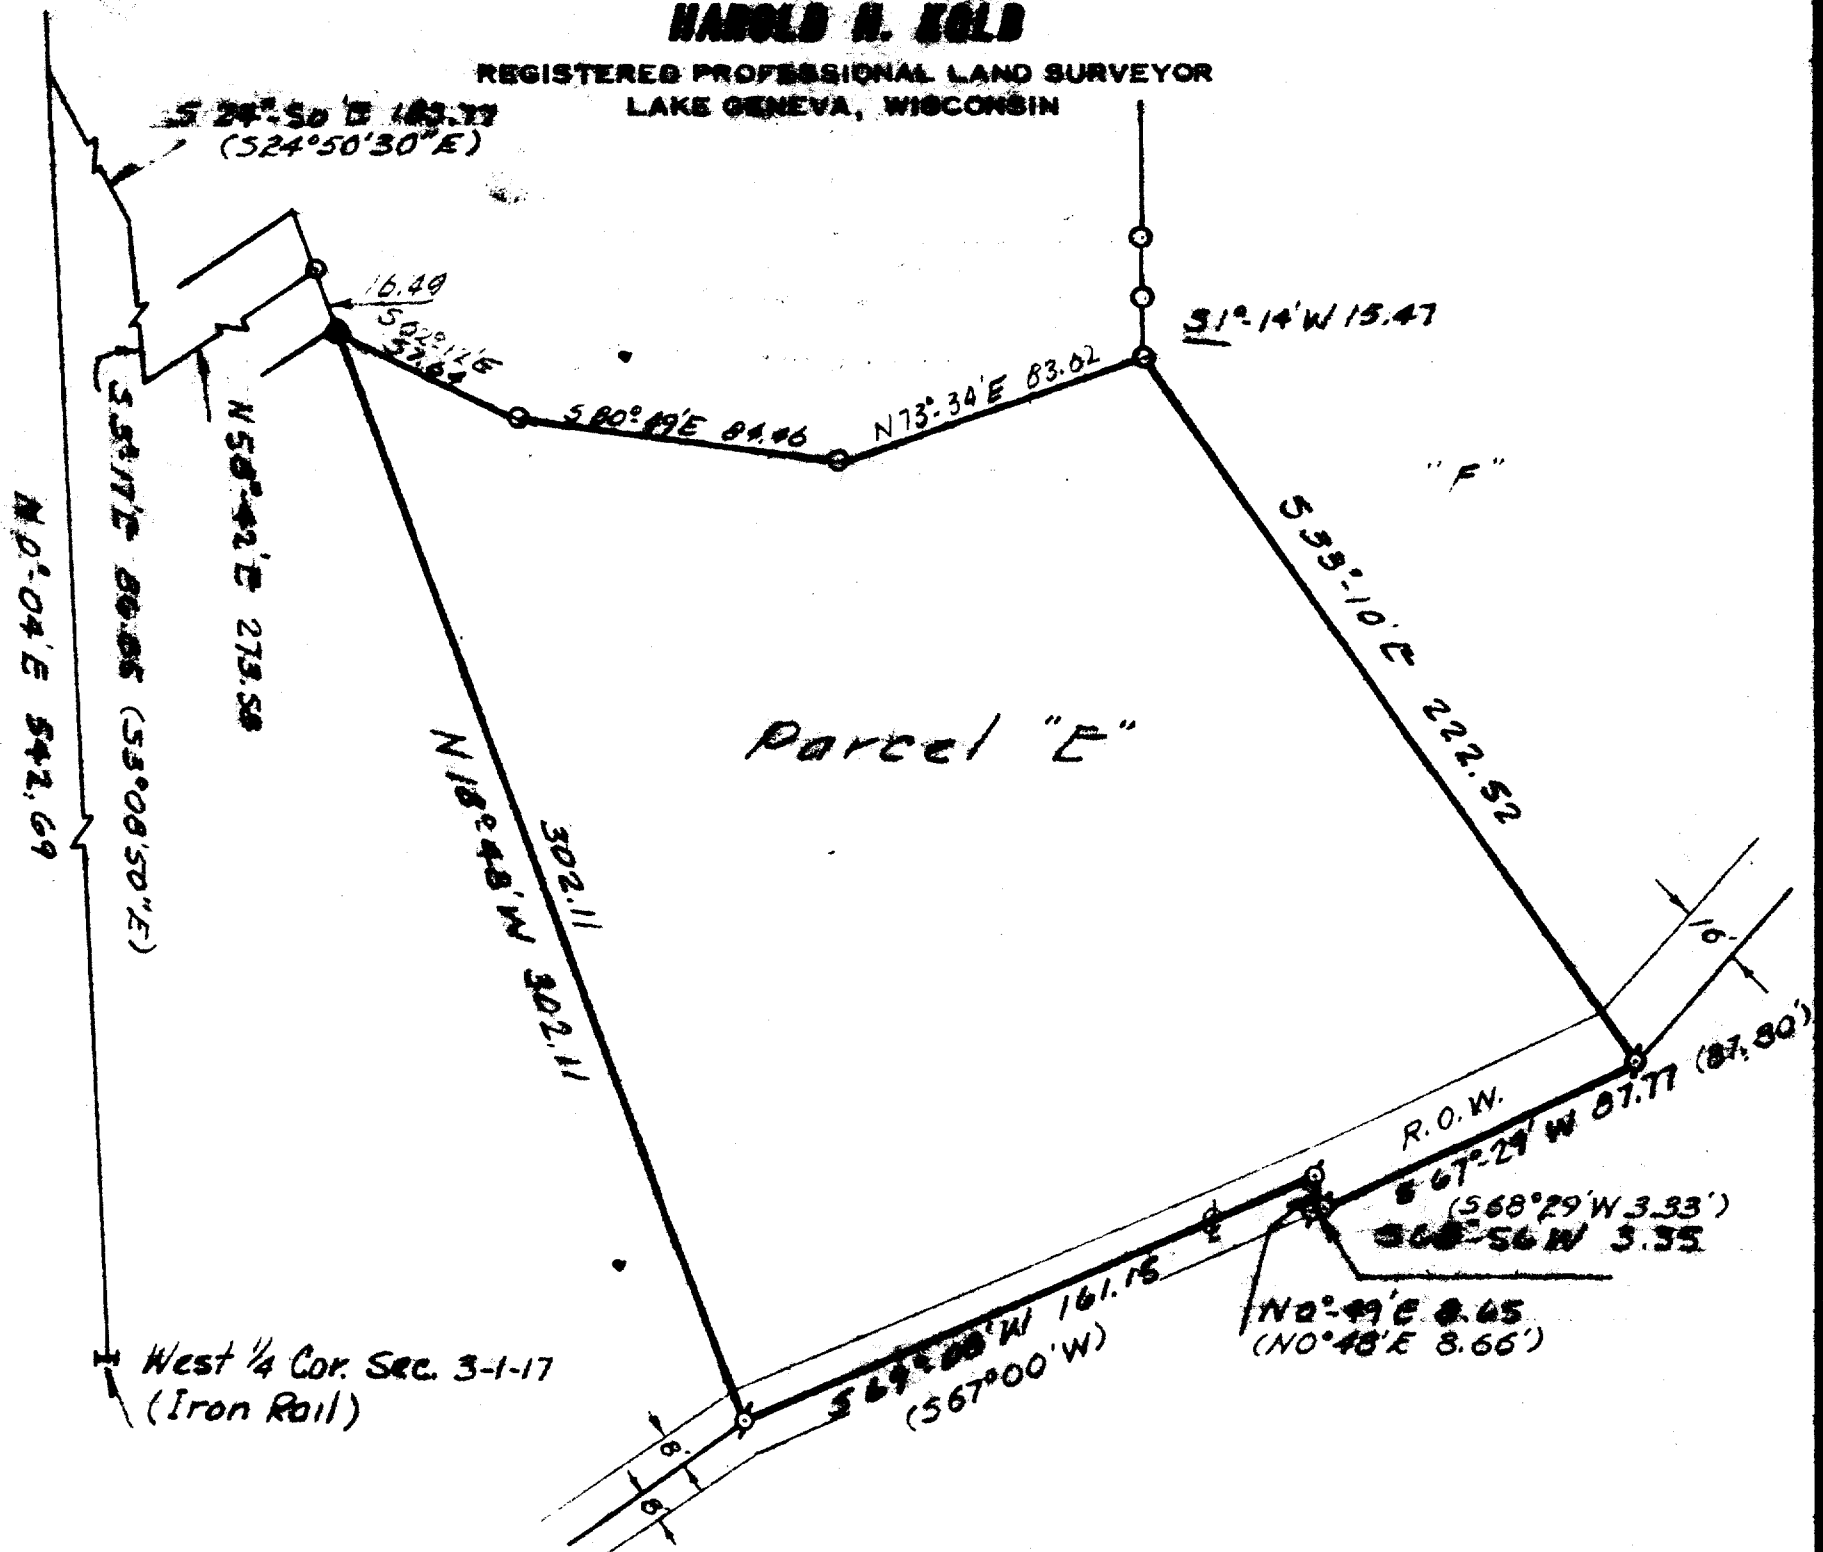

PLAT OF SURVEY OF

A parcel of land located in the West 1/2 of Section 3, T 1 N; R 17 E, Walworth County, Wisconsin and described as follows; to wit:
Commencing at the West 1/4 corner of said Section 3; thence N 0°04' E 542.69 feet; thence S 24°50' E 183.77 feet; thence S 3°17' E 86.85 feet; thence N 58°42' E 273.58 feet; thence S 18°48' E 16.49 feet to the place of beginning; thence S 62°12' E 57.54 feet; thence S 80°49' E 84.46 feet; thence N 73°34' E 83.62 feet; thence S 33°10' E 222.52 feet; thence S 67°29' W 87.77 feet; thence S 68°56' W 3.35 feet; thence N 0°49' E 8.65 feet; thence S 59°08' W 161.15 feet; thence N 18°48' W 302.11 feet to the place of beginning.
Containing 1.28 Acres.

SCALE: 1" = 50'
LEGEND

- IRON PIPE FOUND
- — IRON PIPE PLACED
- — CONCRETE MONUMENT
- x — SPIKE

() — Recorded distance or bearing
R.O.W. — Right-of-way



I, HAROLD H. KOLB, DO HEREBY CERTIFY THAT I HAVE SURVEYED THE PROPERTY HEREON DESCRIBED ACCORDING TO THE OFFICIAL RECORDS, AND THAT THE PLAT HEREON IS A CORRECT REPRESENTATION OF THE LOT LINES.

Harold H. Kolb
HAROLD H. KOLB

WISCONSIN REGISTERED LAND SURVEYOR, S-187
DATE May 18, 1967

BB-1C3. R/W - over parcel

117-199