


WALWORTH COUNTY SURVEYING & MAPPING

P. O. BOX 1115
LAKE GENEVA, WISCONSIN
414-248-0505

50'


LINWOOD AVENUE

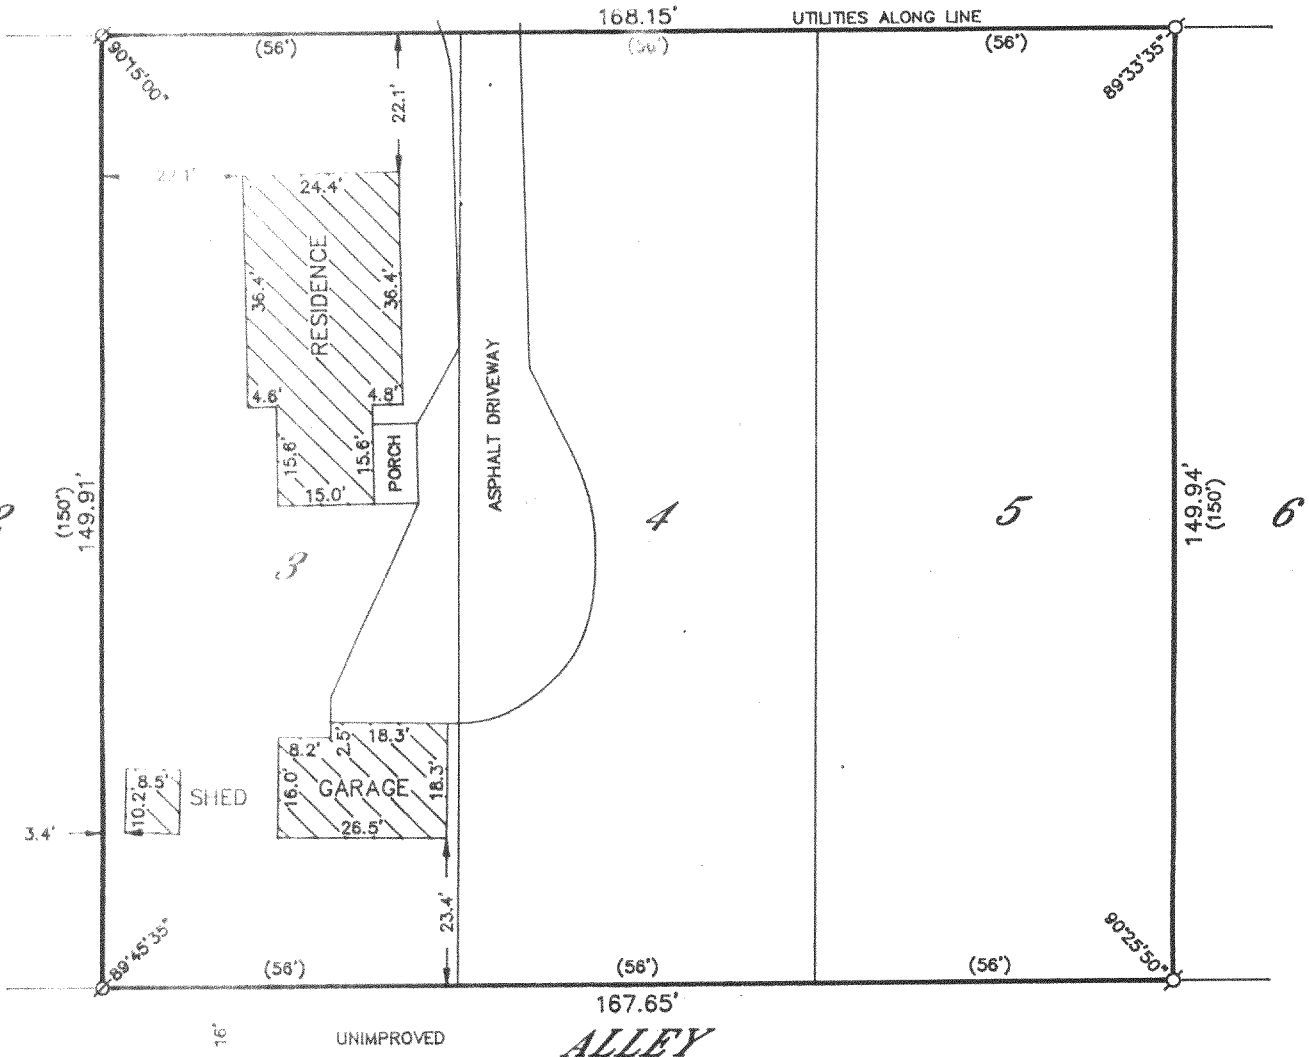

PLAT OF SUVEY OF

LOTS 3, 4 AND 5, BLOCK 8, GENEVITA
SUBDIVISION, TOWN OF LINN, WALWORTH
COUNTY, WISCONSIN.

ORDERED BY: CENTURY 21 KAVANAUGH REALTY
275 INTERCHANGE NORTH
LAKE GENEVA, WISCONSIN 53147

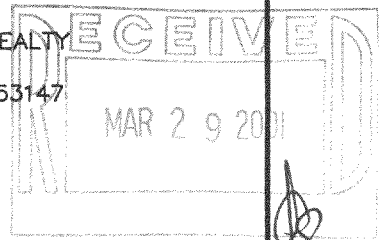


I HEREBY CERTIFY THAT I HAVE SURVEYED THE ABOVE DESCRIBED
PROPERTY AND THAT THE ABOVE MAP IS A TRUE REPRESENTATION
THEREOF AND SHOWS THE SIZE AND LOCATION OF THE PROPERTY,
ITS EXTERIOR BOUNDARIES, THE LOCATION OF ALL VISIBLE STRUCTURES
AND DIMENSIONS OF ALL PRINCIPAL BUILDINGS THEREON, BOUNDARY
FENCES, APPARENT EASEMENTS, ROADWAYS AND VISIBLE ENCROACH-
MENTS, IF ANY, TO THE BEST OF MY KNOWLEDGE AND BELIEF.

THIS SURVEY IS MADE FOR THE USE OF THE PRESENT OWNERS OF
THE PROPERTY AND ALSO THOSE WHO PURCHASE, MORTGAGE OR
GUARANTEE THE TITLE THERETO WITHIN ONE (1) YEAR FROM DATE
HEREOF.

Robert M. Baerenwald
ROBERT M. BAERENWALD
WISCONSIN REGISTERED LAND SURVEYOR, S-1508

Oct. 20, 1998
DATE JOB NO. 5989

NOTE: THIS IS NOT A CERTIFIED COPY UNLESS SEALED.

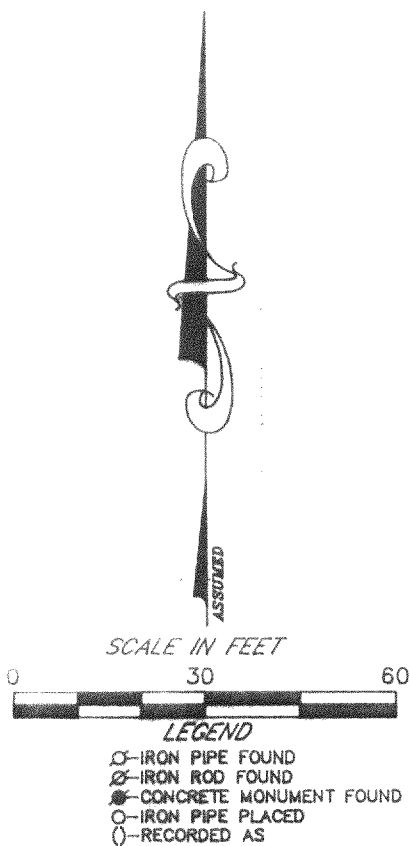

IGV-41
117-1990