

ABELL
SURVEYING & MAPPING

1140 SEQUOIA STREET • DELAVAN, WISCONSIN 53115
262-728-6737

LAKEVIEW ROAD

50 FEET WIDE

FOUND IRON ROD 2'
BELOW GROUND LEVEL.
SET 1" DIA. IRON
PIPE AT SURFACE

LOT 19

AREA 0.13 ACRES

LOWER LEVEL
WALK OUT

CONCRETE
COVER

HOUSE

WELL

WOOD RETAINING WALL
GRAVEL DRIVE

FOUND ADDITIONAL
IRON ROD 0.9'
NORTH OF CORNER

LOT 111

ORDERED BY: DAVID TOBISON
506 S. HOUGH STREET
BARRINGTON, IL 60010

PLAT OF SURVEY OF

LOT 19, LAKE GENEVA HIGHLANDS,
LOCATED IN T1N. 17E. WALWORTH
COUNTY, WISCONSIN.

N



SCALE 1"=20'

LEGEND

- -IRON PIPE FOUND
- -IRON ROD FOUND
- -1" DIA. IRON PIPE SET
- ✕ -CHAINLINK FENCE
- △ -UTILITY POLE
- -OVERHEAD UTILITY LINES
- () -RECORDED AS


I, DAVID F. ABELL, DO HEREBY CERTIFY THAT I HAVE SURVEYED THE PROPERTY HEREON
DESCRIBED ACCORDING TO THE OFFICAL RECORDS AND THAT THE PLAT HEREON IS A
CORRECT REPRESENTATION OF THE PROPERTY LINES TO THE BEST OF MY KNOWLEDGE AND
BELIEF

David F. Abell

DAVID F. ABELL
WISCONSIN REGISTERED LAND SURVEYOR, S-1596

October 25, 2000

DATE JOB NUMBER - 00148
NOTE: THIS IS NOT A CERTIFIED COPY UNLESS SEALED.

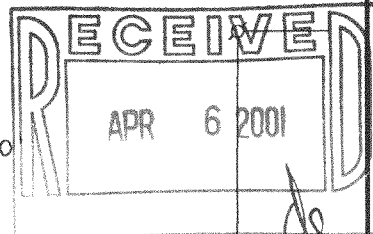

HIGHLAND ROAD

ILGH-18
117-1996