


PREPARED FOR:
RONALD E. WALKINGTON, PRESIDENT
LAKE GENEVA HIGHLANDS COOPERATIVE
728 SHADY AVENUE
GENEVA, IL 60134

PLAT OF SURVEY

- OF -

WEST BEACH ROAD, EAST BEACH ROAD, AND LOT "A" OF LAKE GENEVA HIGHLANDS;
A SUBDIVISION LOCATED IN THE SOUTHEAST 1/4 OF SECTION 8, TOWNSHIP 1 NORTH,
RANGE 17 EAST, WALWORTH COUNTY, WISCONSIN.

J.K. SURVEYING INC.
N3705 WILLOWBEND LANE
LAKE GENEVA, WI, 53147
262-248-3697

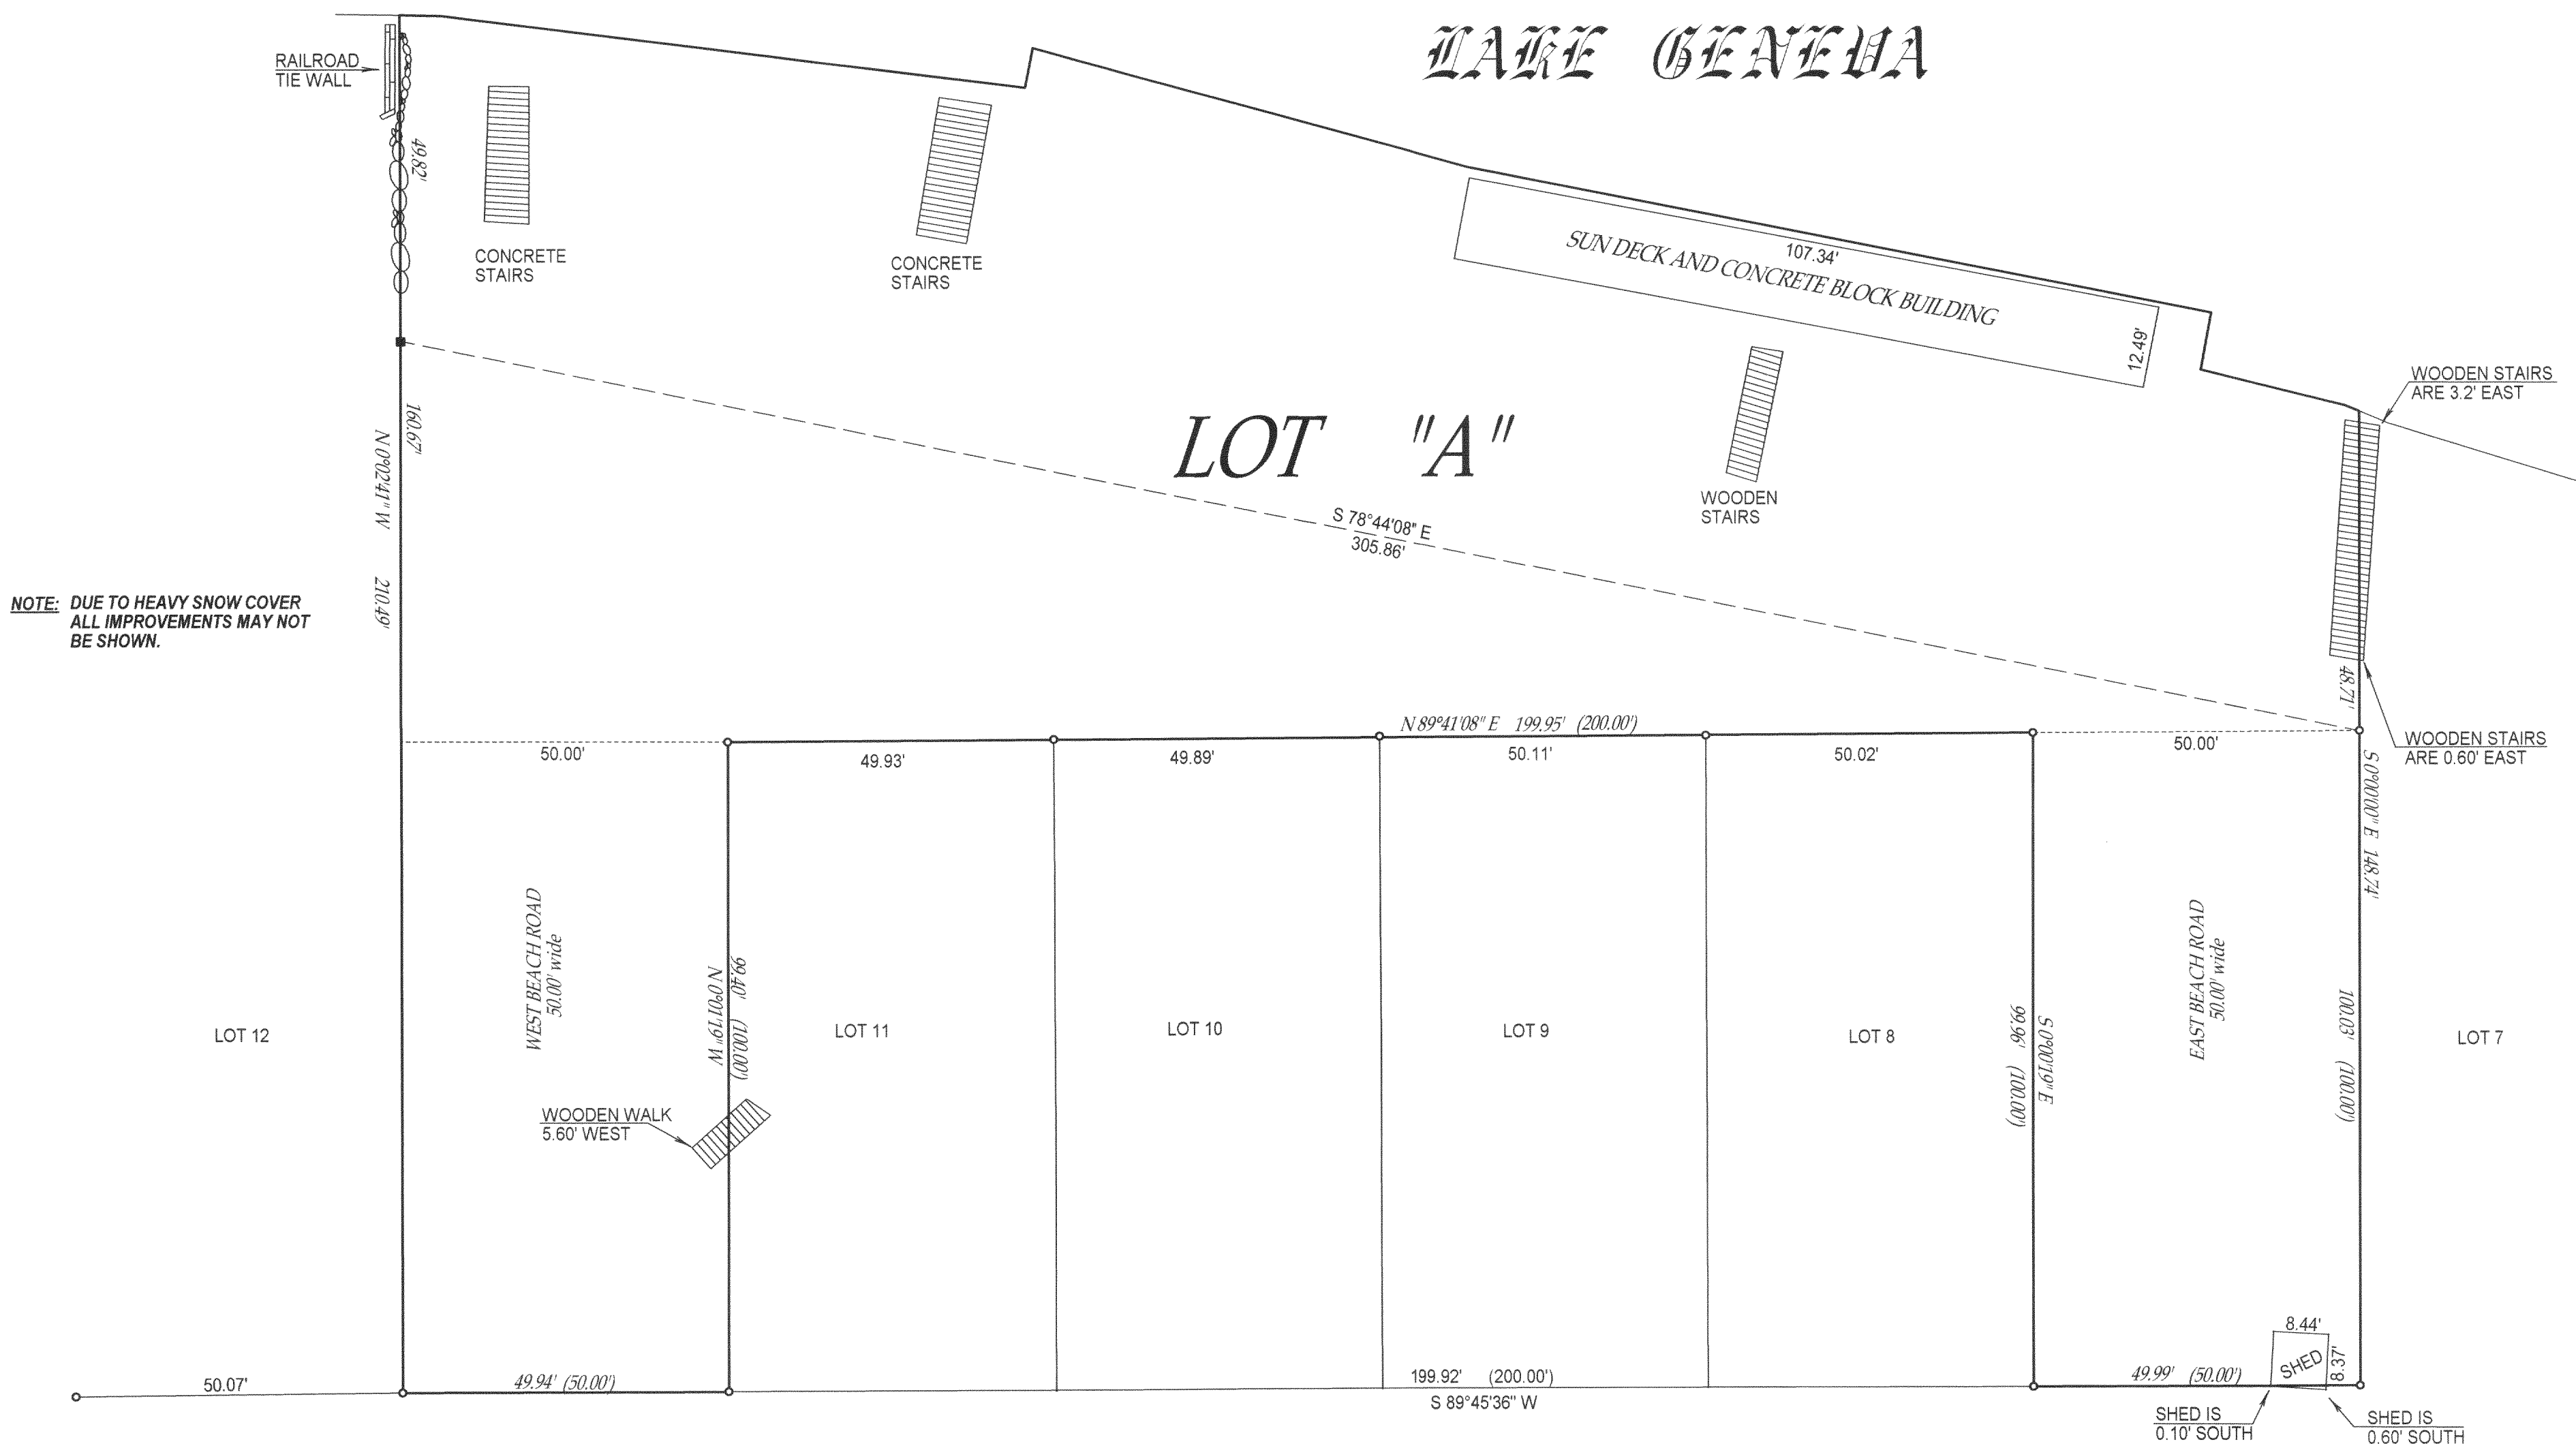

NOTE: DUE TO HEAVY SNOW COVER
ALL IMPROVEMENTS MAY NOT
BE SHOWN.

LAKE VIEW ROAD

(50.00' WIDE)

COMPARE LEGAL DESCRIPTION ABOVE AND DRAWING WITH DEED. FOR BUILDING RESTRICTIONS AND
EASEMENTS NOT SHOWN REFER TO DEED. ABSTRACT SOURCES AND LOCAL MUNICIPAL CODES. NOTIFY
THE SURVEYOR IMMEDIATELY OF ANY DISCREPANCY.



"I hereby certify that I have surveyed the above described property and that
the above map is a true representation thereof and shows the size and
location of all visible structures, apparent easements and encroachments
if any."

This survey is made for the present owners of the property, and those who
purchase, mortgage, or guarantee the title thereto, within one year from
the date hereof.

DATED THIS 8 TH, DAY OF JANUARY 20 01.

- ⊙ = found concrete monument
with brass cap
- = found iron bar
- = found iron pipe
- = set iron pipe
- = set iron bar

SCALE 1" = 20'
JOB #00-602
TAX ID # ILGH-A

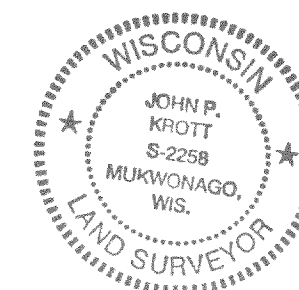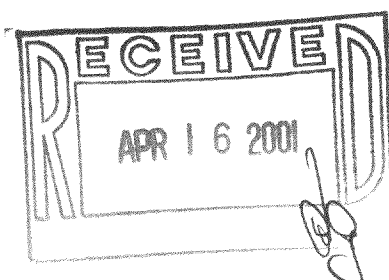

JOHN KROTT S - 2258
Wisconsin Registered Land Surveyor
(original if signed in red)

ILGH-78 117-1999