
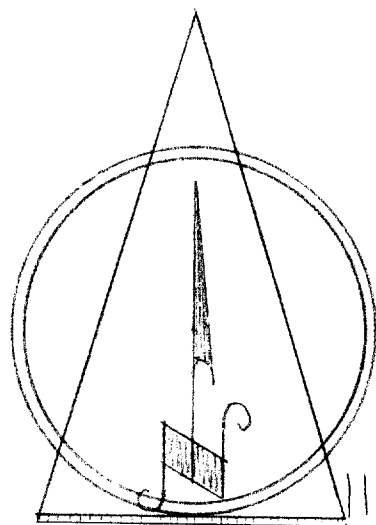


117-1B

70-63

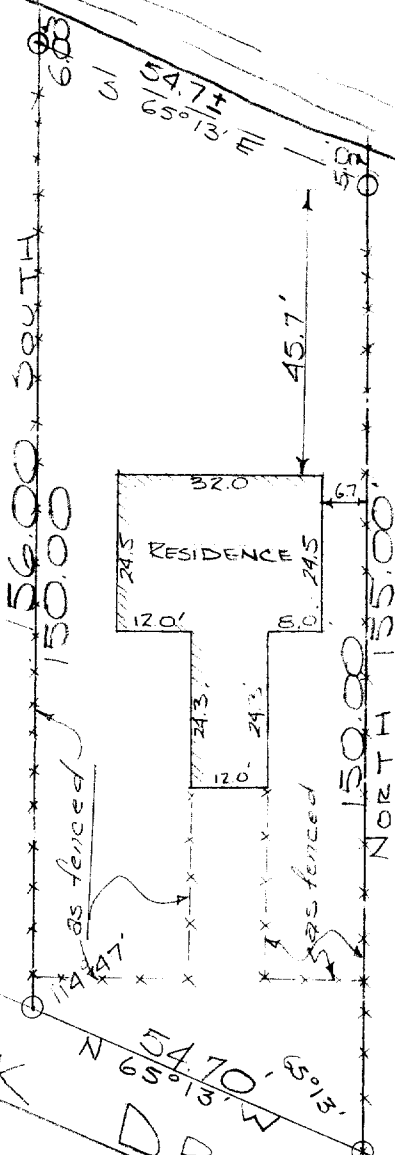


GENEVA LAKE

9
O-INDICATES IRON PIPE

DESCRIPTION: Lot 10 of Lake Geneva Beach Subdivision located in Section 11, T. 1 N., R. 17 E., Walworth County, Wisconsin.

CERTIFICATE: I, James F. Biagi, surveyor, do hereby certify that I have surveyed the property hereon described.

AUGUST 6, 1963.

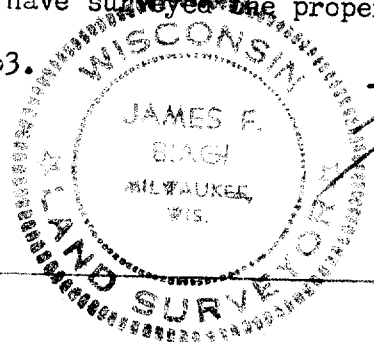

James F. Biagi RLS 272

IL-8-7

117-1B