
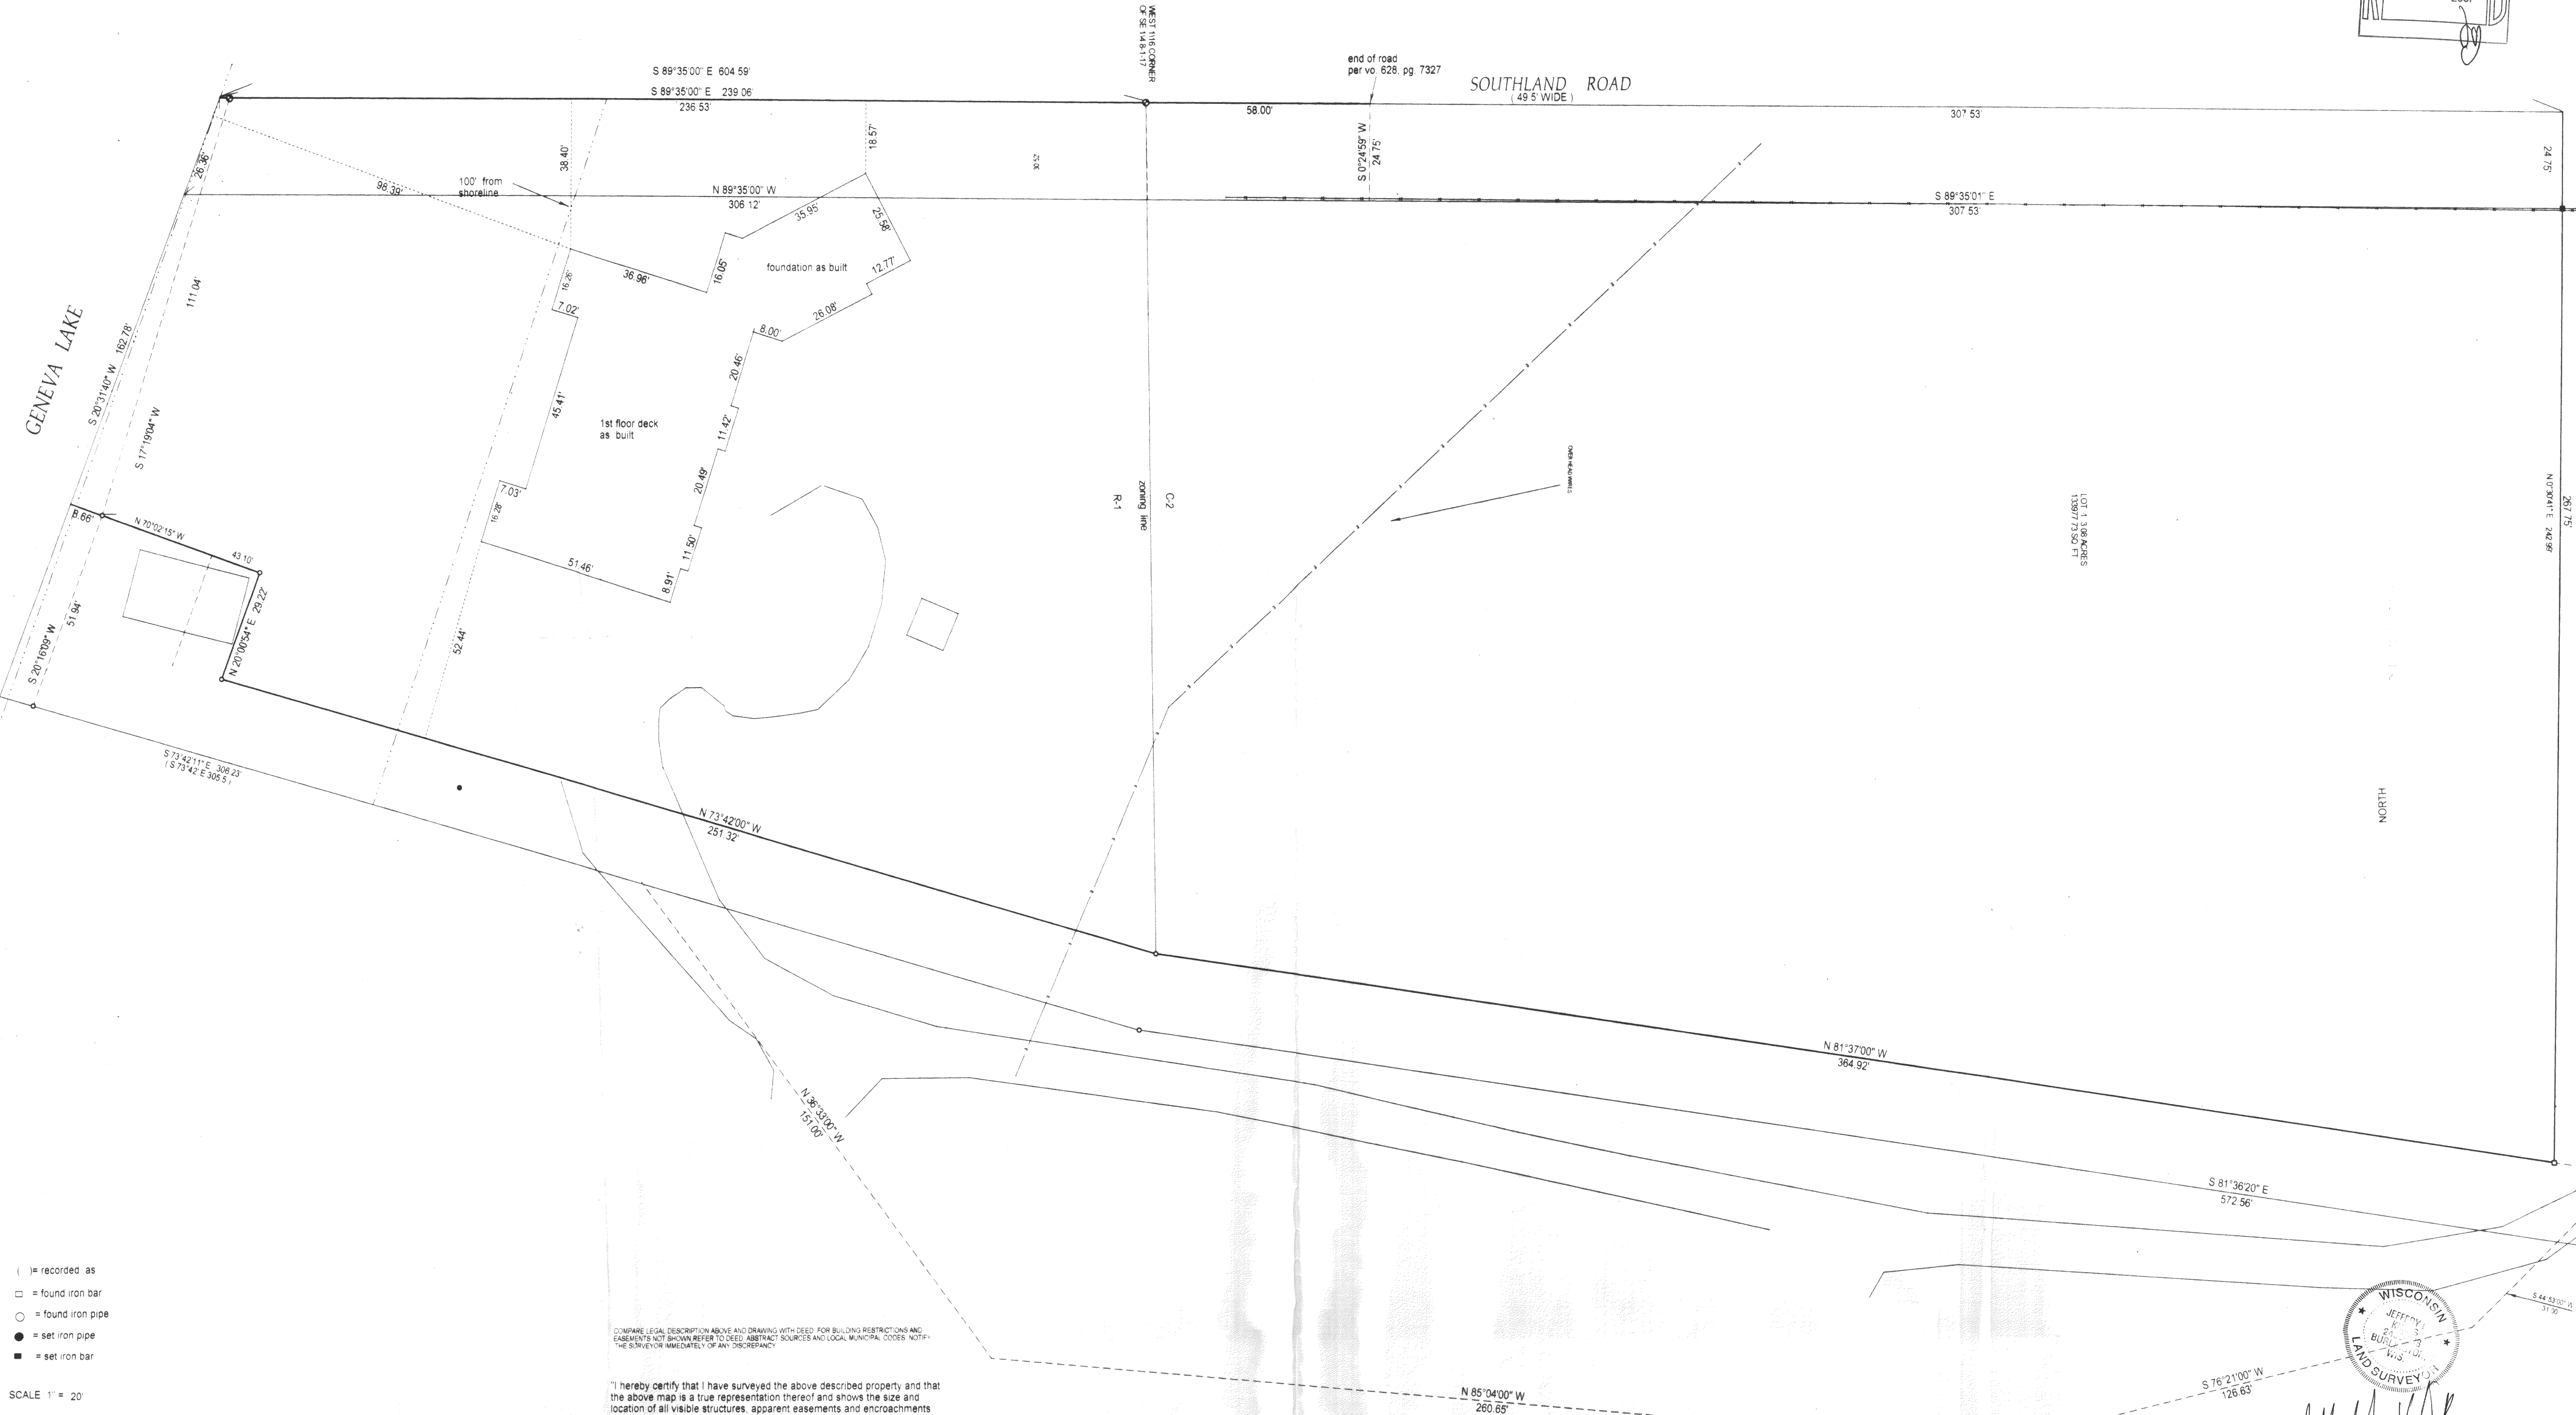


PLAT OF SURVEY

J.K. SURVEYING INC.
13705 WILLOWBEND LANE
LAKE GENEVA, WI 53147
262-248-1097

PREPARED FOR REEVES CONSTRUCTION

OF
LOT 1 OF CERTIFIED SURVEY MAP 3258, BEING A REDIVISION OF CERTIFIED SURVEY MAP 2540,
BEING A PART OF THE SOUTHEAST 1/4 OF THE SOUTHWEST 1/4 AND THE SOUTHWEST 1/4 OF THE
SOUTHEAST 1/4 OF SECTION 8, TOWN 1 NORTH, RANGE 17 EAST, TOWN OF LINN, WALWORTH
COUNTY, WISCONSIN

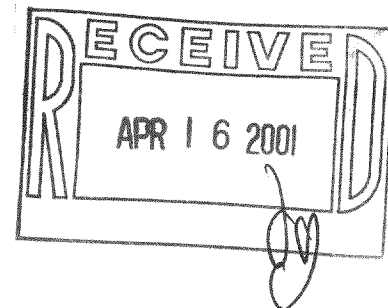


- () = recorded as
- = found iron bar
- = found iron pipe
- = set iron pipe
- = set iron bar

SCALE 1" = 20'
JOB # 00-567
TAX ID # 1A32800001

"I hereby certify that I have surveyed the above described property and that the above map is a true representation thereof and shows the size and location of all visible structures, apparent easements and encroachments if any."
This survey is made for the present owners of the property, and those who purchase, mortgage, or guarantee the title thereto, within one year from the date hereof.

DATED THIS 29 TH DAY OF JANUARY 2001.

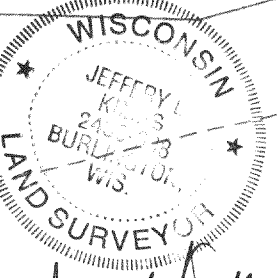

Jeffrey L. Knapp
JEFFREY L. KNAPP, R.S. 1436
(ORIGINAL IF SIGNED IN RED)

1A-3258-1
117-2000