


AMBIT LAND SURVEYING
P. O. BOX 42
Bassett, WI. 53101

PLAT OF SURVEY OF


PHONE 262-537-4874
FAX 262-537-4221

Lots 1 and 2, Block 7 of LAKE GENEVA TERRACE, being a subdivision of the West Half of the Northwest Quarter of Section 15, Township 1 North, Range 17 East of the 4th Principal Meridian, Town of Linn, Walworth County, Wisconsin.

LORTIN (PLATTED LORTIN PLAZA) AVENUE 100' R/W

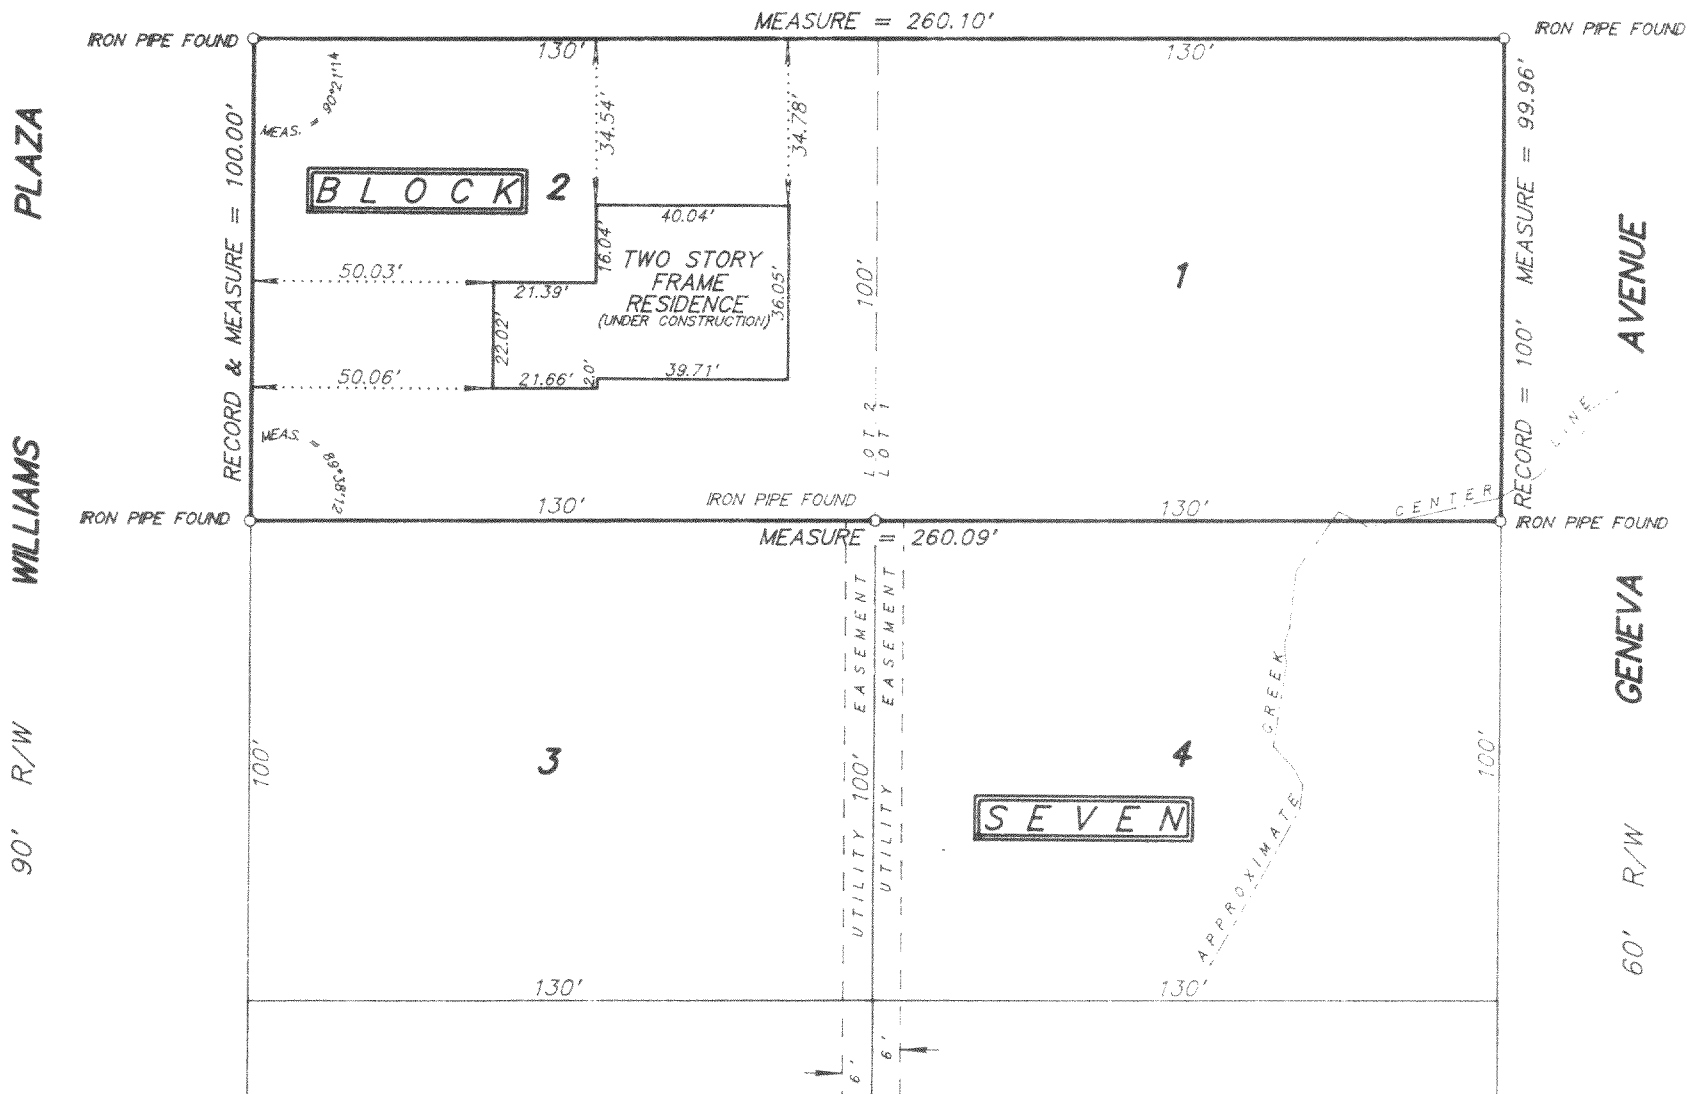

NOTE: BUILDING DIMENSIONS ARE ALONG FOUNDATION WALLS
AND BUILDING TIES ARE TO FOUNDATION CORNERS

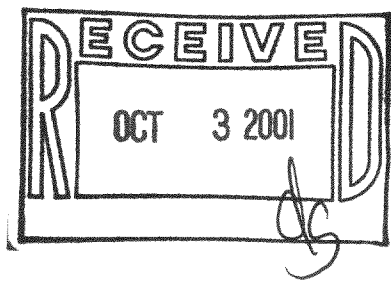

SCALE 1 inch = 40 feet

ORDERED BY A. Pierce / A. R. Pierce & Associates

JOB NO. 01055

I hereby certify that I have surveyed the above described property and the above plat is a true representation thereof and shows the size and location of the property, its exterior boundaries, the location and dimensions of all visible structures thereon, boundary fences, apparent easements and roadways and visible encroachments, if any.

This survey is made for the exclusive use of the present owners of the property, and also those who purchase, mortgage, or guarantee the title thereto within one year from the date hereof.

Dated at Bassett, Wisconsin this _____ day of _____, 2001

Mark A. Bolender
Wisconsin Registered Land Surveyor S - 1784

ILGT-26A

117-2033