


**REGISTERED PROFESSIONAL LAND SURVEYOR
LAKE GENEVA, WISCONSIN**

Plat of Survey of
A parcel of land located
in part of lots 1 through
5, Hutchinsons Subdivision
Section 3, T 1 N, R 17 E,
Walworth County, Wisconsin.

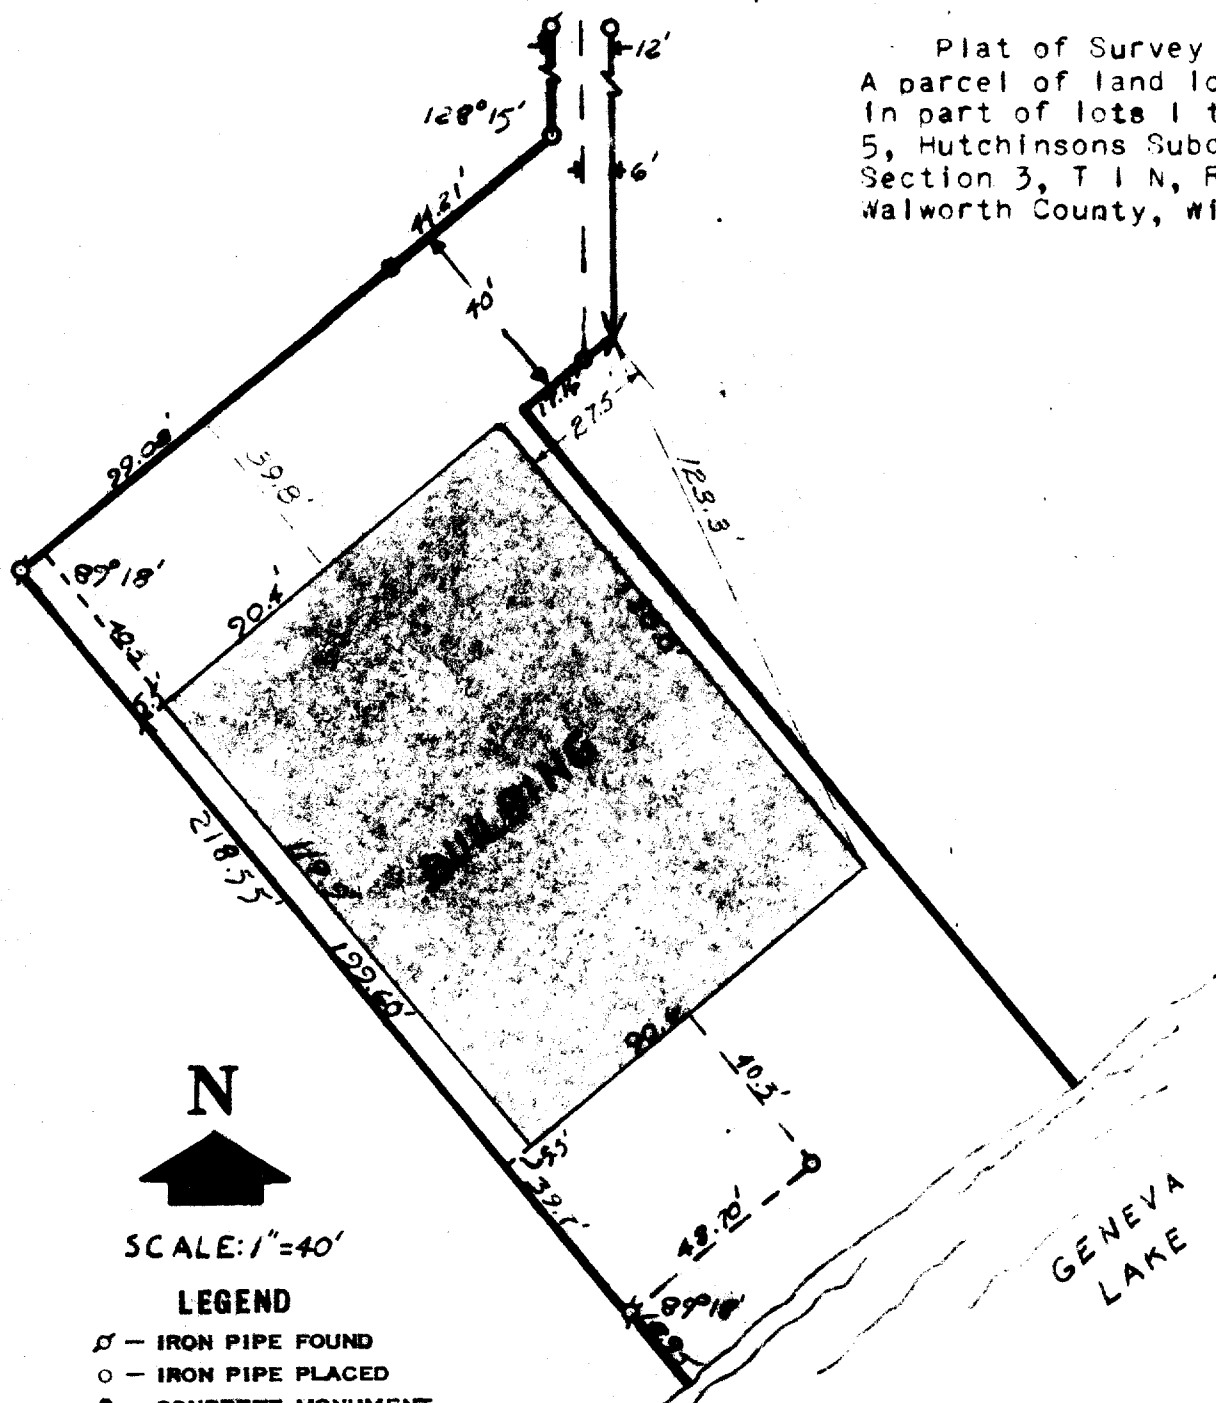

I, **HAROLD H. KOLB**, DO HEREBY CERTIFY THAT I HAVE SURVEYED THE PROPERTY HEREON DESCRIBED ACCORDING TO THE OFFICIAL RECORDS, AND THAT THE PLAT HEREON IS A CORRECT REPRESENTATION OF THE LOT LINES.

Harold H. Kolb
HAROLD H. KOLB
WISCONSIN REGISTERED LAND SURVEYOR, S-187
DATE July 12, 1967

TH-1
TH-3

117-205

~~14-115~~