


BEACH  
40  
ROAD

Updating and recertification ordered by:  
Kenneth Miller  
P. O. Box 1026  
Addison, IL 60101-1026

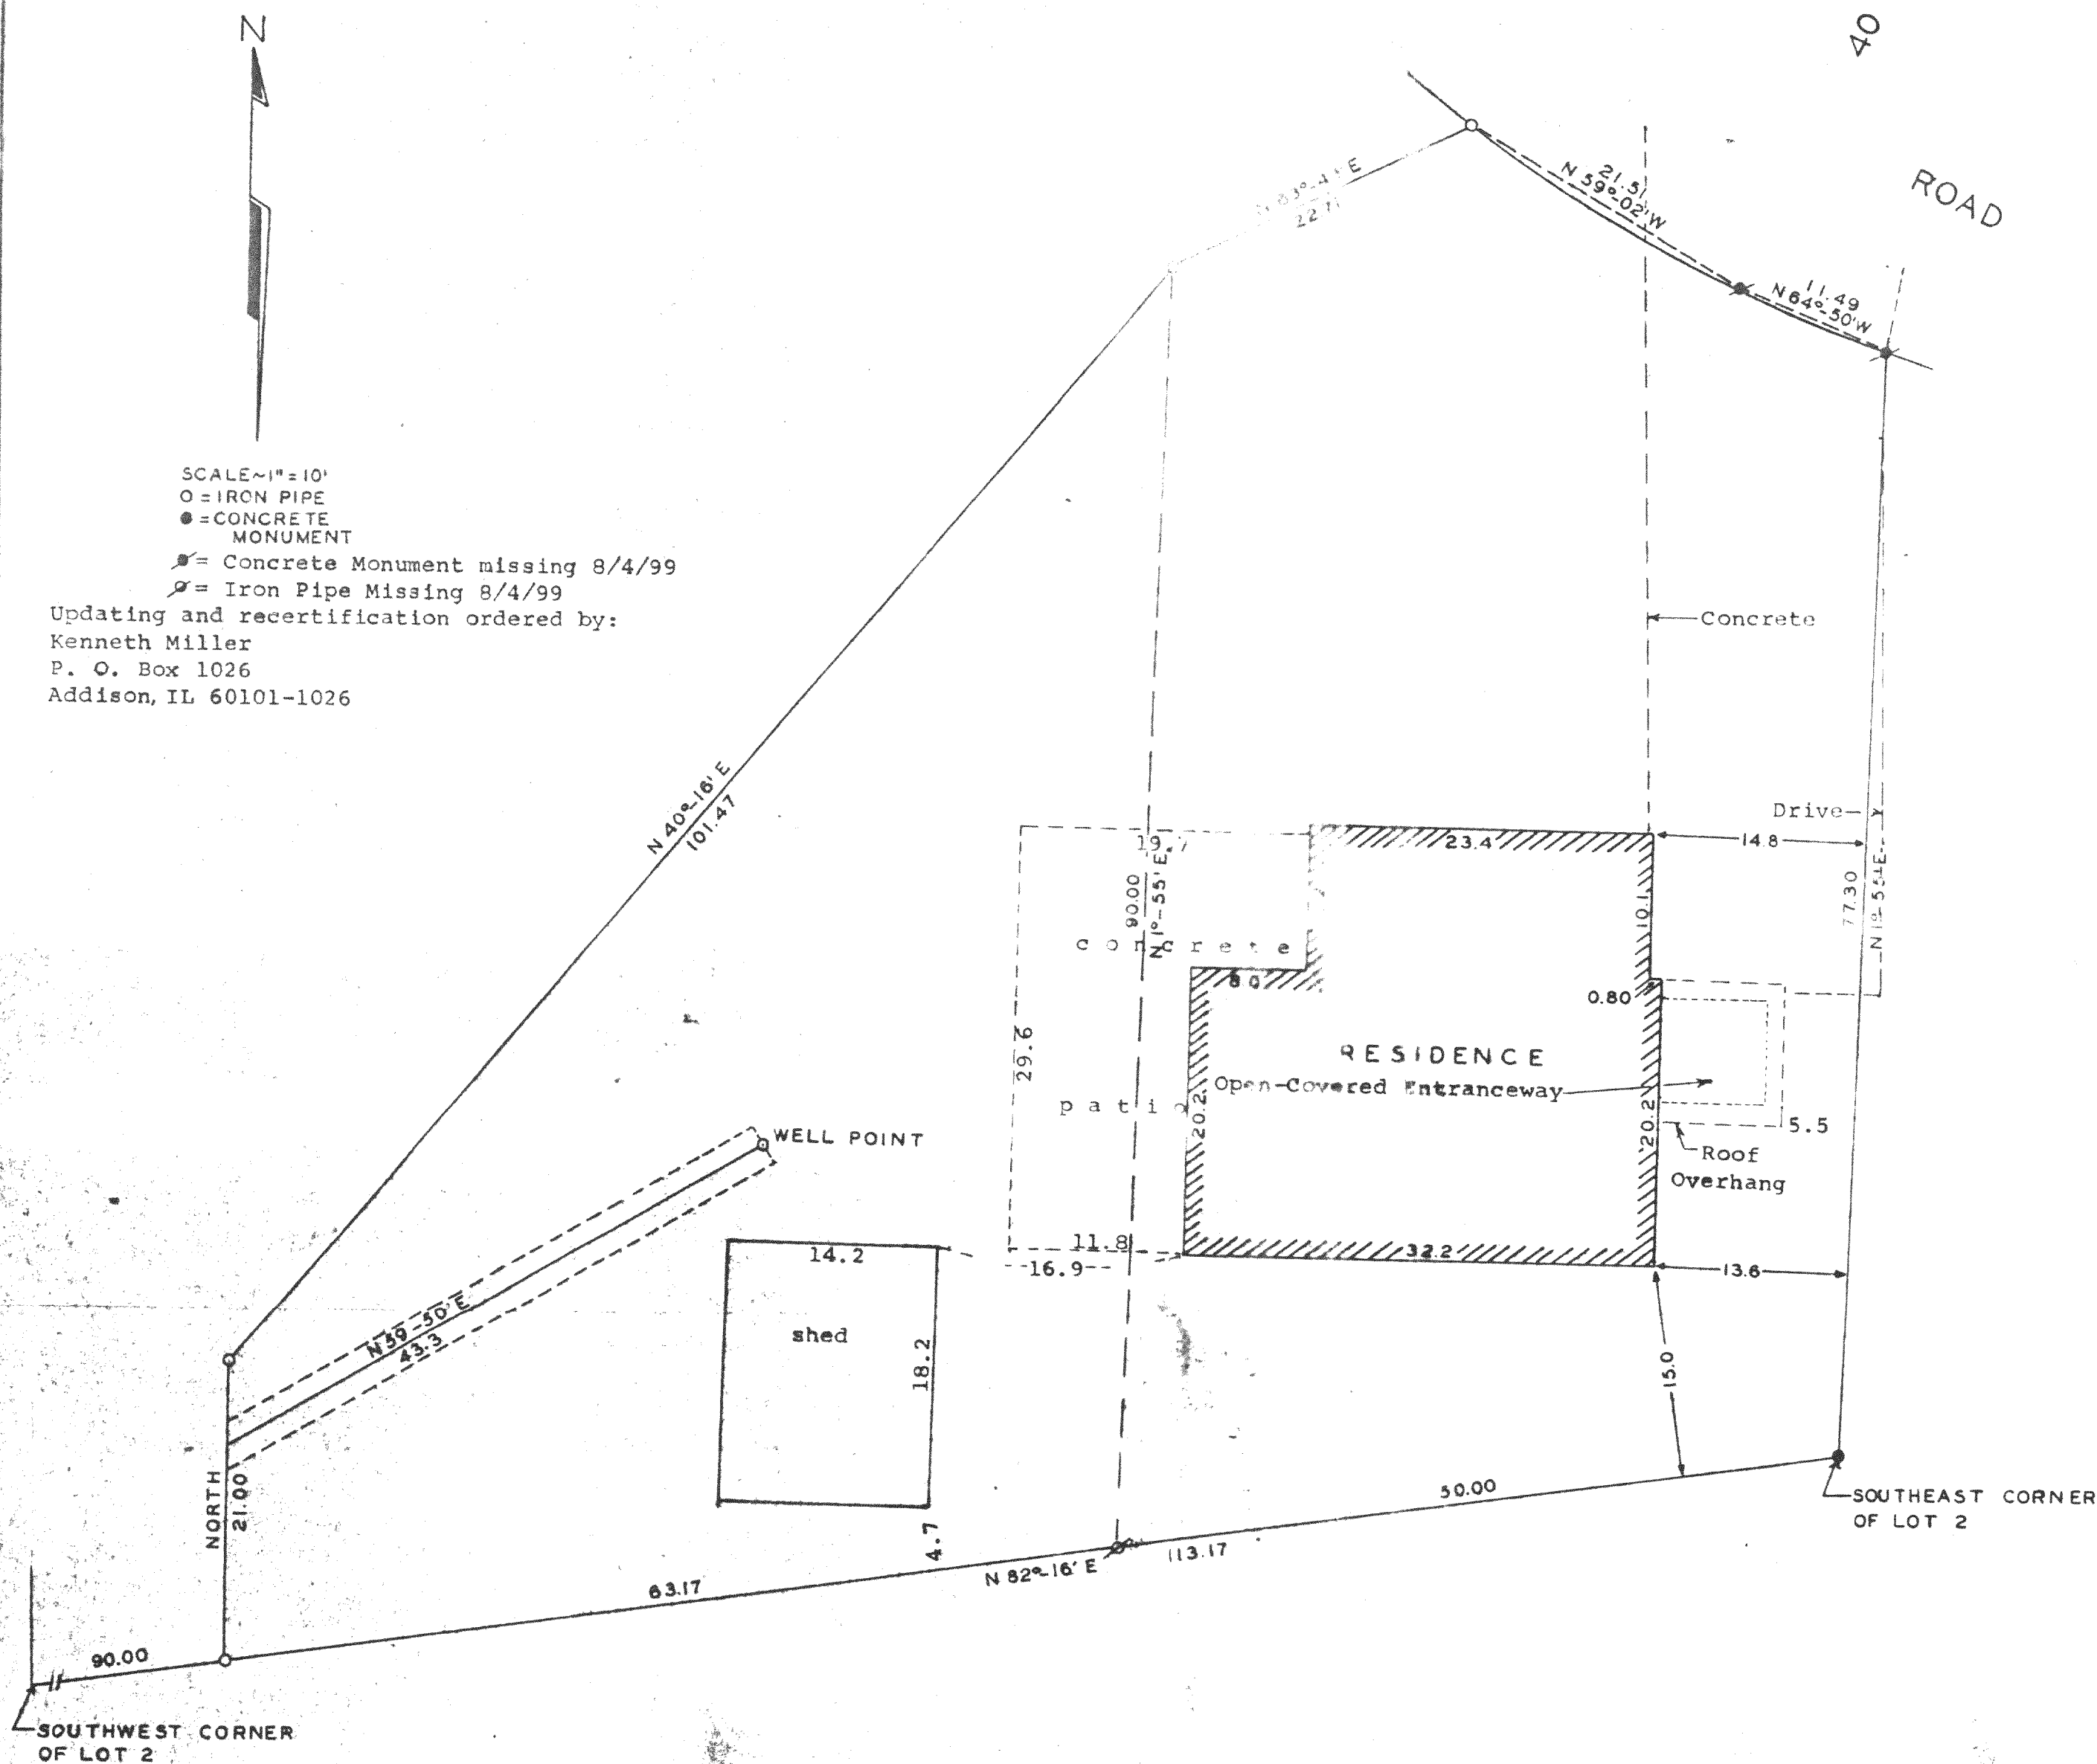

George T. Dunham  
George T. Dunham, Wis. Land Surveyor No. S-306

Updated and recertified to this  
4th day of August, 1999

George F. Dunham  
George F. Dunham, Surveyor

