

PREPARED FOR:
 RODNEY WHETLOW
 KEEFE REALTY
 751 GENEVA PARKWAY
 LAKE GENEVA WI 53147

PLAT OF SURVEY



- OF -

J.K. SURVEYING INC.
 N3705 WILLOWBEND LANE
 LAKE GENEVA, WI, 53147
 262-248-3697

THE SOUTHWEST PART OF LOT 3, CERTIFIED SURVEY NO. 43 AS RECORDED IN VOLUME 1 OF CERTIFIED SURVEYS AT PAGE 43 IN THE OFFICE OF THE REGISTER OF DEEDS FOR WALWORTH, WISCONSIN, DESCRIBED AS FOLLOWS, TO-WIT: BEGINNING AT THE MOST WESTERLY CORNER OF SAID LOT 3; THENCE NORTH 20 DEGREES 57' EAST 7.00 FEET; THENCE SOUTH 85 DEGREES 49' EAST 233.77 FEET; THENCE SOUTH 31 DEGREES 49' EAST 60.04 FEET; THENCE SOUTH 57 DEGREES 56' 40" WEST 89.57 FEET; THENCE SOUTH 86 DEGREES 42' 20" WEST 97.23; THENCE NORTH 39 DEGREES 27' WEST 148.51 FEET TO THE PLACE OF BEGINNING.

SUBJECT TO AN EASEMENT 5 FEET IN WIDTH OVER AND ACROSS THE MOST EASTERLY PART AND MOST SOUTHERLY PART OF THE REAL ESTATE ABOVE DESCRIBED.

LAKE SHORE DRIVE
 50.00' WIDE

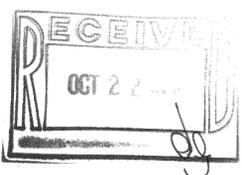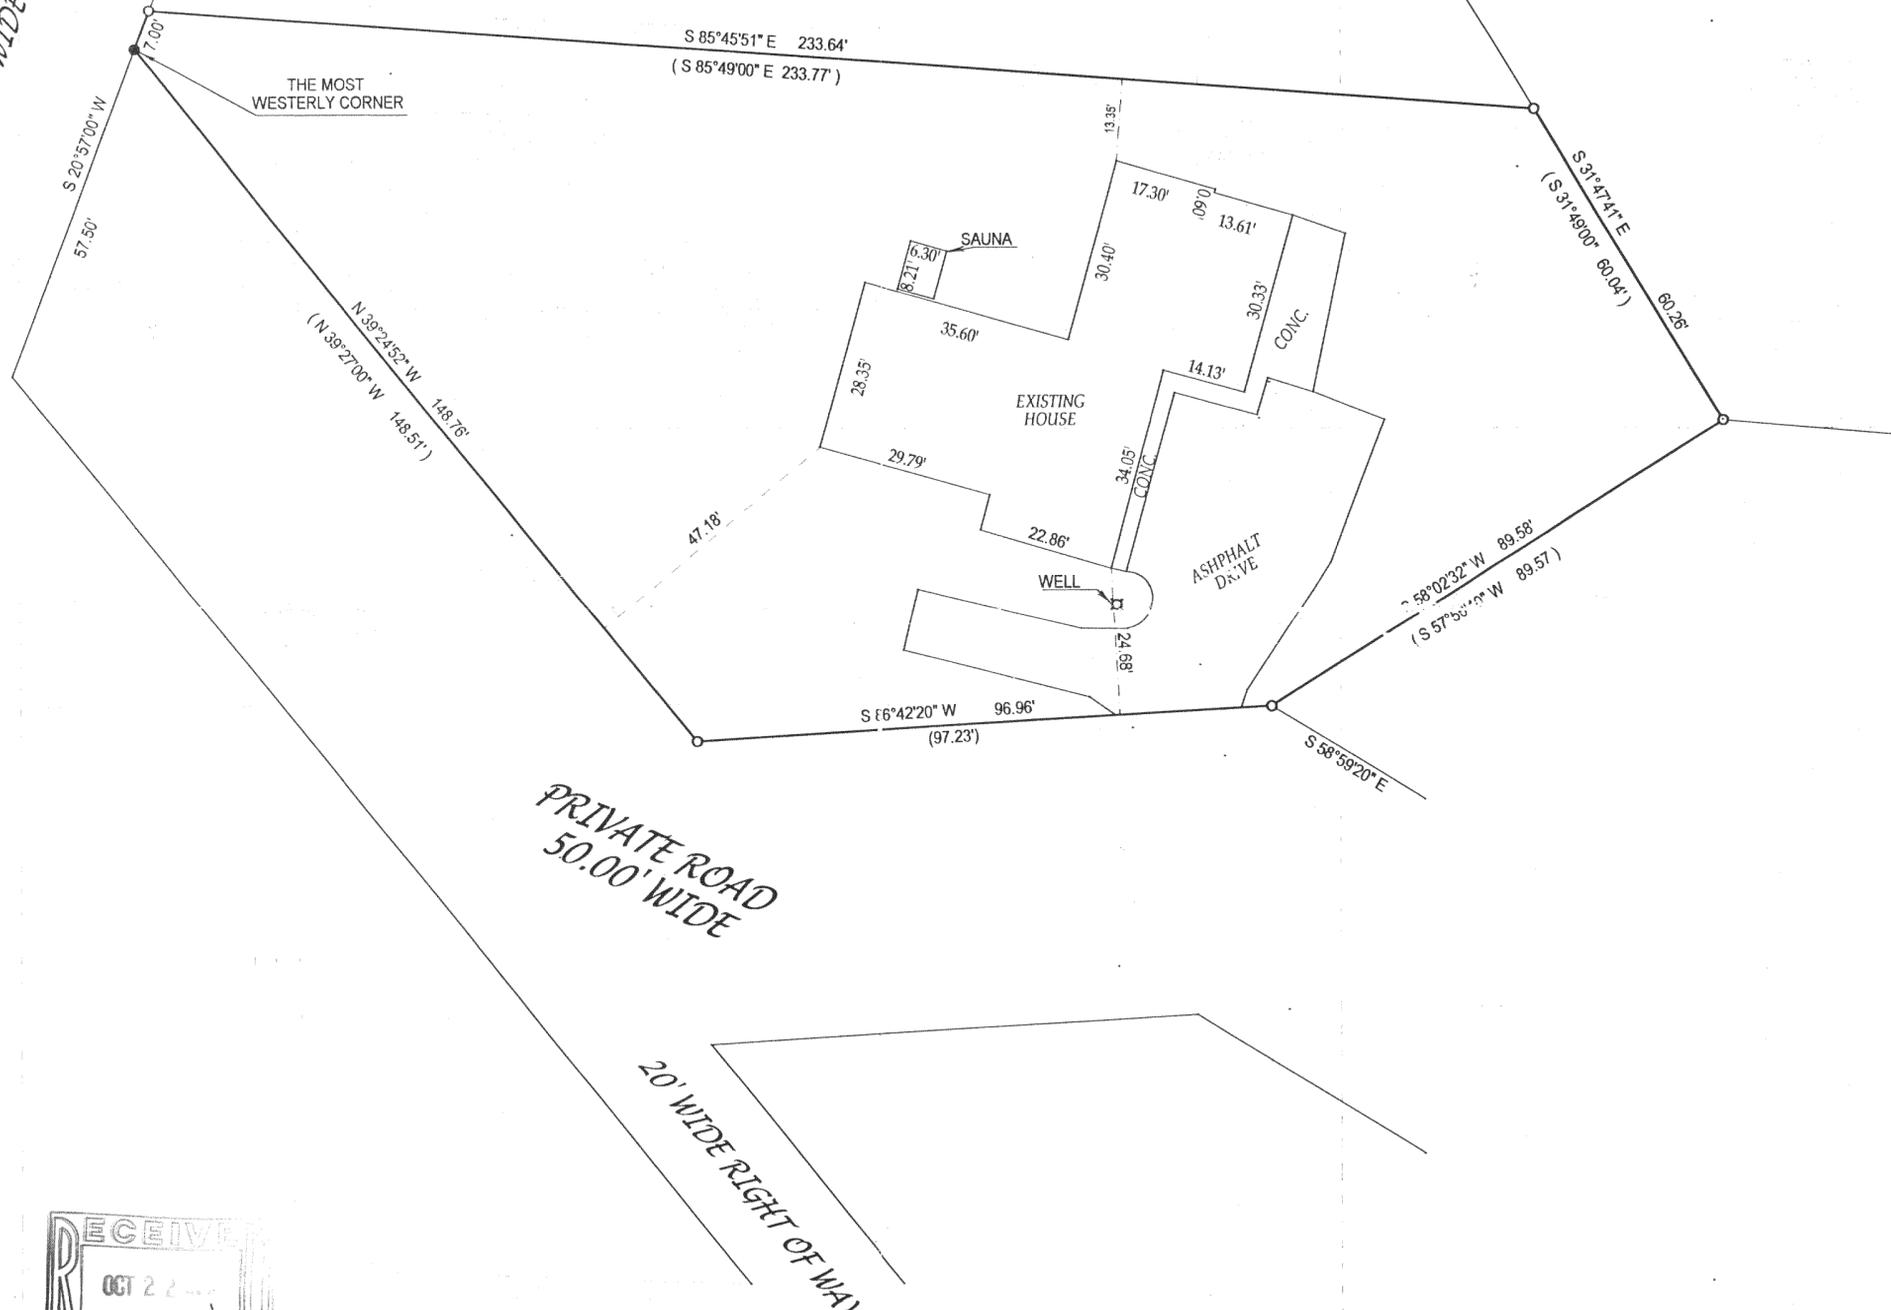

COMPARE LEGAL DESCRIPTION ABOVE AND DRAWING WITH DEED. FOR BUILDING RESTRICTIONS AND EASEMENTS NOT SHOWN, REFER TO DEED, ABSTRACT SOURCES AND LOCAL MUNICIPAL CODES. NOTIFY THE SURVEYOR IMMEDIATELY OF ANY DISCREPANCY.

"I hereby certify that I have surveyed the above described property and that the above map is a true representation thereof and shows the size and location of all visible structures, apparent easements and encroachments if any."

This survey is made for the present owners of the property, and those who purchase, mortgage, or guarantee the title thereto, within one year from the date hereof.

DATED THIS 7 TH, DAY OF SEPTEMBER 20 01

- = found iron bar
- = found iron pipe
- = set iron pipe
- = set iron bar

SCALE 1" = 20'

JOB # 01-389

TAX ID # IA 430003A



John F. Krott
 JOHN KROTT S - 2258
 Wisconsin Registered Land Surveyor
 (original if signed in red)

JA-43-3A

117-2060