


LOTS 16 AND 17 AND TWO 10 FOOT STRIPS OF LAND ON THE WATER FRONT DESIGNATED AS PARCELS NO. 8 AND 9 OF ALTA VISTA ESTATES, LOCATED IN GOVERNMENT LOT 2, AND IN THE SOUTHEAST 1/4 OF THE NORTHEAST 1/4 OF SECTION 4, TOWN 1 NORTH, RANGE 17 EAST, WALWORTH COUNTY, WISCONSIN.



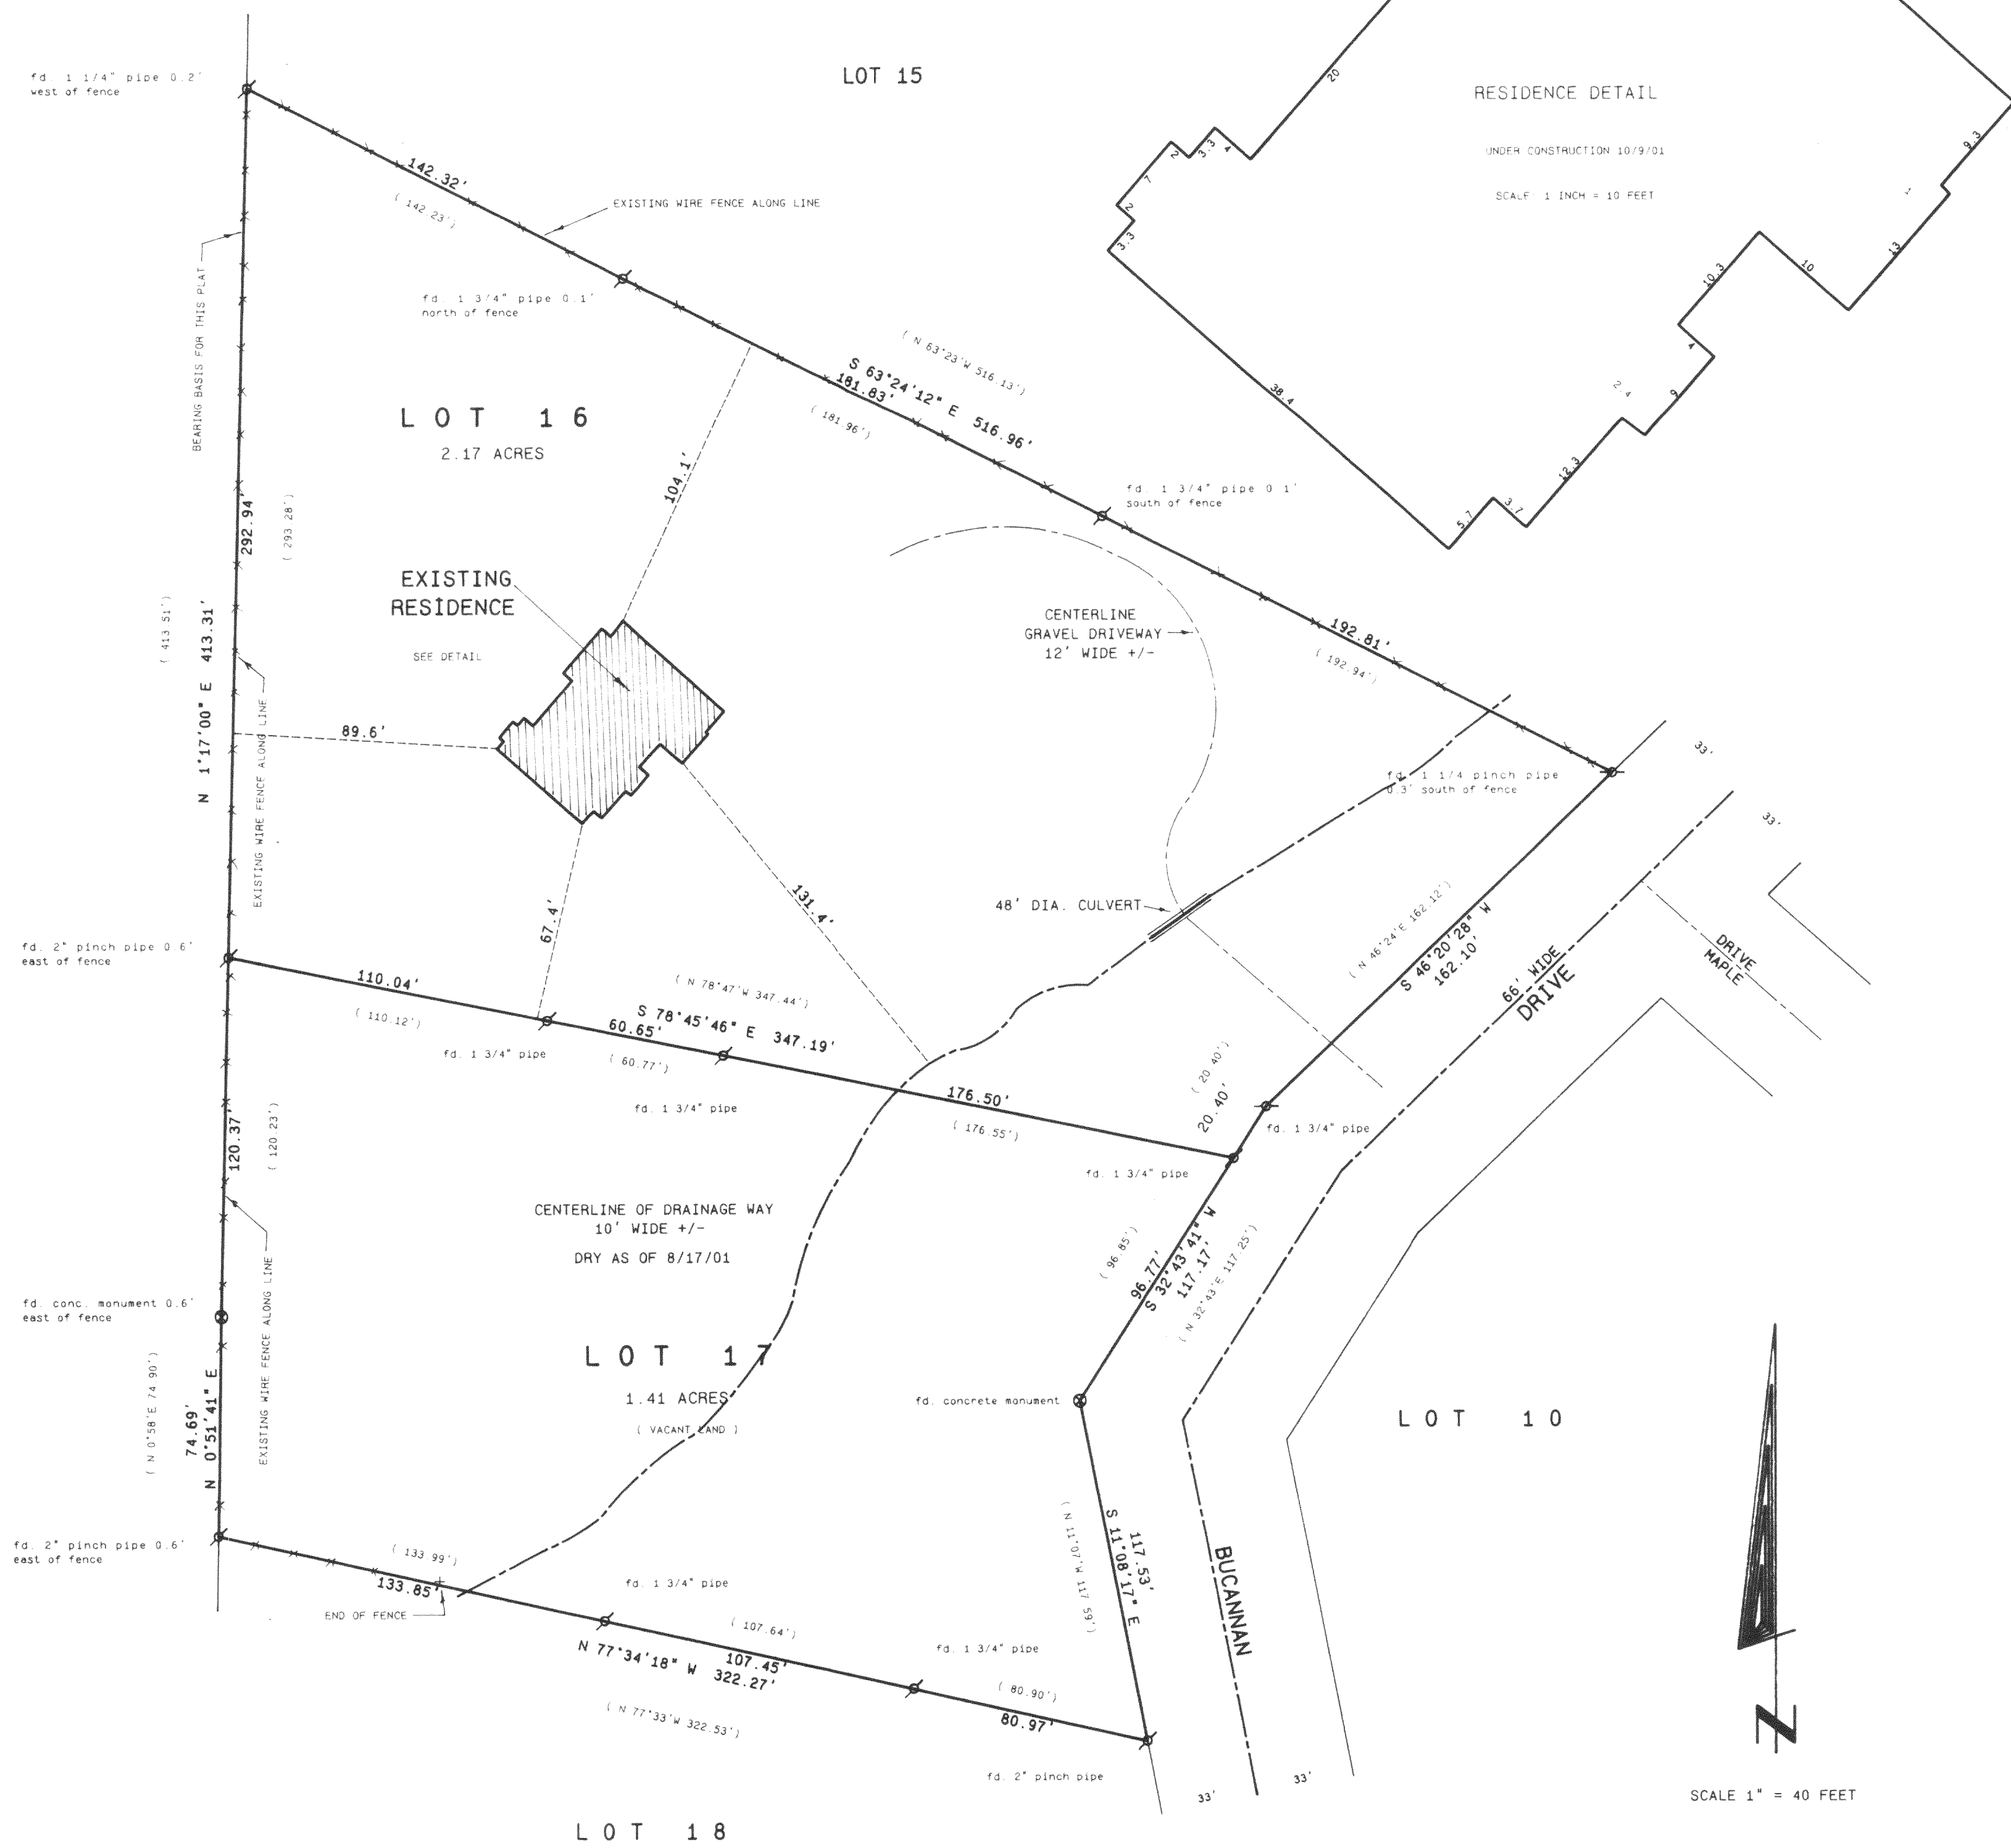


WARRANTY DEED RECORDED IN VOL. 619 P. 487
AS DOCUMENT NO. 570600 DATED JUNE 3rd,
1965. ERWIN J JANICKE AND GERDA JANICKE,
husband and wife TO RICHARD H. HOWLAND and
MARILYN M. HOWLAND, his wife.

OWNERS: JOHN and JEAN BLIX
549 SIOUX DRIVE
FONTANA, WI. 53125

REVISED 8/17/01 TO SHOW PROPOSED
RESIDENCE, DRAINAGE WAY, DRIVE AND
CULVERT.

REVISED 10/10/01 TO SHOW EXISTING
RESIDENCE "AS BUILT".

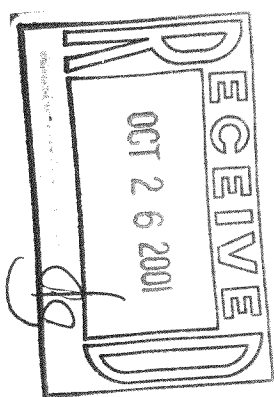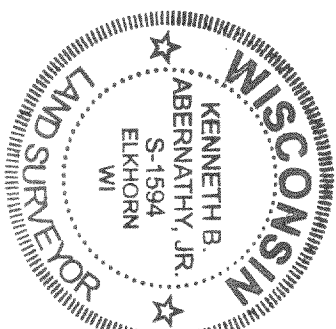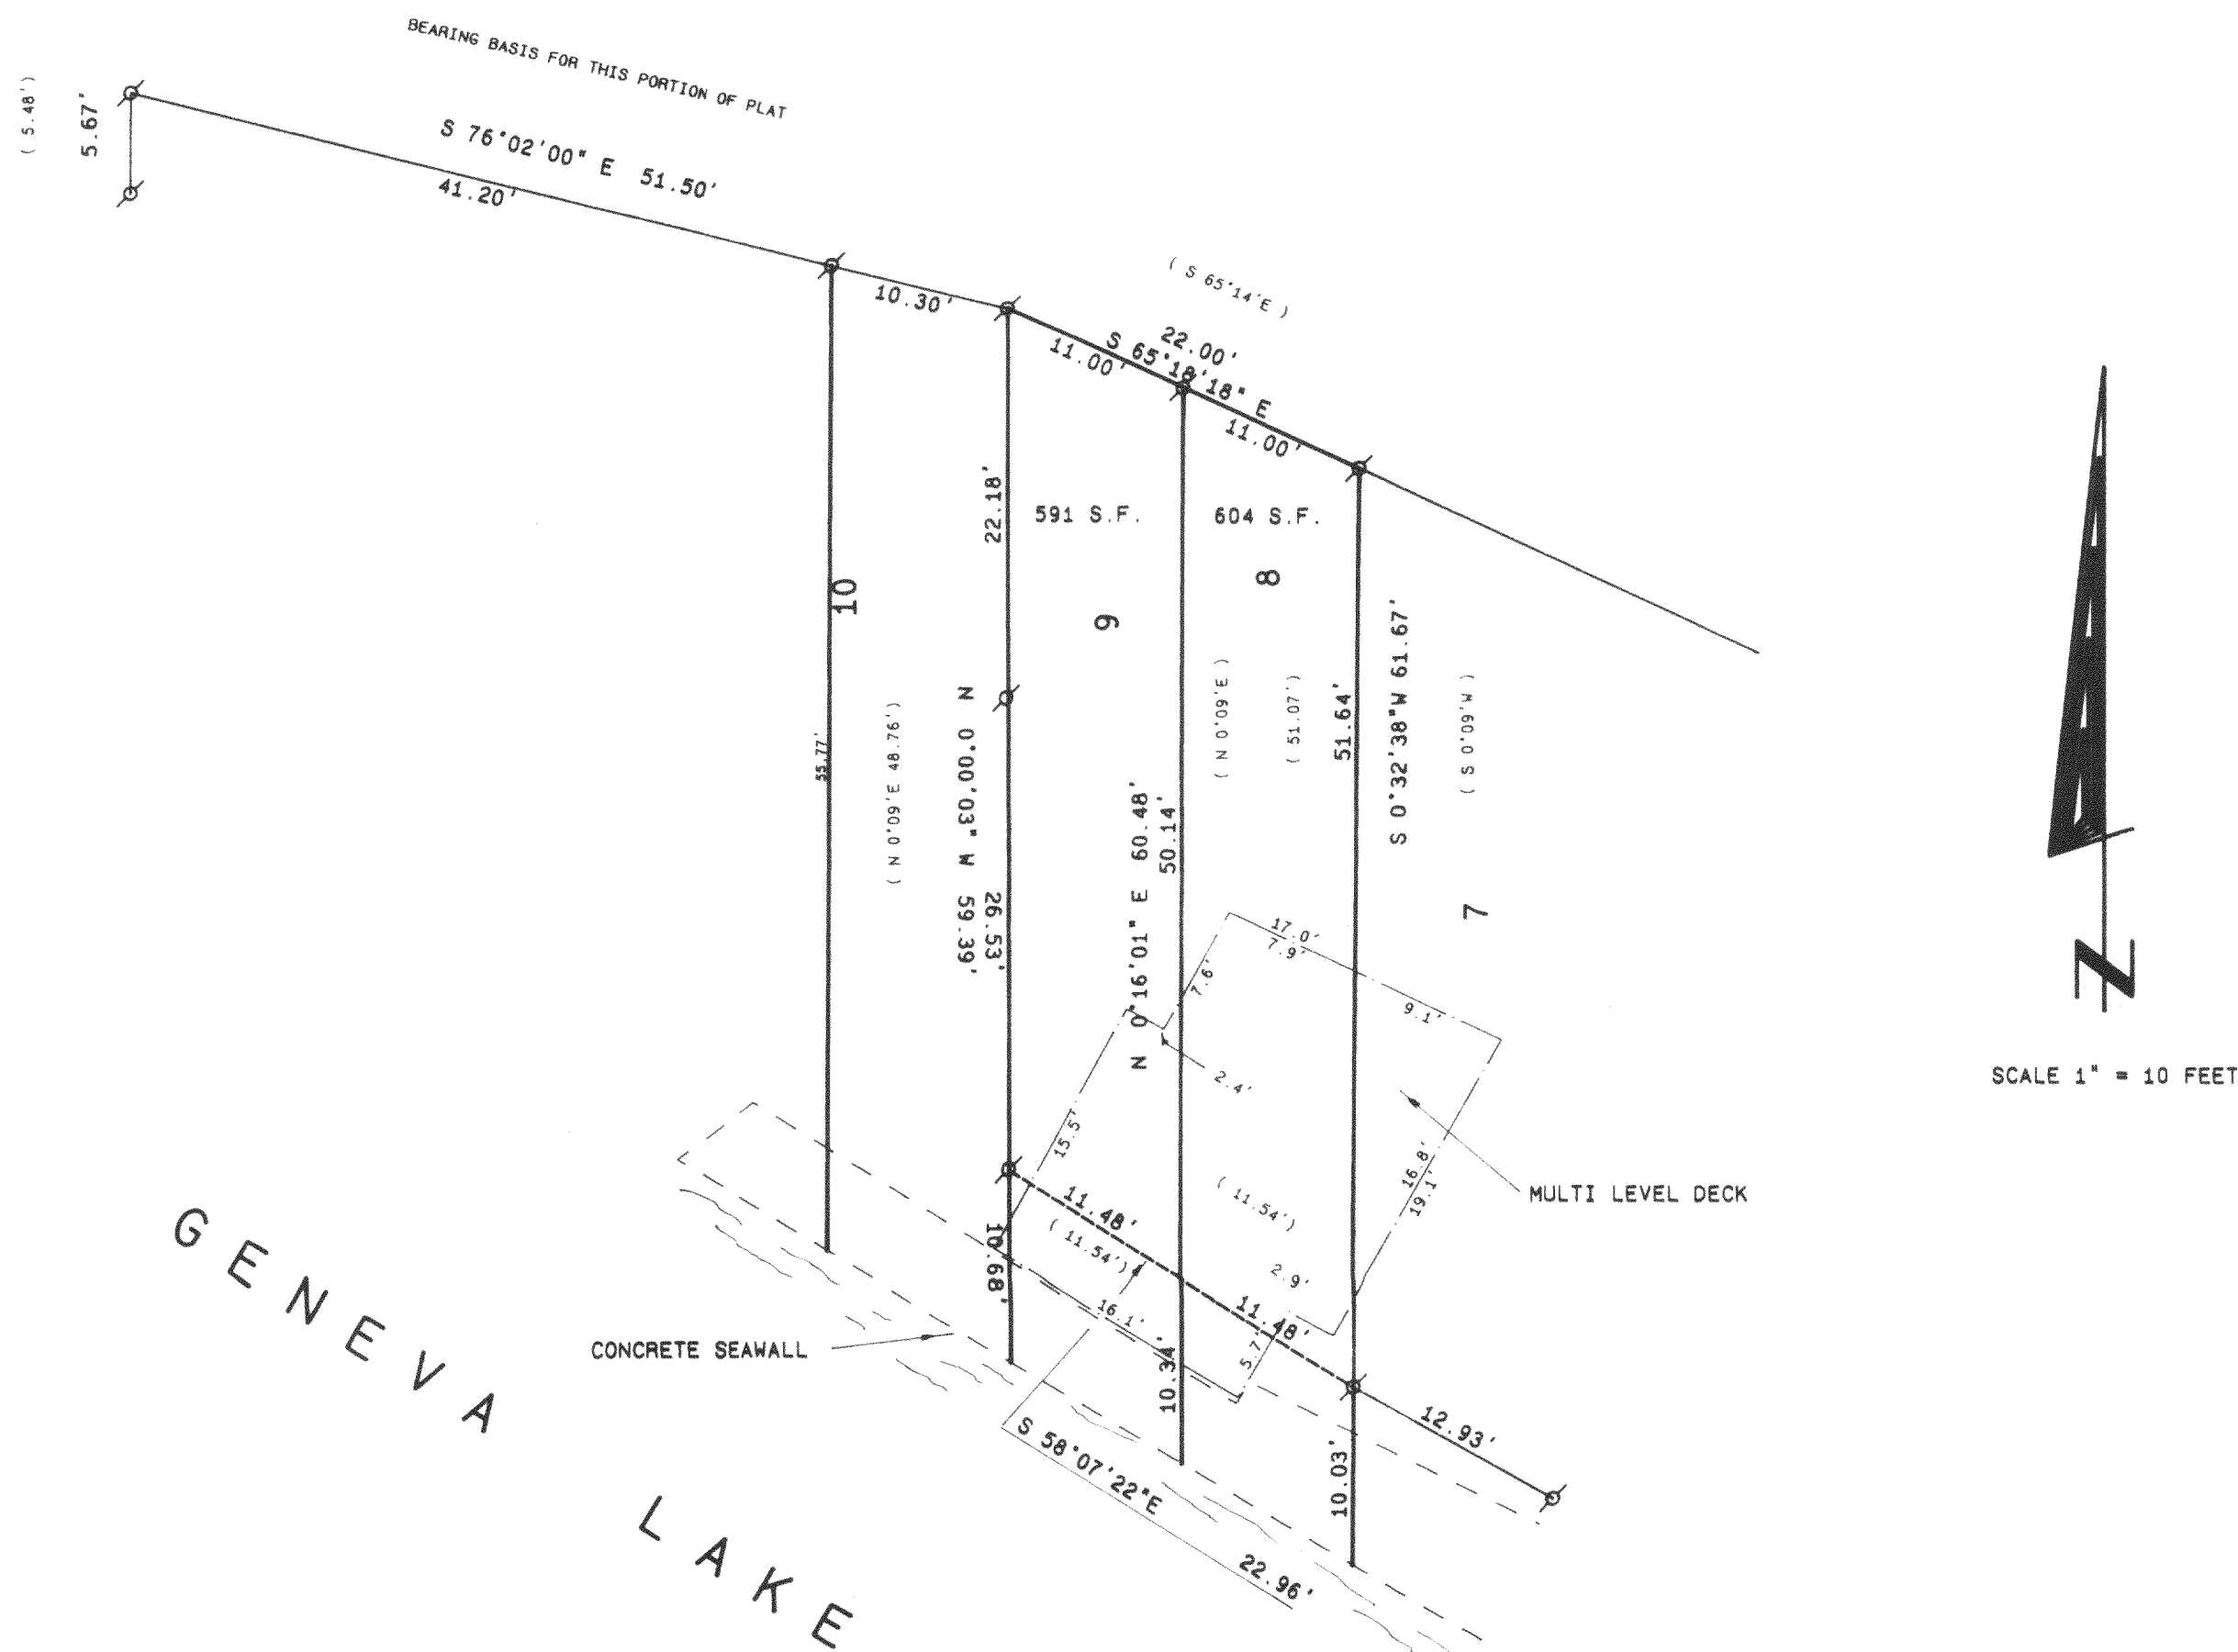

SCALE: 1"=40 FEET

Legend

- | | |
|---|---|
|  | FOUND IRON PIPE |
|  | FOUND BRASS CAPPED MONUMENT |
|  | FOUND CONCRETE MONUMENT |
|  | CHISEL CUT IN CONCRETE |
|  | SET IRON ROD, 24" LONG, WEIGHING
1.5 LBS., LINEAL FT., 3/4" DIA. |
|  | SET IRON ROD, 30" LONG, WEIGHING
4.5 LBS., LINEAL FT., 1 1/4" DIA. |
| (x) | RECORDED AS DIMENSION
EXISTING FENCE |

Kenneth B. Bernath
KENNETH B. ABERNATHY, JR.
WISCONSIN REGISTERED LAND SURVEYOR
S-1594
Date: *Feb. 7, 1997* Job No. *97-205*