



SOUTH SHORE DRIVE 49.5' WIDE

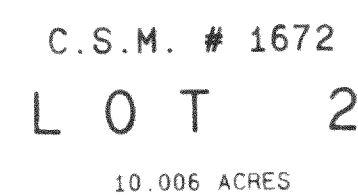

Ordered by: Engerman Contracting
W3411 County Highway BB
Lake Geneva, Wisconsin 53147

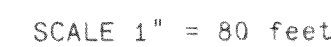


LINE	DISTANCE
L1	3.50
L2	3.97
L3	3.90
L4	4.00
L5	4.00


[illegible]

CENTERLINE DRIVEWAY
NOT COMPLETE

- ### Legend
- | | |
|---|--|
|  | FOUND IRON PIPE |
|  | FOUND IRON ROD |
|  | FOUND BRASS CAPPED MONUMENT |
|  | FOUND CONCRETE MONUMENT |
|  | CHISEL CUT IN CONCRETE |
|  | SET IRON ROD, 24" LONG, WEIGHING
1.5 LBS./LINEAL FT., 1-3/4" DIA. |
|  | SET IRON ROD, 30" LONG, WEIGHING
4.5 LBS./LINEAL FT., 1-11/16" DIA. |
|  | RECORDED AS DIMENSION |
|  | EXISTING FENCE |

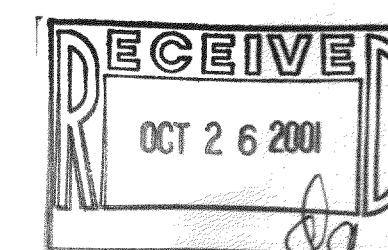

SCALE: 1" = 80 FEET

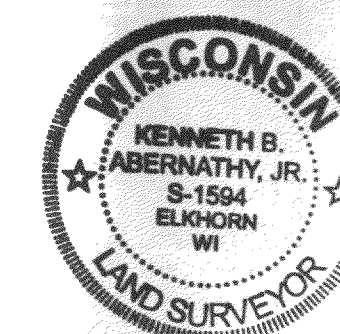

"I hereby certify that the above described property has been surveyed by me or under my direction and that the above map is a true representation thereof and shows the size and location of the property, its exterior boundaries, the location of all visible structures and dimensions of all principal buildings thereon, boundary fences, apparent easements, roadways and visible encroachments, if any."

within one year from date hereof.

Kenneth B. Abernathy

KENNETH B. ABERNATHY, JR.
WISCONSIN REGISTERED LAND SURVEYOR
S-1594
Date: SEPT. 21, 2001 Job No. 99.910