


PLAT OF SURVEY

OF

LOTS 85, 88, AND 89 OF LAKE GENEVA BEACH SUBDIVISION,
LOCATED IN THE SW 1/4 OF SECTION 11, T1N R17E, WALWORTH
COUNTY, WISCONSIN

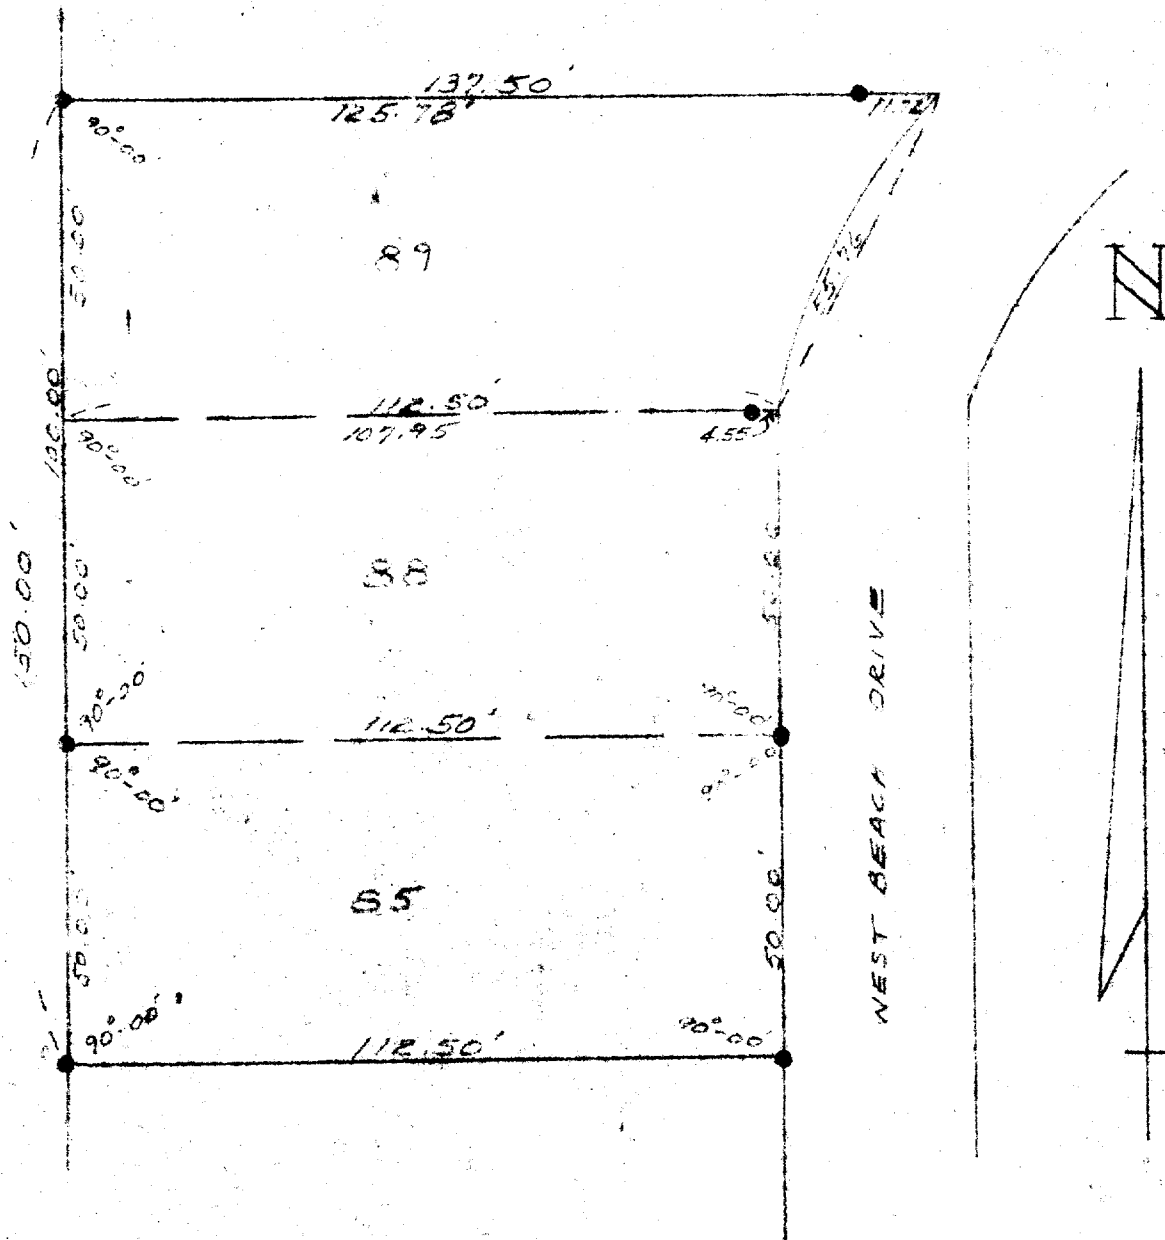

SURVEY AND PLAT BY

JENSEN & JOHNSON
CIVIL ENGINEERS AND SURVEYORS

Elkhorn, Wisconsin

LEGEND

- — Iron Pipe
 - — Concrete Monument
- Scale 1" = 30'

WE CERTIFY: That we have surveyed the above described property and that the plat shown herein is an accurate survey and a true representation thereof and correctly shows the exterior boundary lines and all divisions of said property.

Date August 1964

Lloyd L. Jensen
LLOYD L. JENSEN, Partner

Wisconsin Registered Land Surveyor, No. S-211

ILGB-77
" 80