


PLAT OF SURVEY

OF

LOTS 21, 22, 23 EDGEWATER TERRACE
SUBDIVISION LOCATED IN SECTION 8 & 9
T1N. R17E, WALWORTH COUNTY, WISCONSIN.

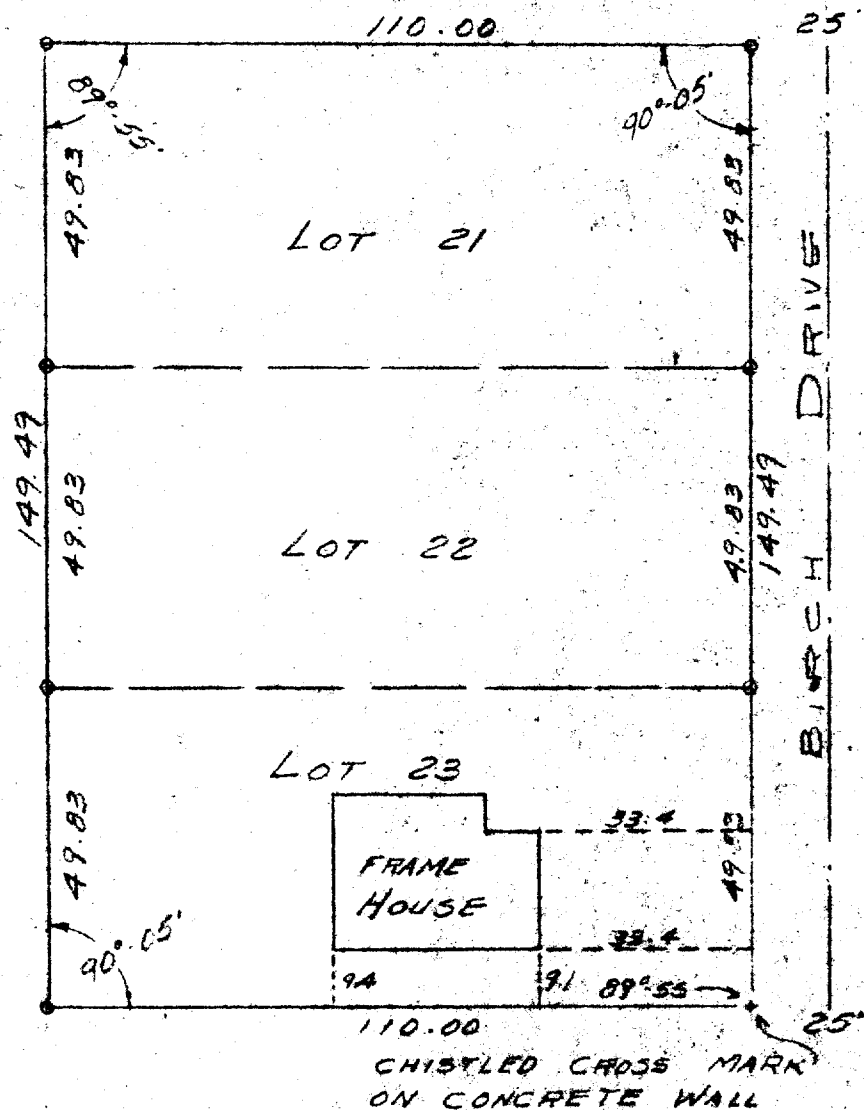

SURVEY AND PLAT BY

JENSEN & JOHNSON
CIVIL ENGINEERS AND SURVEYORS

Madison, Wisconsin

LEGEND

- — Iron Pipe
 - — Concrete Monument
- Scale 1" = 30'

WE CERTIFY: That we have surveyed the above described property and that the plat shown herein is an accurate survey and a true representation thereof and correctly shows the exterior boundary lines and all divisions of said property.

Date APRIL 20, 1964

Lloyd E. Jensen
LLOYD E. JENSEN, Partner

Wisconsin Registered Land Surveyor, No. S-211

IE-18, 19, 20

117-209.1

117-2091