
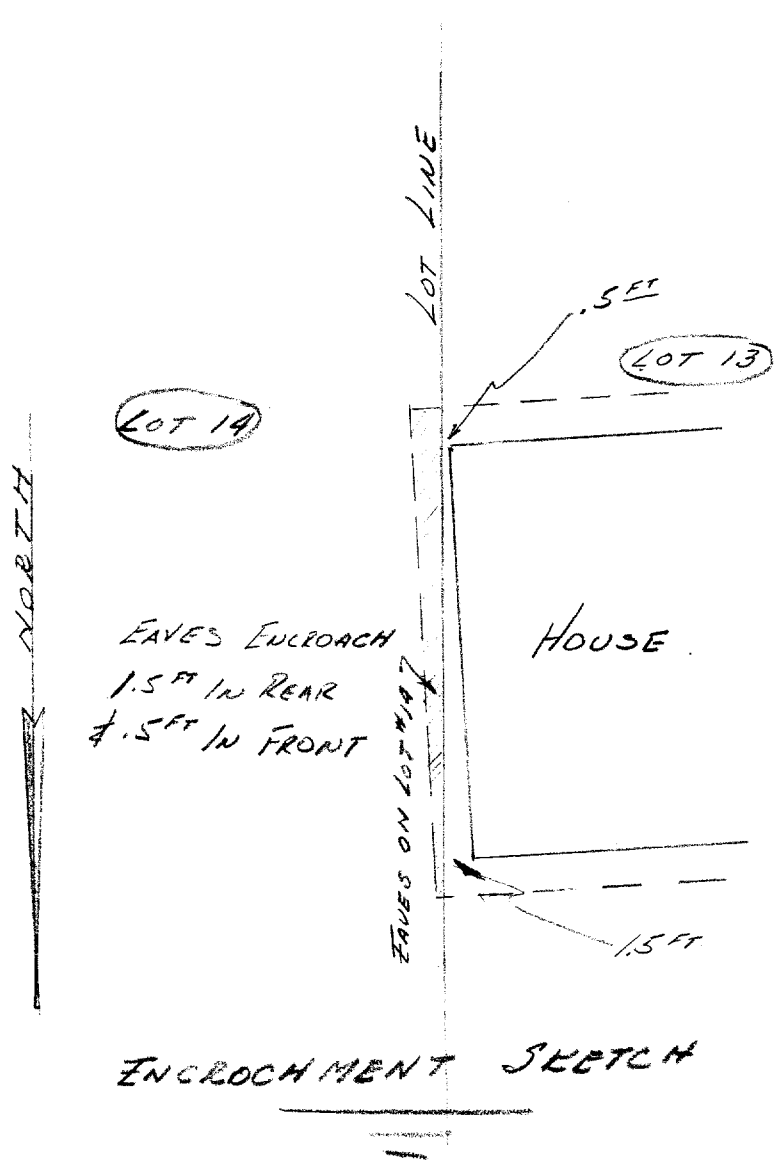


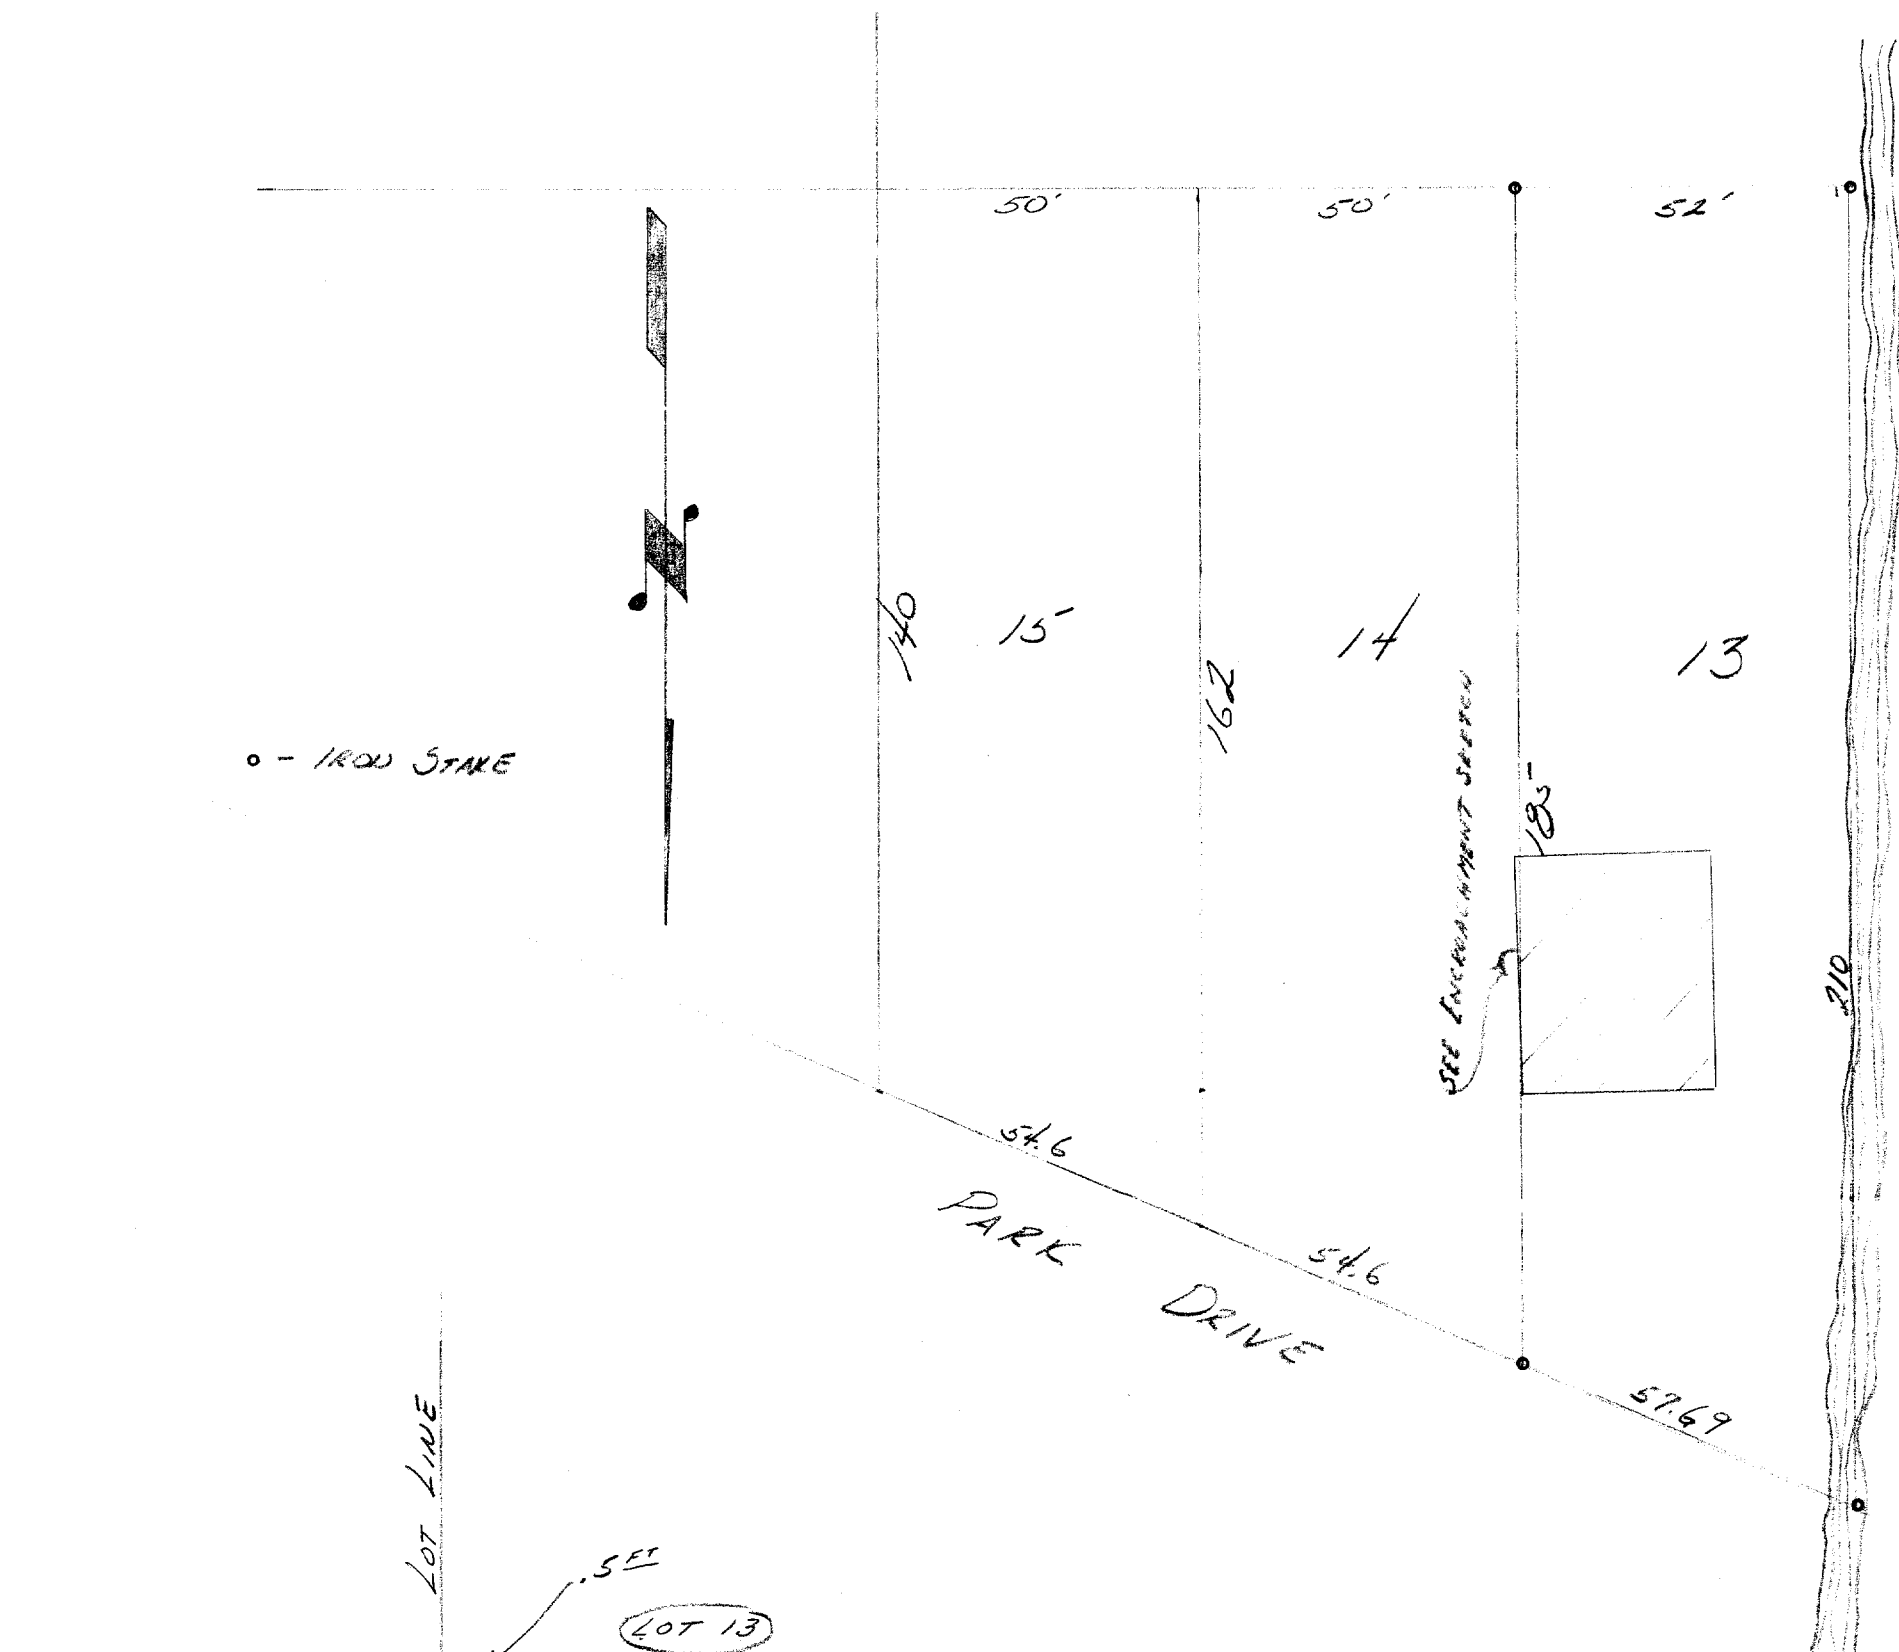

DESCRIPTION: Lot 13 of Lake Geneva Beach Subdivision of a portion of Sections 11 and 14, Town 1, north, Range 17 east of the 4th Principal Meridian, Walworth County, Wisconsin.

CERTIFICATE: I hereby certify that I have on this the 14th day of October 1955, surveyed the above described property according to the records on file in the office of the Recorder of Deeds in and for Walworth County, Wisconsin, and find that the measurements and bearings of the boundary lines of said property as taken at the site on this day substantially agree with said record, and that an encroachment by the house on Lot 13, across the west line of Lot 14, exists as shown on plat here portrayed.

SIGNED AND SEALED ON THIS THE 15TH DAY OF OCTOBER 1955.

Joseph M. Blagi, Professional Engineer.
Elkhorn Wisconsin.