

ABERNATHY and ASSOCIATES

Kenneth B. Abernathy Jr.



Wisconsin Registered Land Surveyor S-1594

W4056 BRAY RD.
ELKHORN, WI. 53121
PHONE: (262) 723-4260 (OFFICE)
(262) 723-7209 (FAX)
Email: abernathy@elknet.net

PLAT OF SURVEY

LOT 1, LAKE GENEVA BEACH
SUBDIVISION, LOCATED IN SECTION
11, TOWN 1 NORTH, RANGE 17 EAST,
LINN TOWNSHIP, WALWORTH COUNTY,
WISCONSIN.

OWNERS: ERIC & JANET KNAUER TRUST
ERIC & JANET KNAUER, TRUSTEES
W3236 PARK DRIVE
LAKE GENEVA, WI 53147

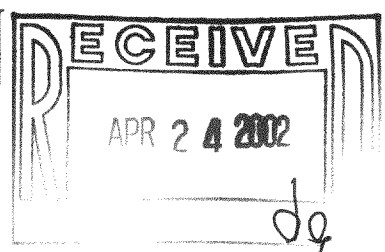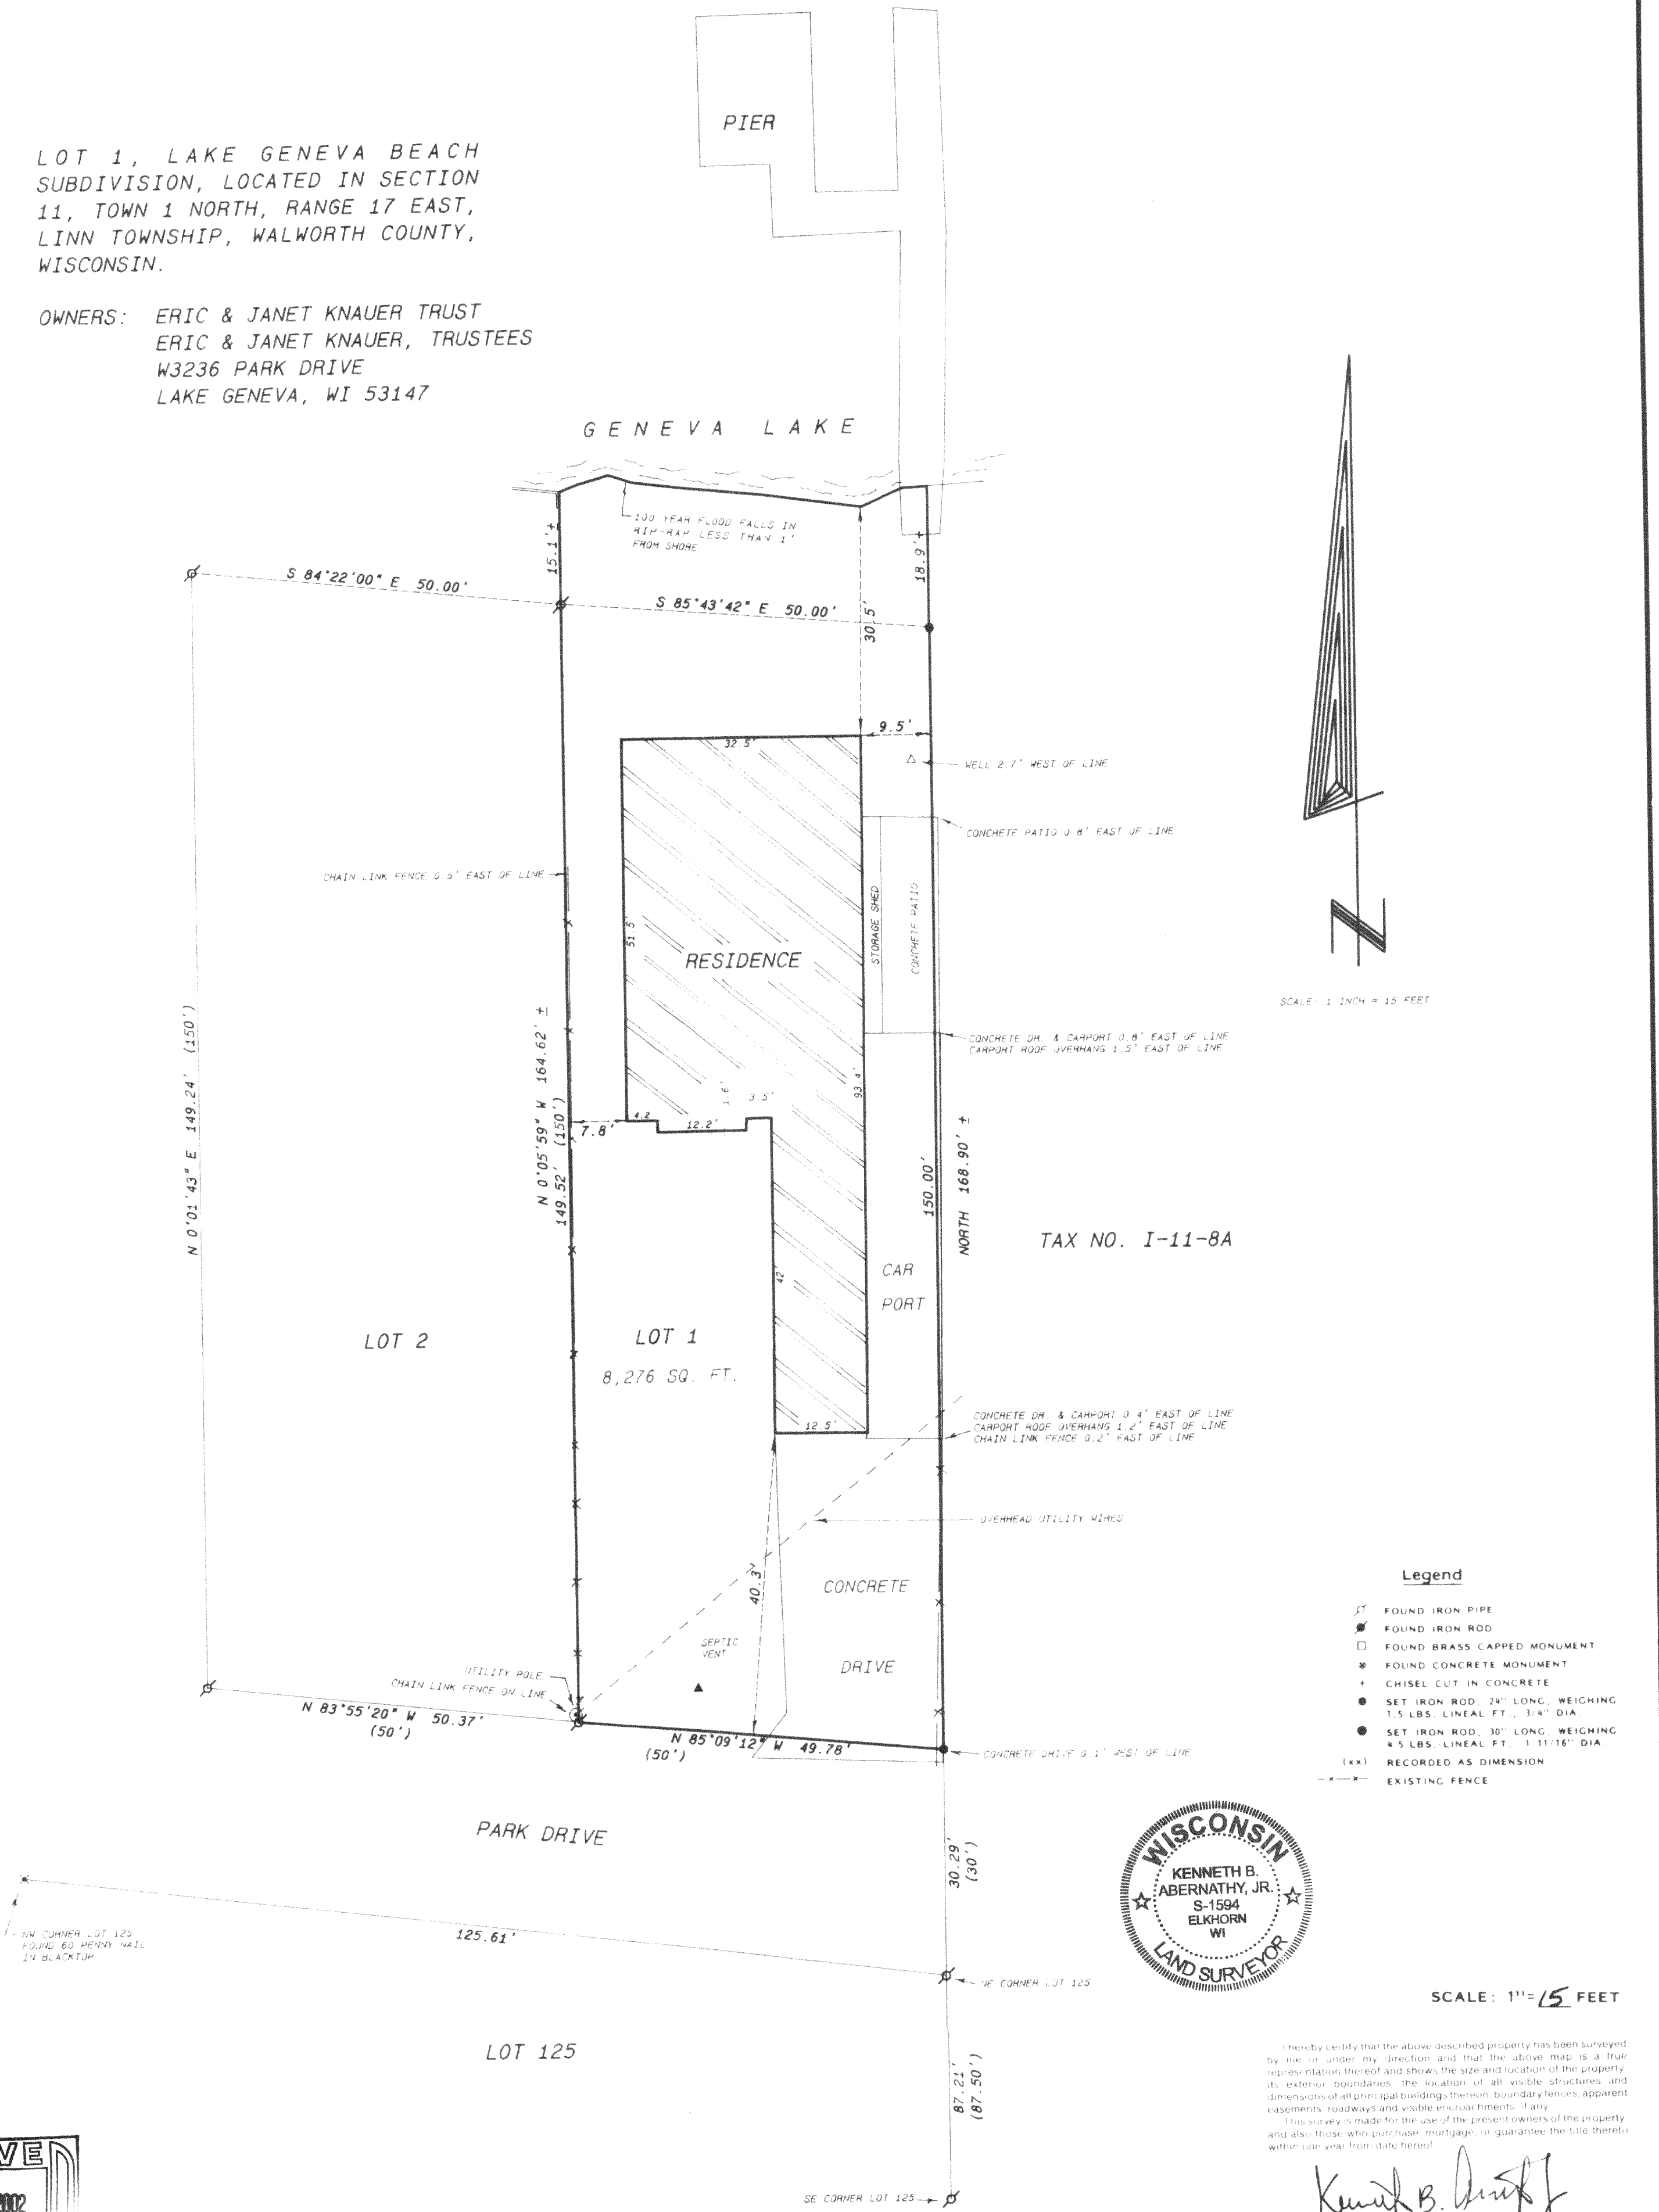

117-2118
ILGB-1